

6514

26.15  
70.50  
96.65  
97-05

Kenneth E Crawford Divol 625 Pg 299


6-131

6-132 S 89°-01' W

1862.32

06-24-005-000-037

16.32 Acres

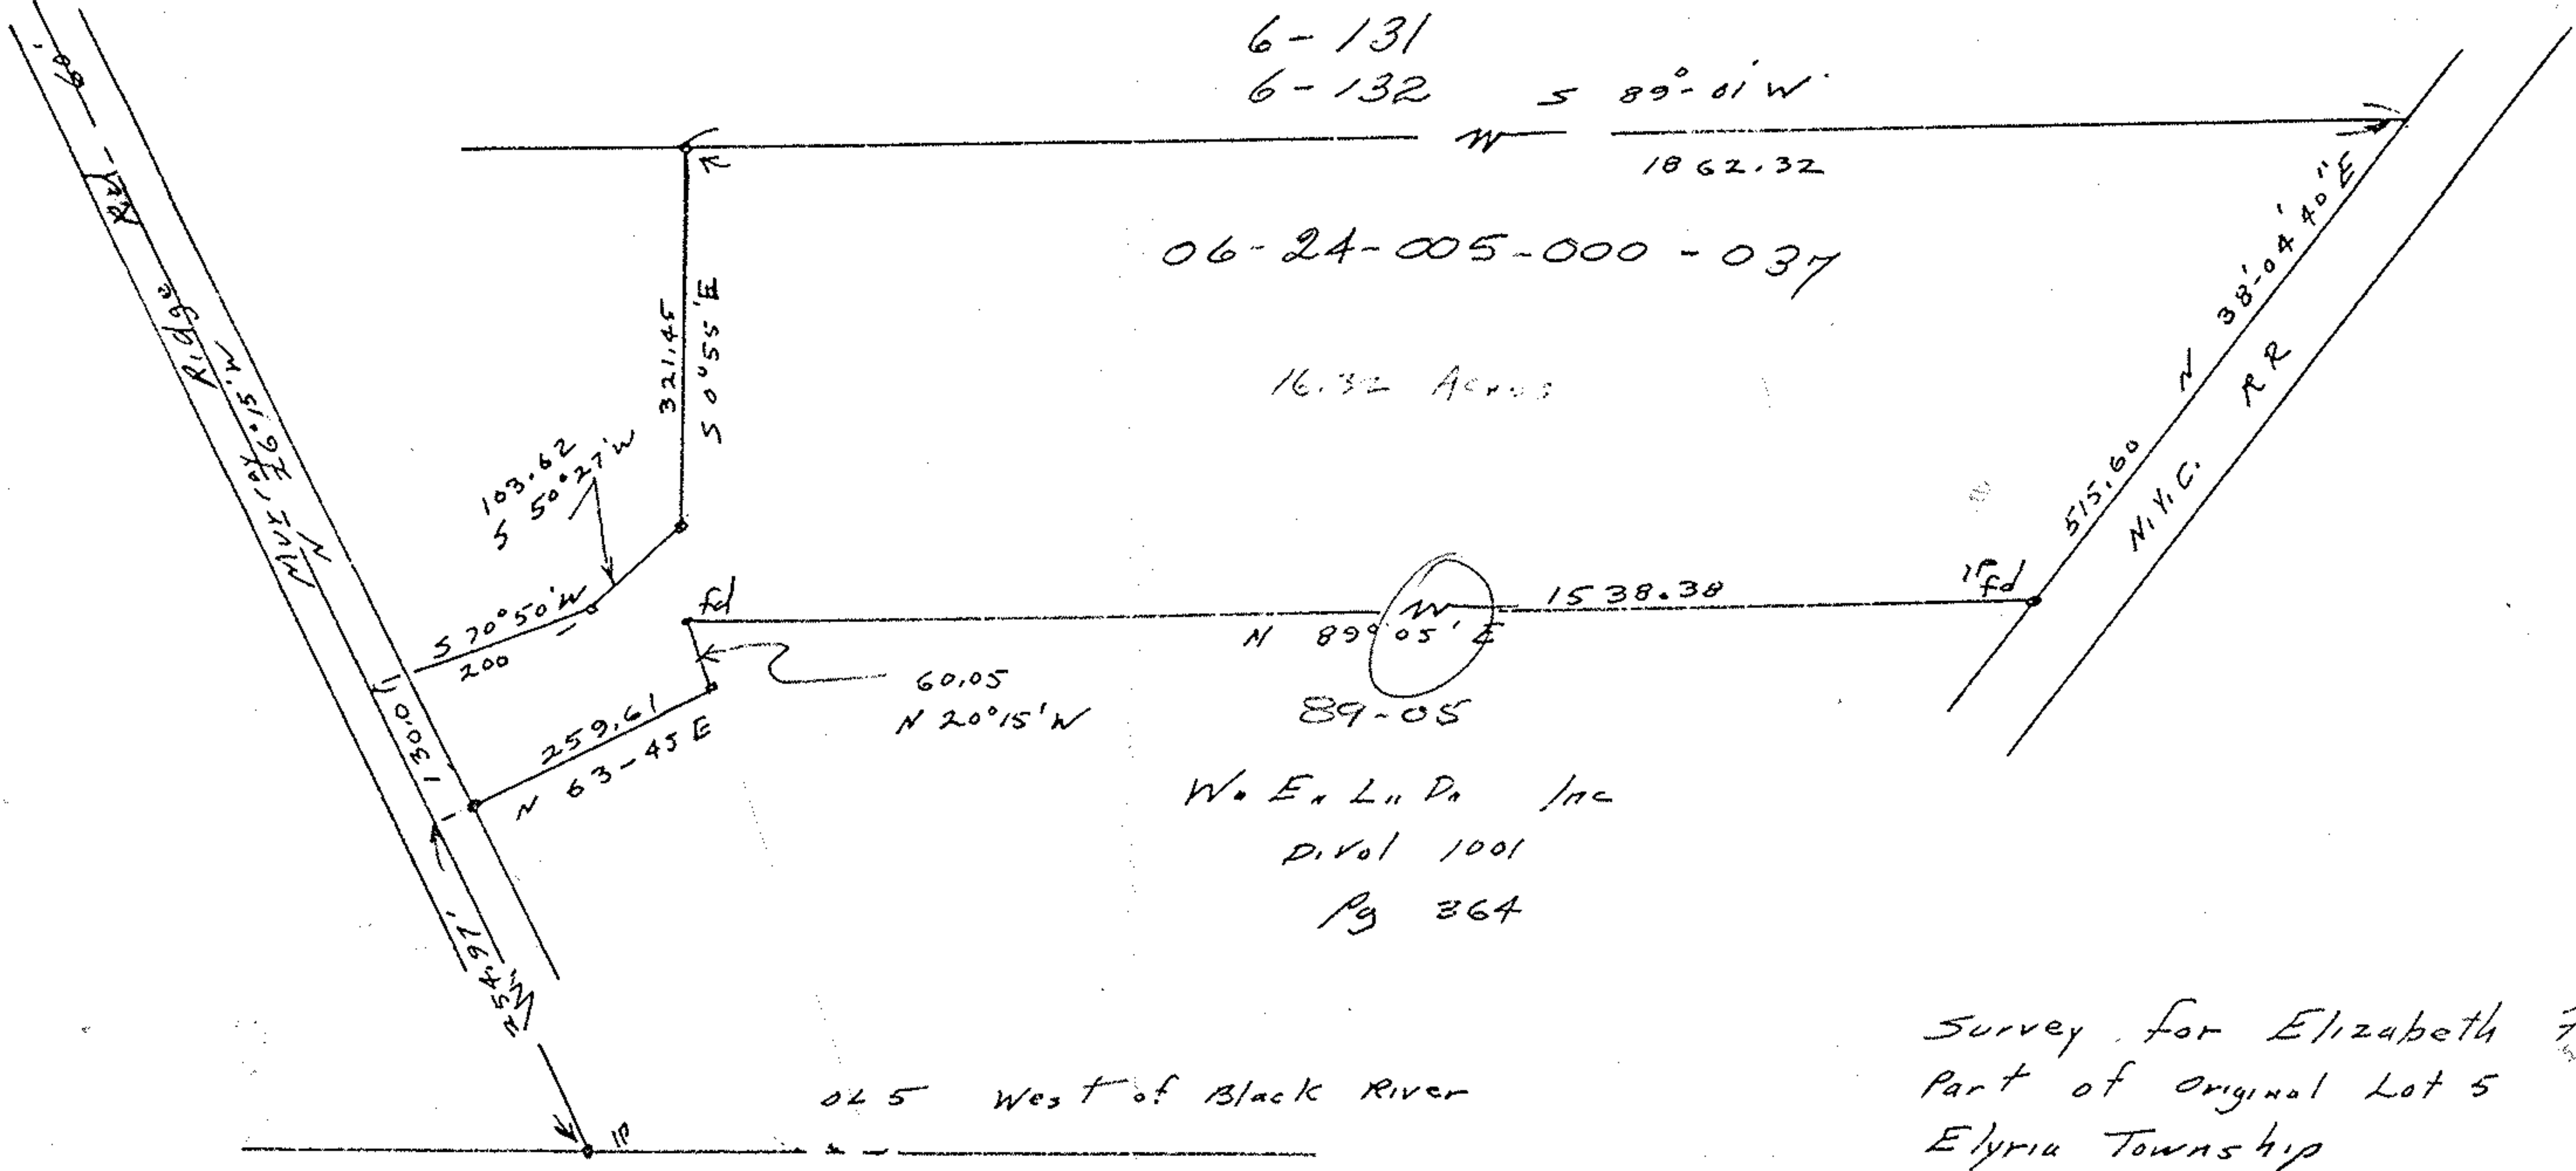

W. E. L. D. Inc  
Divol 1001  
Pg 364

045 West of Black River

046

Survey for Elizabeth Feron  
Part of original Lot 5  
Elyria Township  
Lorain County, Ohio  
Scale NTS Oct 1, 1972

John Poyzwal  
Reg Surveyor  
#5292

06-24-005-000-037

pg 6-131

pg 6-132

Vol. 6514