


06-24-005-000-041

2000 SURVEYING TABLE

06-24-005-000-

00408#

6-130131

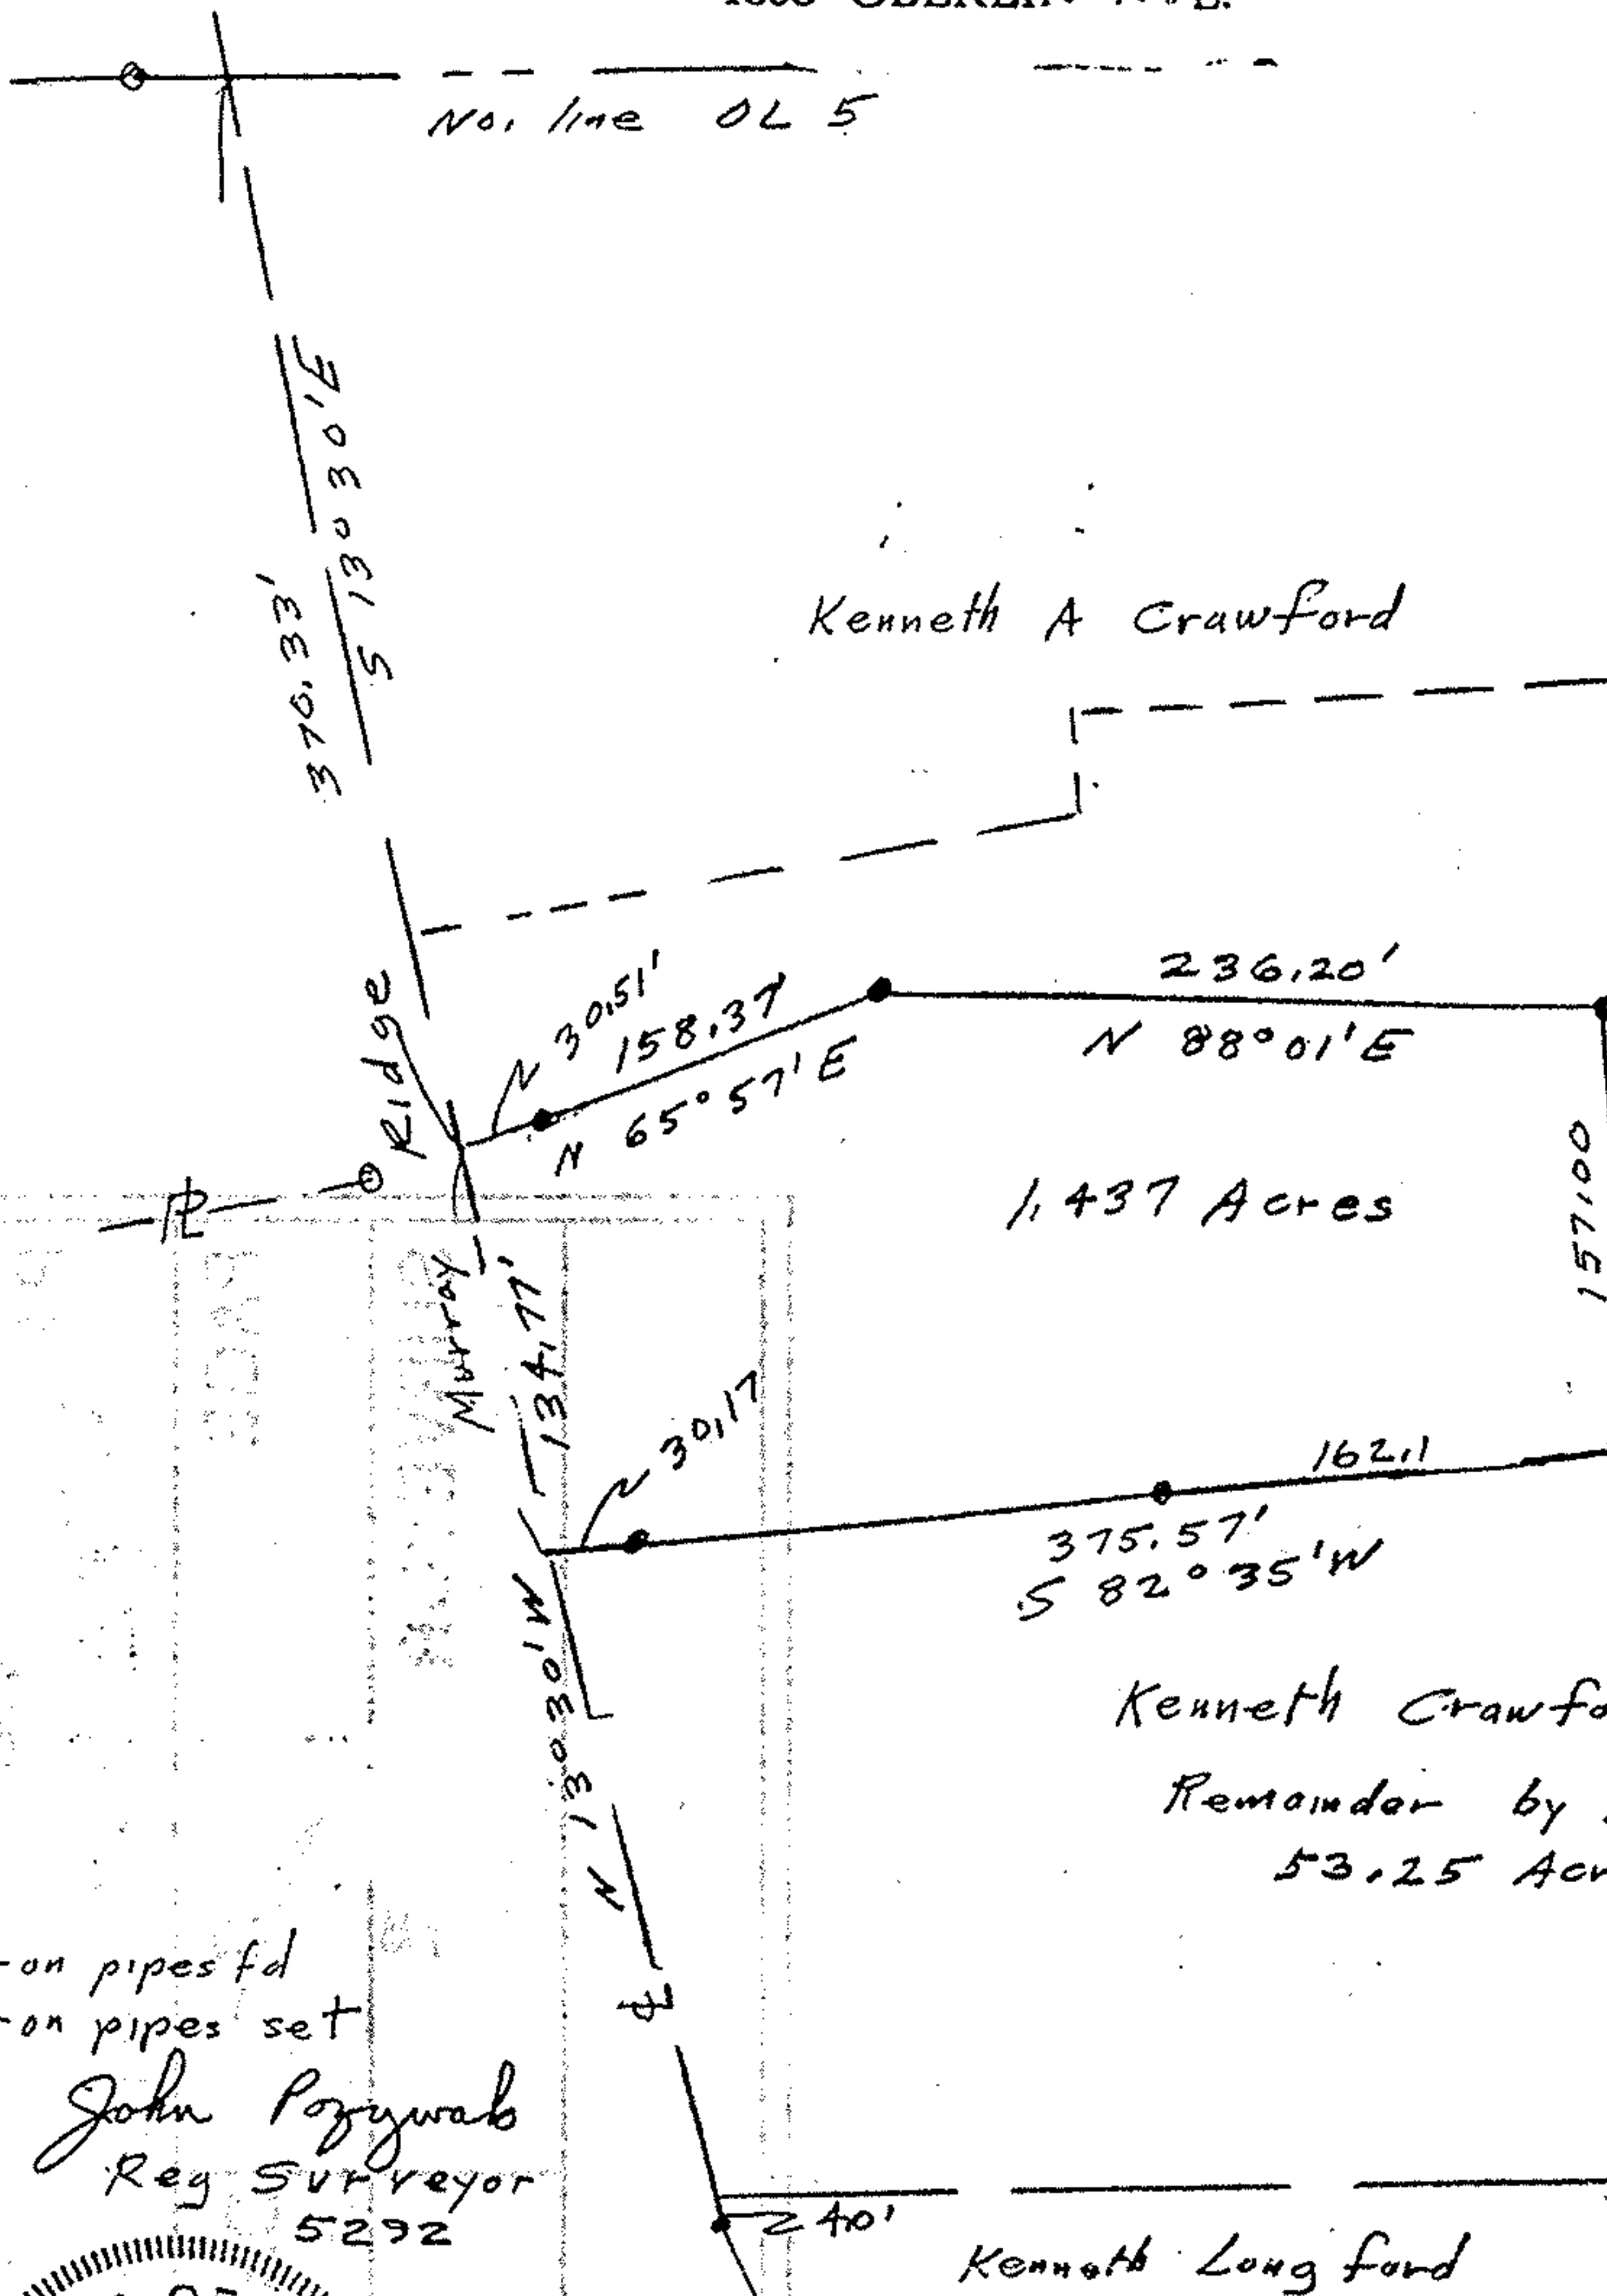

Kenneth A Crawford

1.437 Acres


Kenneth Crawford

Remainder by Auditor
53.25 Acres

Kenneth Longford

- o iron pipes fd
- o iron pipes set

John Pozywak
Reg Surveyor
5292

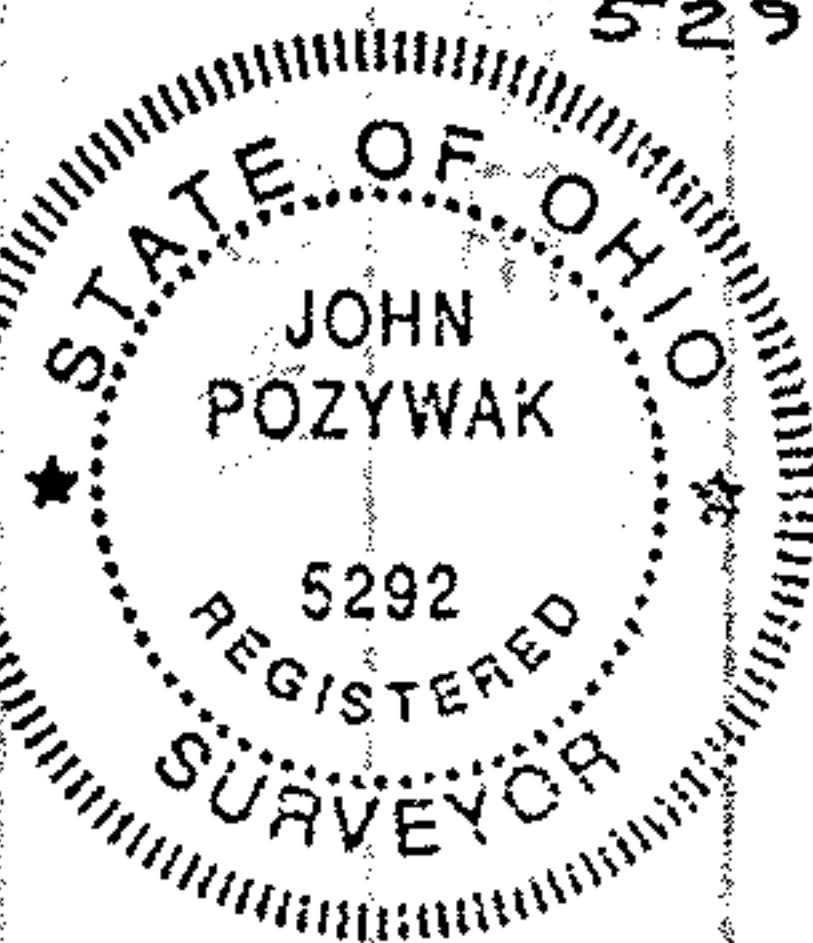

5-18-94
20860
VOID 20403
APPROVED
LORAIN CO.
MAP DEPT.
DATE 6-30-93
PAGE 6-130, 131
BY CAROLYN FRANCIS
VOID AFTER # 20409

ORIGINAL LOT 5 West of BR DATE Apr 30, 1993
 TOWNSHIP Elyria SCALE 1"=100'
 CITY OF _____ FIELD BOOK N/A
 COUNTY OF Lorain DRAWN BY J.Poz
 STATE OF OHIO CHECKED BY _____
 W. O. _____ FILE NO. 06-24-004