

# KLEINODER-SCHMIDT and ASSOCIATES


ENGINEERS — SURVEYORS — CONSULTANTS IN LAND PLANNING  
ELYRIA · NORWALK · MEDINA OHIO

# SURVEY

Sublot(s) 9 & 10  
Subd'n GULF FARMS ADDN.

Tract LAST OF THE RIVER  
Sec. \_\_\_\_\_  
State of Ohio

Township ELYRIA  
Orig. Lots) 162, 161  
County of ELYRIA  
Corporation \_\_\_\_\_

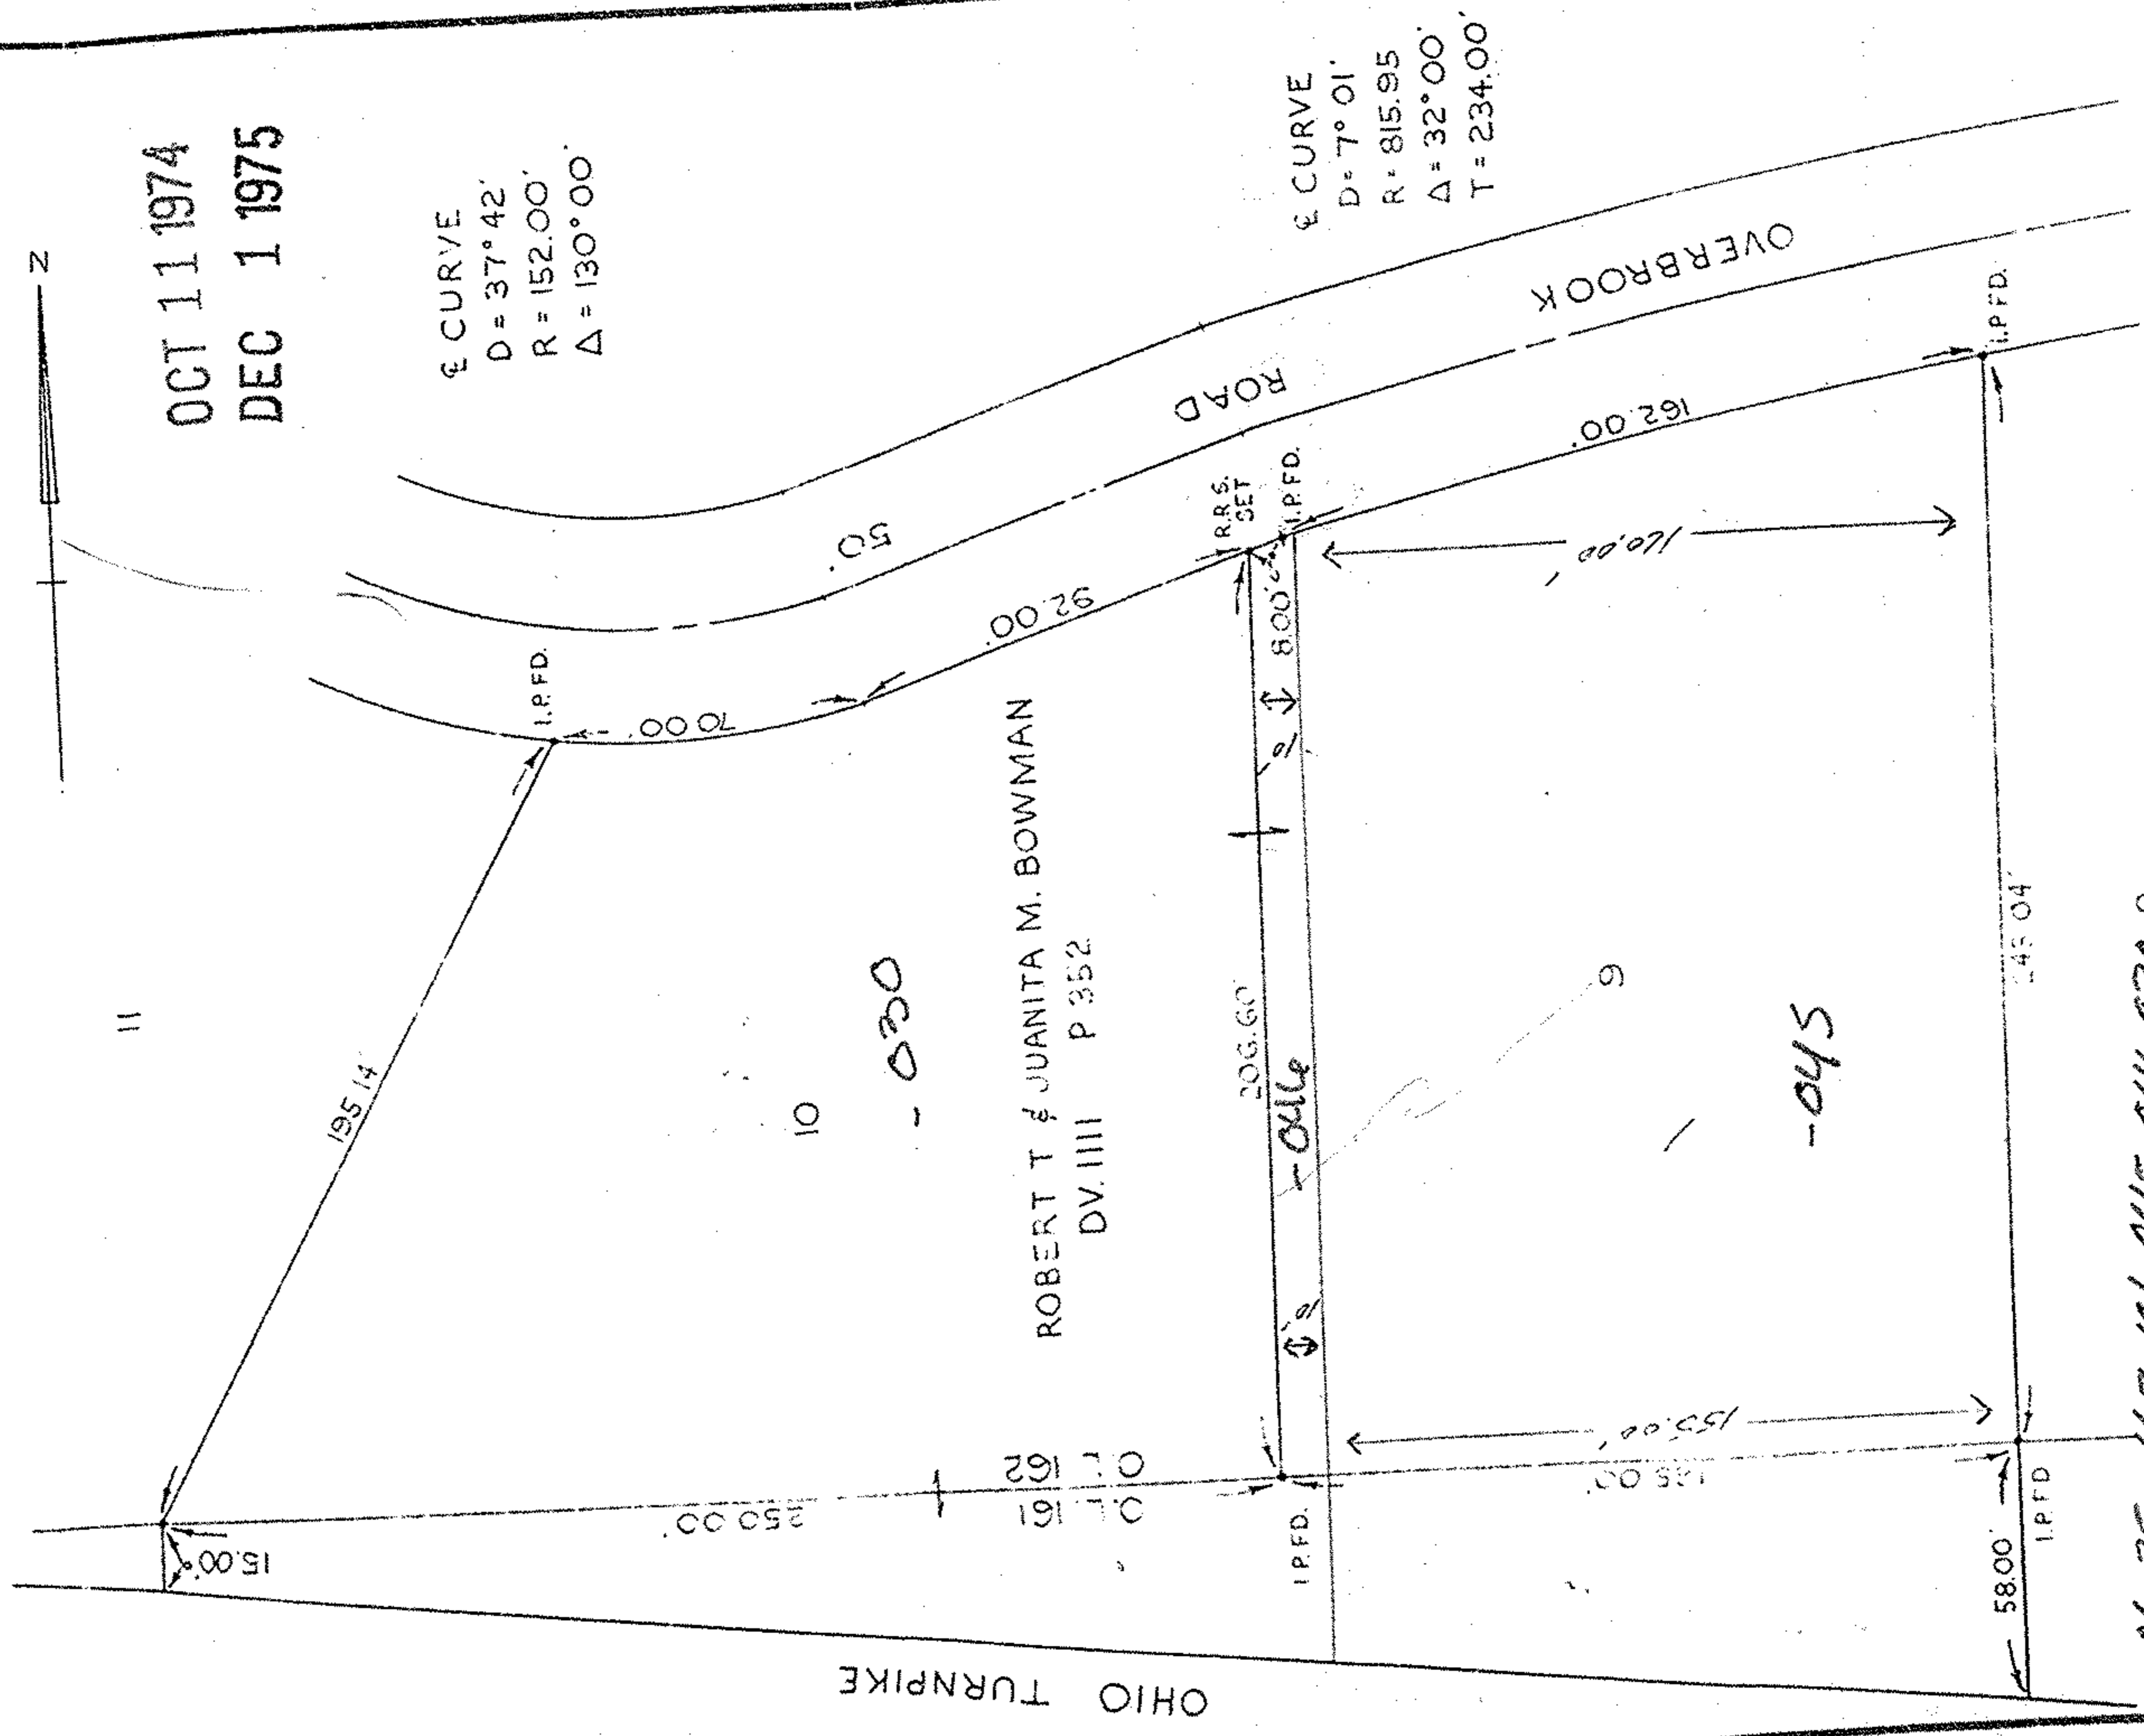

*06-25-162-101-045, 046, 030 8*

Prepared for: ROBERT T. BOWMAN

Scale: 1" = 50'

Date: 9-9-74

Dr. by: \_\_\_\_\_

Job No 74-238