

KLEINOEDER · SCHMIDT and ASSOCIATES

ENGINEERS — SURVEYORS — CONSULTANTS IN LAND PLANNING
ELYRIA · NORWALK · MEDINA OHIO

SURVEY

Sublot(s) 5 & 6, SECTION A

Subd'n GULF FARMS ALLOT.

P.V. 10 P. 24

Tract EAST OF THE RIVER

Sec. _____

State of Ohio

Township ELYRIA

Orig. Lots) 161 & 162


County of LORAIN

Corporation ELYRIA

67-67
6-85
06-25-161-000
162-101

46-25-162-101-035, 034, 036

SL 7

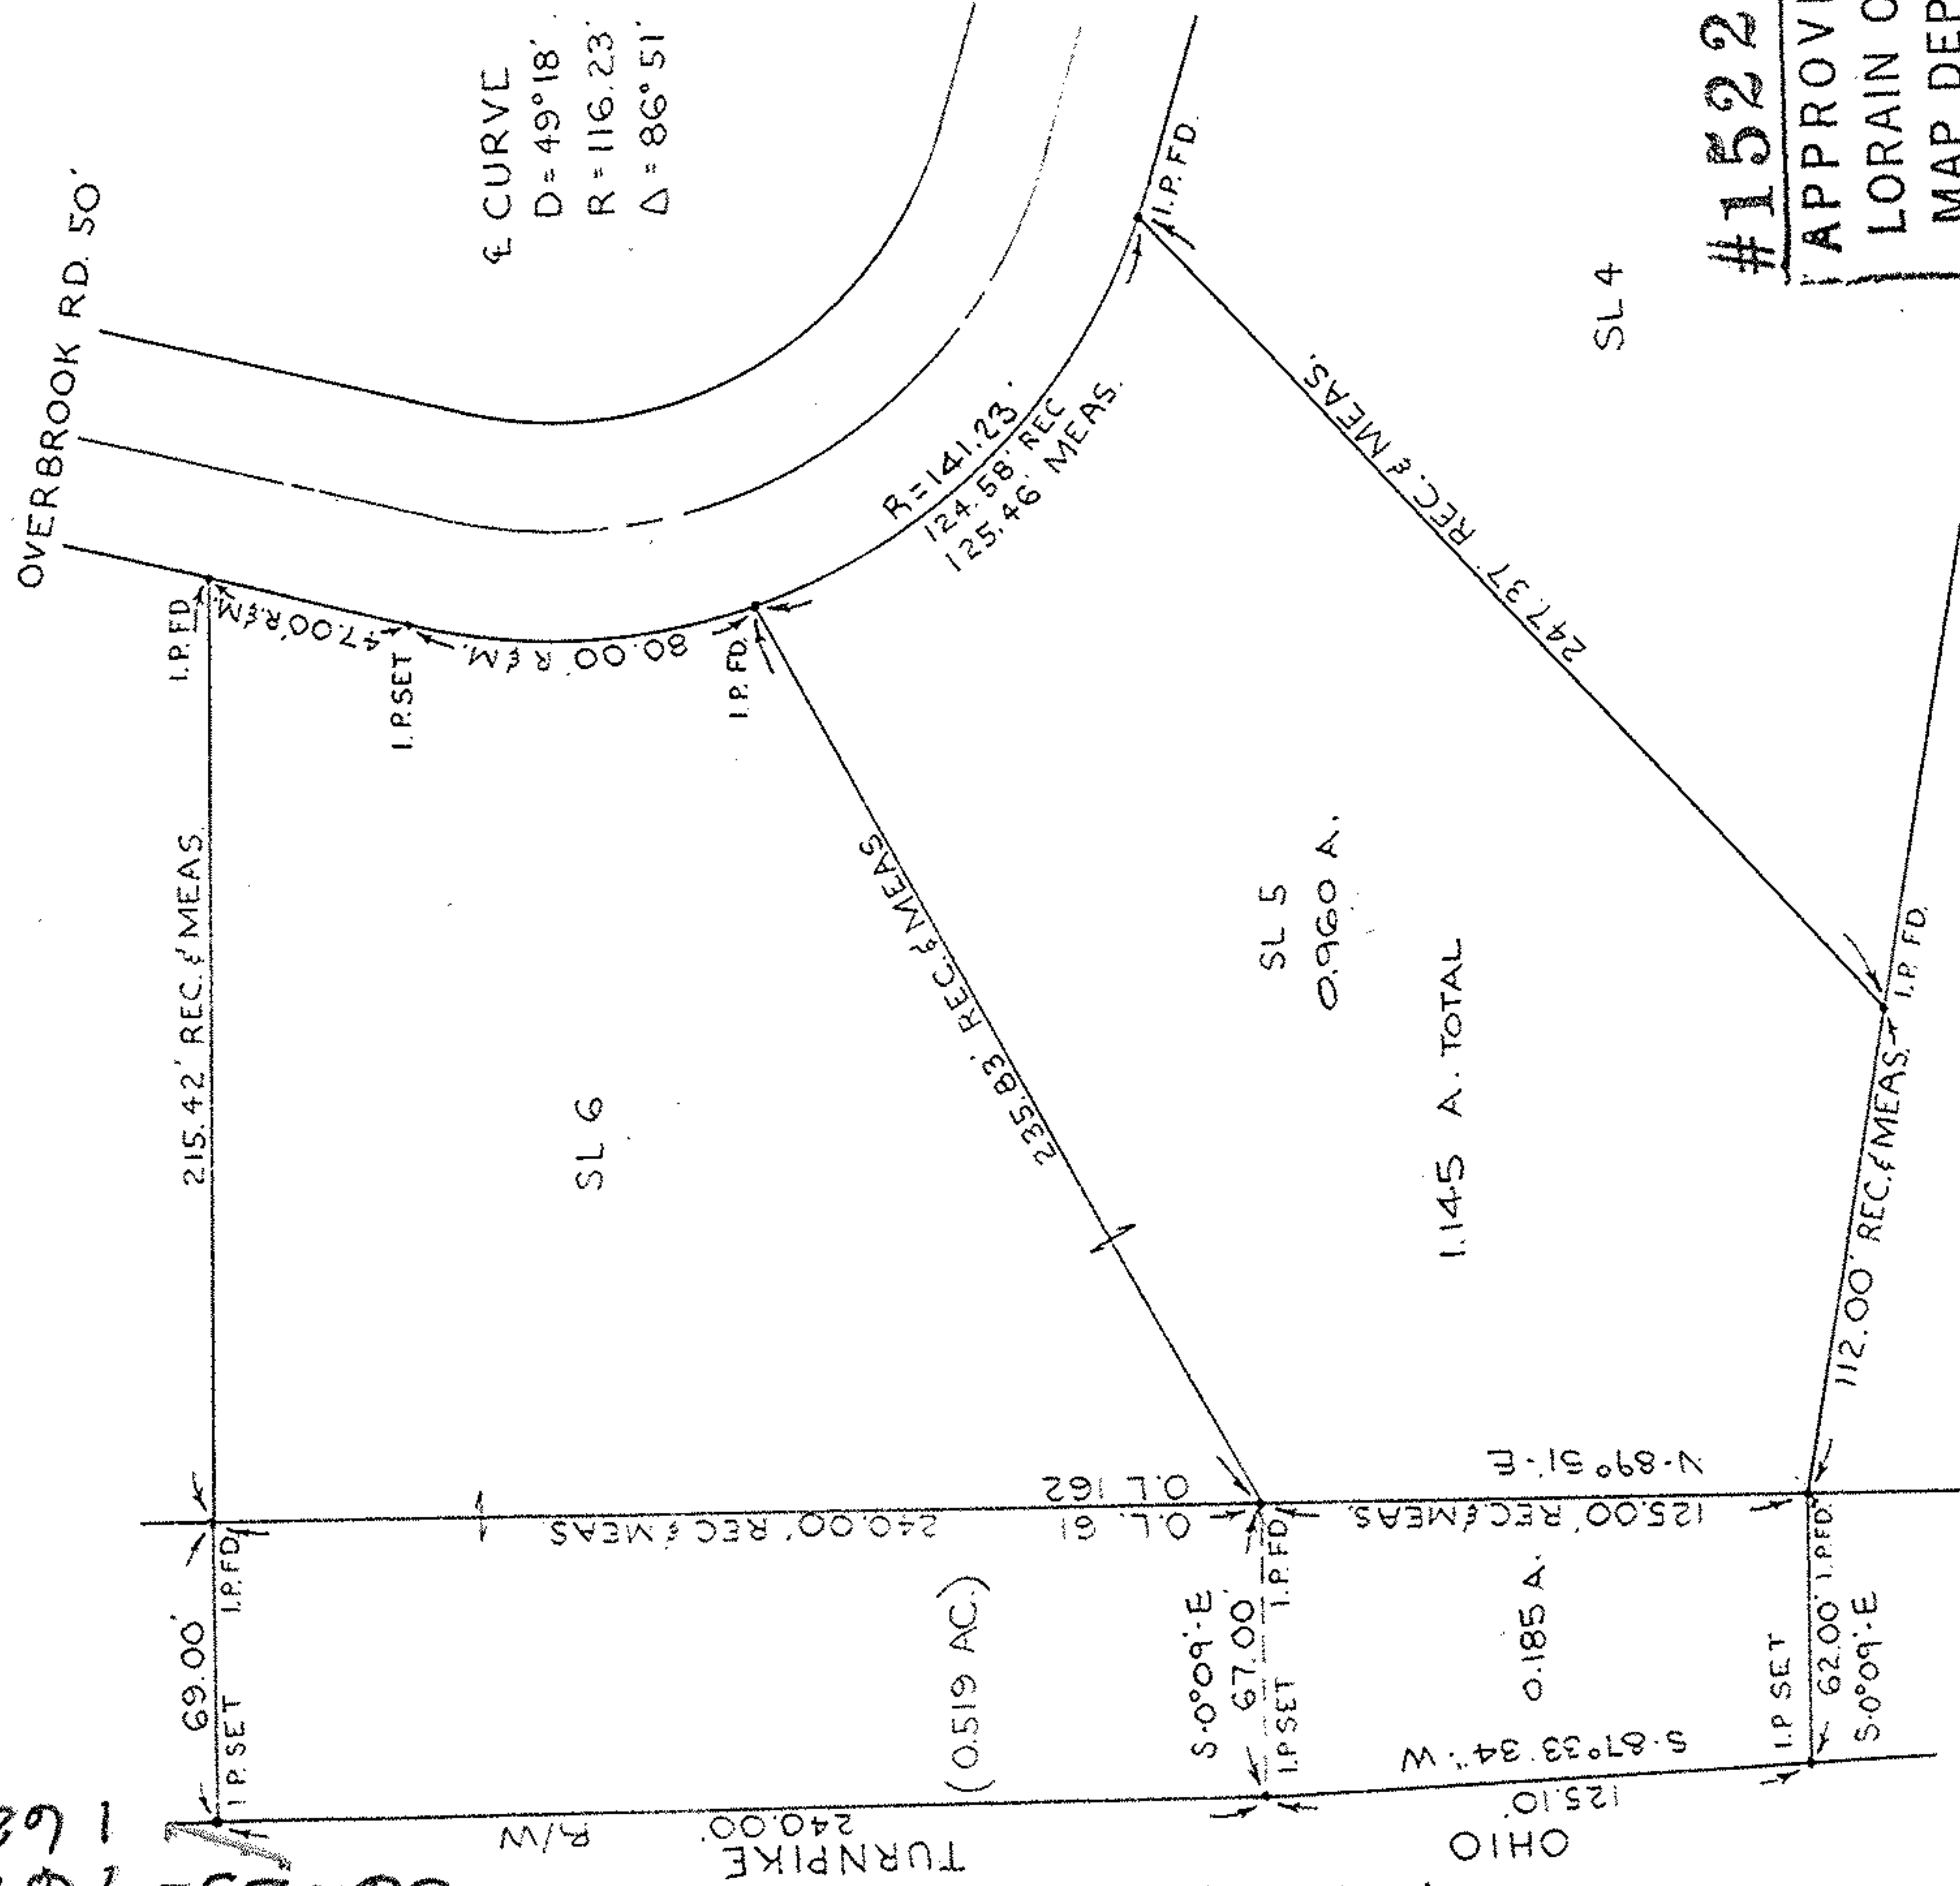

#15224

APPROVED
LORAIN CO.
MAP DEPT.

DATE 8-25-83

PAGE 6-67 & 6-85

BY T.M. Mair

VOID AFTER _____



Prepared for:

HARVEY C. HATFIELD

Scale: 1" = 60'

Date: NOV. 27, 1974

Dr. by: DLH

Job No 74-290

REVISED 8-12-83