



LAUNDON • SIMON • CAHL & ASSOC. INC.
CONSULTING ENGINEERS & SURVEYORS
ELYRIA, OHIO 44035


SURVEY OF SPLIT - 5/2'S 59 & 60
SPRING VALLEY ESTATES PLAT VOL. 19 PG. 2

FOR: MARGARET KAHLIFF

Orig. Lot 173	City of ELYRIA	Date 10-2-84 Scale 1"=40'
Orig. Sec	Village of	Dwn. by R.G.S Chkd. by J.C.
Tract EAST of RIVER	County of LORAIN	Job No. 84-1326 F.B. No
Township of ELYRIA	State of OHIO	Printed OCT 2 1984

CRESTVIEW DRIVE 60'

5.88°-47'-30"E.

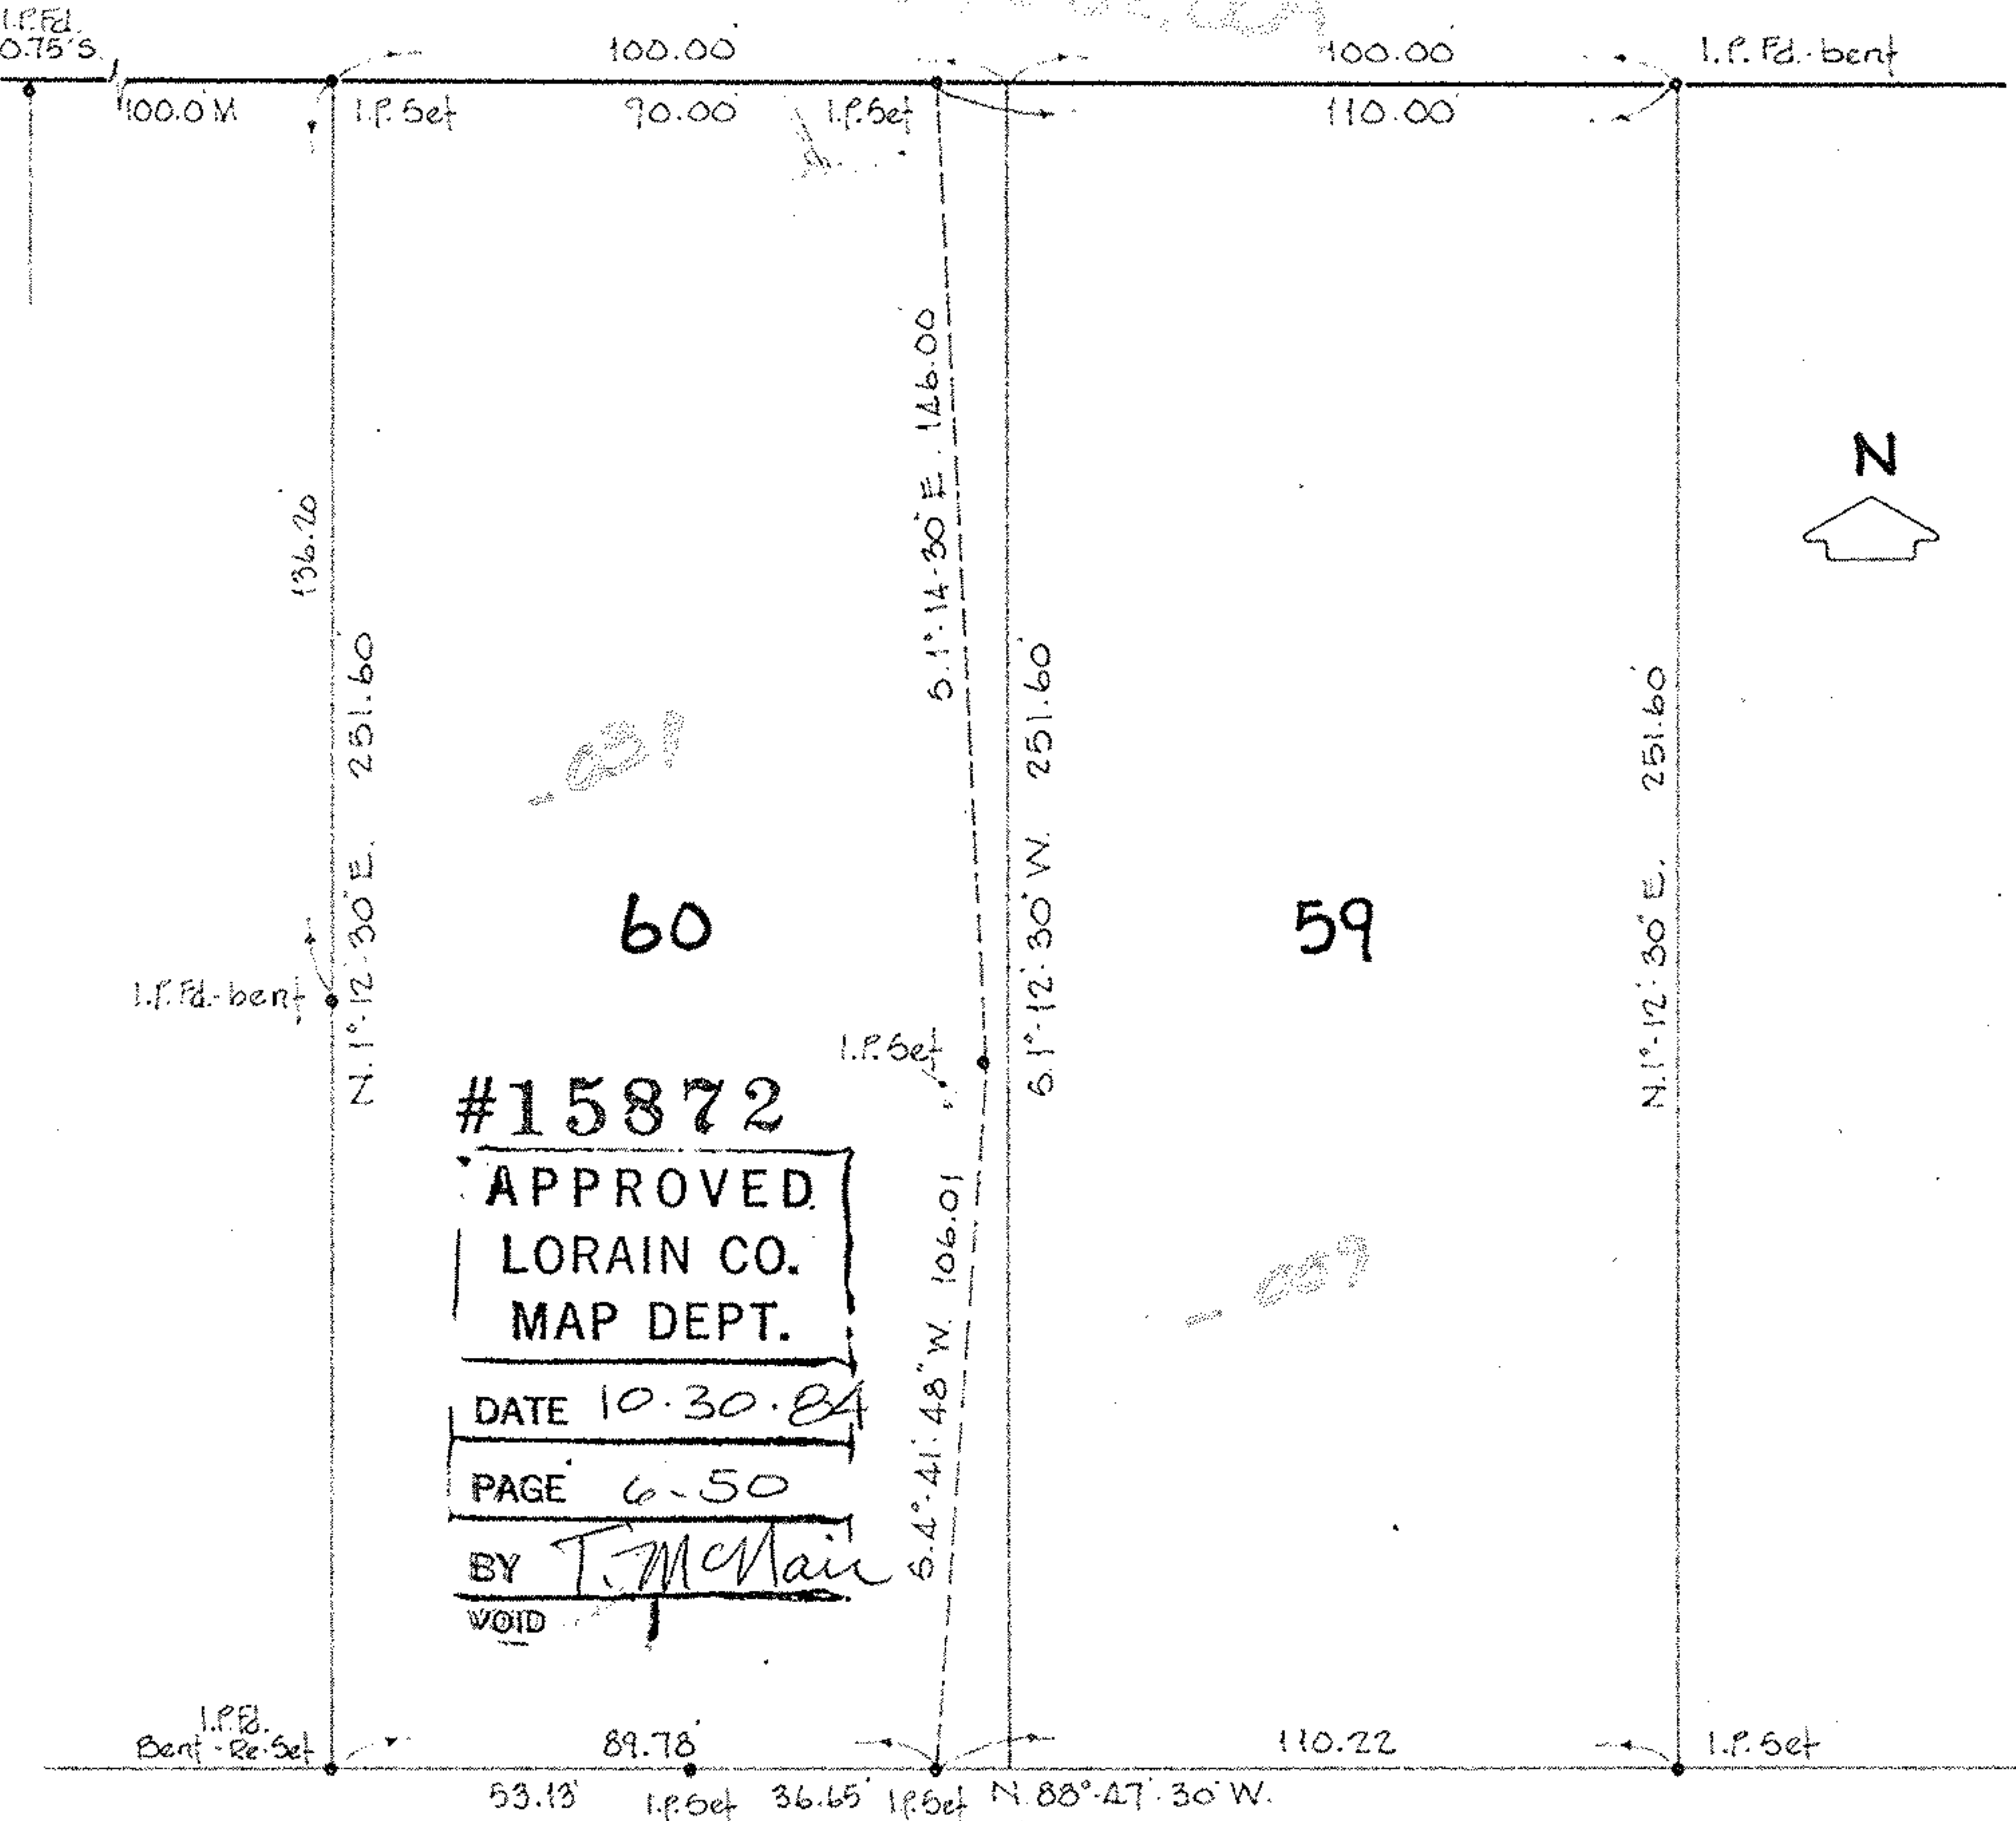

#15872

APPROVED
LORAIN CO.
MAP DEPT.

DATE 10.30.84

PAGE 6-50

BY T. McVair

VOID

06-25-173-000

#15872

6-50