

(25) 6-101
06-25-006

EAST BRANCH
BLACK RIVER
HIGH WATER
MARK
10'±

EXISTING GARAGES

2.5' WIDE
CONC. RETAINING WALL

WOOD SCREENING - 8' HIGH

0.02 AC

142.20'
DUE WEST

HEDGE: 3' WIDE, 4' HIGH

CONCRETE WALK

EXISTING RESIDENCE

10' BLACKTOP DRIVE WITH 4" STONE CURBS
N-88°23'19"-E

DUE NORTH

DRILL HOLE FOUND


WESTERN RESERVE MORTGAGE CORP. D.V. 1001 P. 595

6-101
06-25-125-000-005
BILLSAM INC. D.V. 679 P. 289

Little Fox
D & R 06
6-101

6-101
06-25-006

WASHINGTON AVENUE 100'

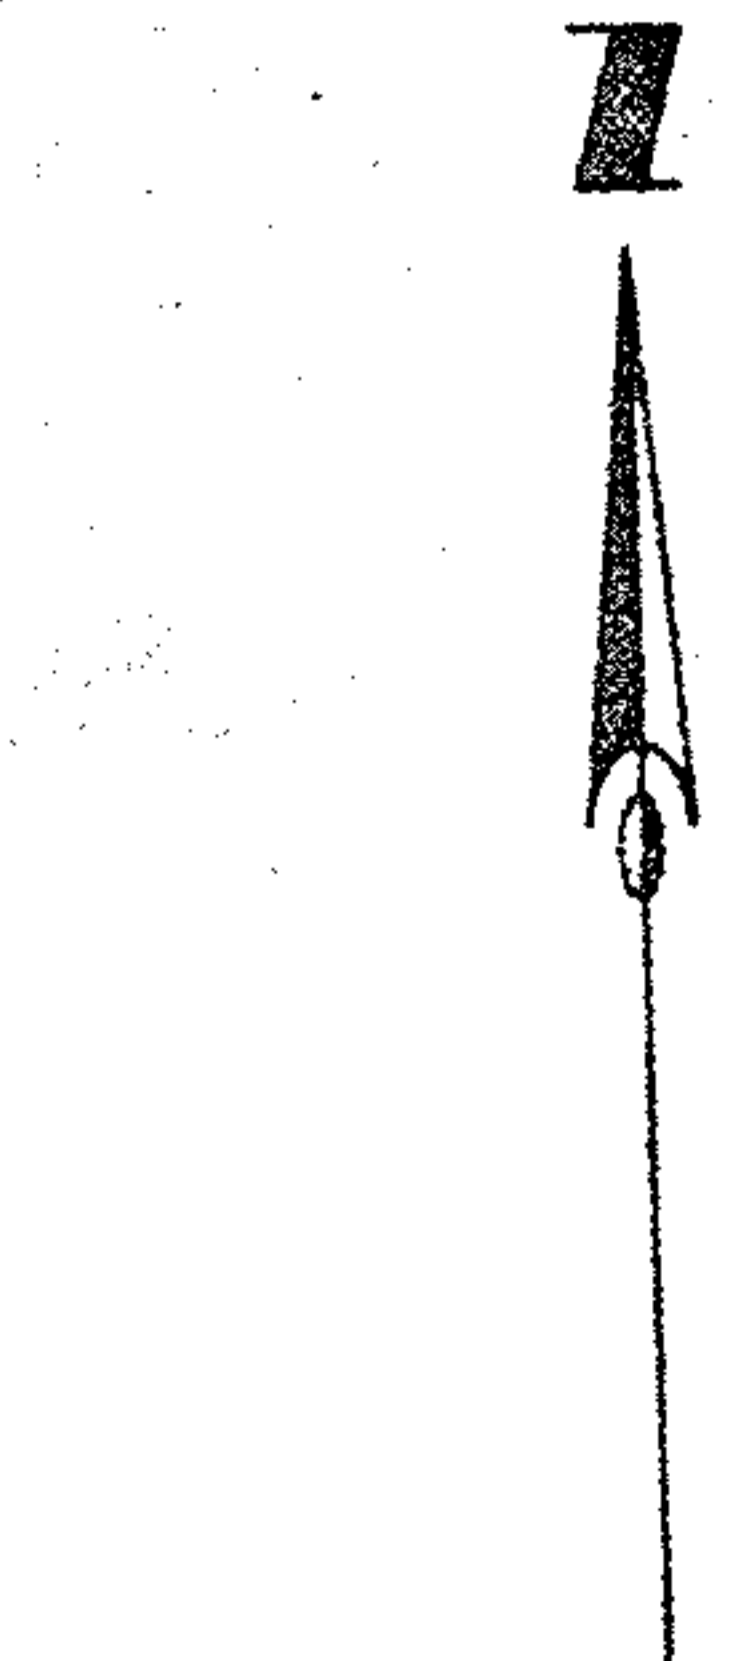

LOCATION SURVEY
OF PART OF
MILL LOT ~ ELYRIA TOWNSHIP ~ E. OF BLACK
CITY OF ELYRIA COUNTY OF LORAIN STATE OF

SCALE: 1" = 10'
JUNE 11, 1975
PREPARED BY
KLEINOEDER - SCHMIDT & ASSOC.
REGISTERED ENGINEERS & SURVEYORS
ELYRIA OHIO