


S. ASSOCIATES, INC.
 Middle Ave. P.O. Box 89
 WYRIA, OHIO 44036
 (216) 322-6317

David L. Elwell

REG. SURVEYOR
 No. 6333



05-00-004-102-059,060

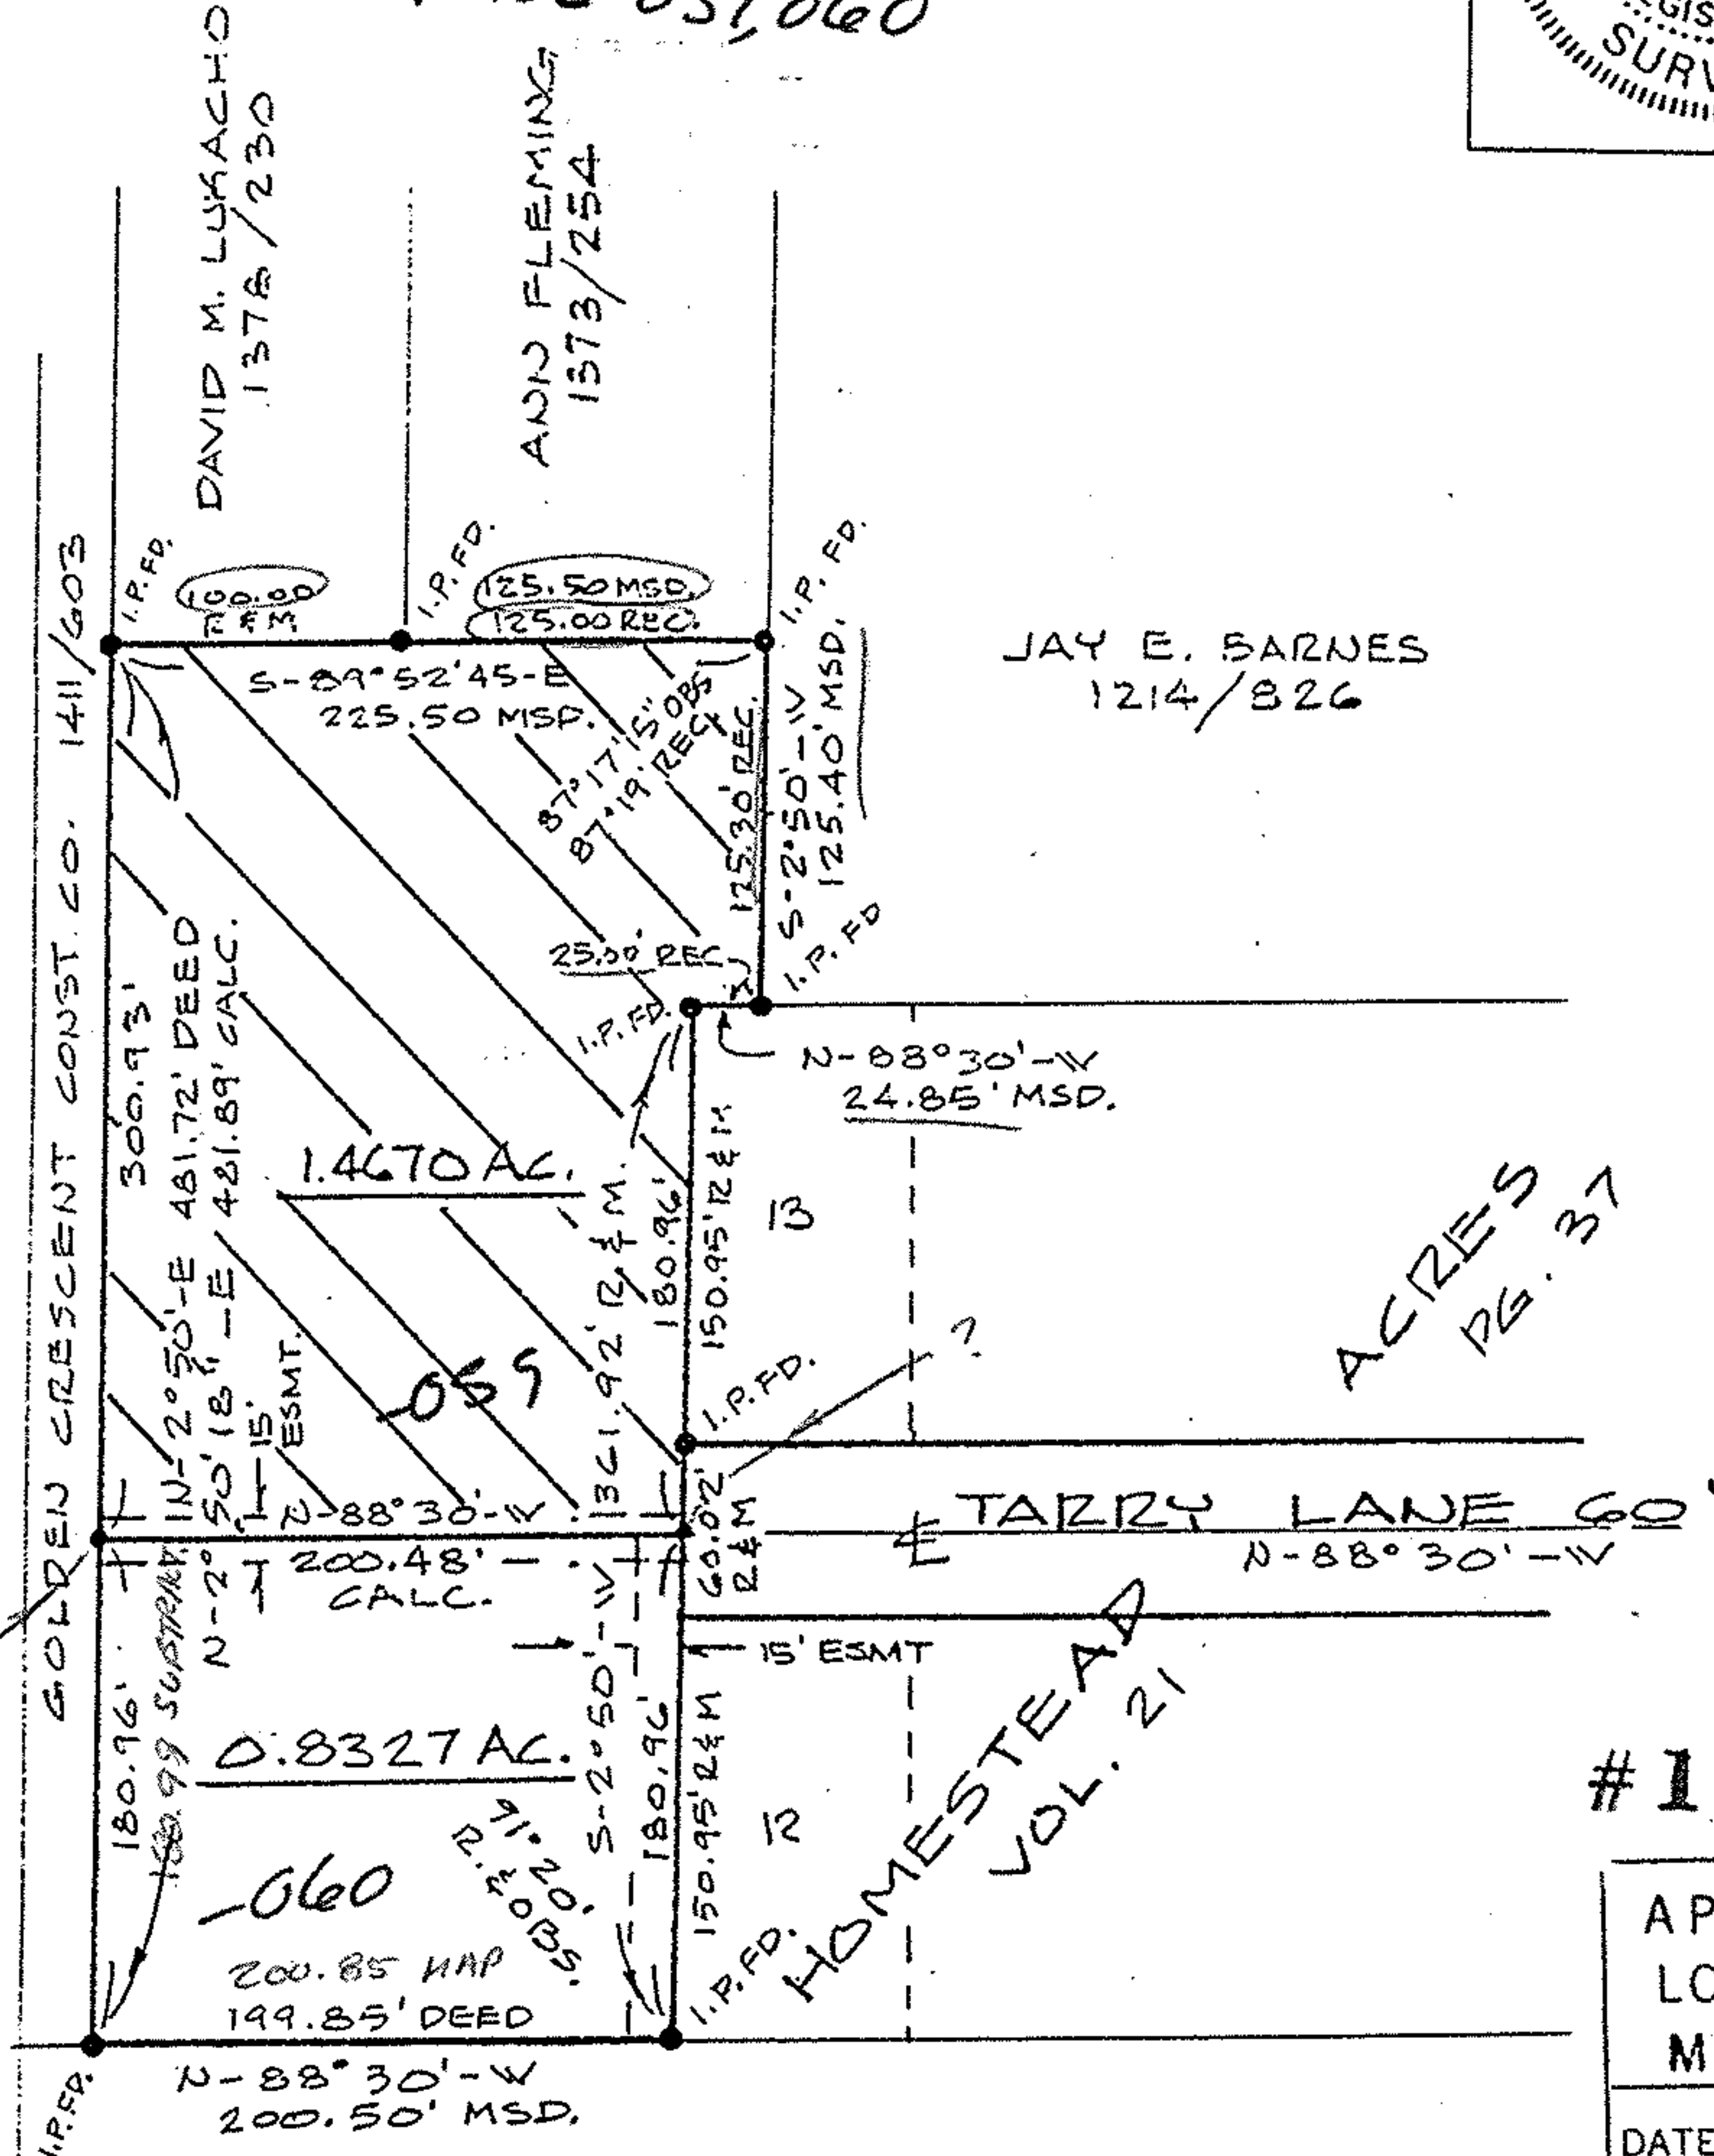

JAY E. BARNES
 1214/826

ACRES
 PG. 37

#18510

APPROVED
 LORAIN CO
 MAP DEPT.

DATE 6-30-89

PAGE 5-00-004-B

BY Carolyn Francis

VOID AFTER #18510

L.E.P. CO. 1225/10

MAP OF PROPERTY SURVEY

PART OF

ORIGINAL AMHERST TOWNSHIP LOT No 4

CITY OF AMHERST - COUNTY OF LORAIN - STATE OF OHIO