



0 1371A

Survey Map Part of C.L. 9 Amherst Twp. Now Village of South Amherst
Scale 1" = 100' June 21, 1969 By Arnold F. Keepp
Registered Surveyor No. 4386

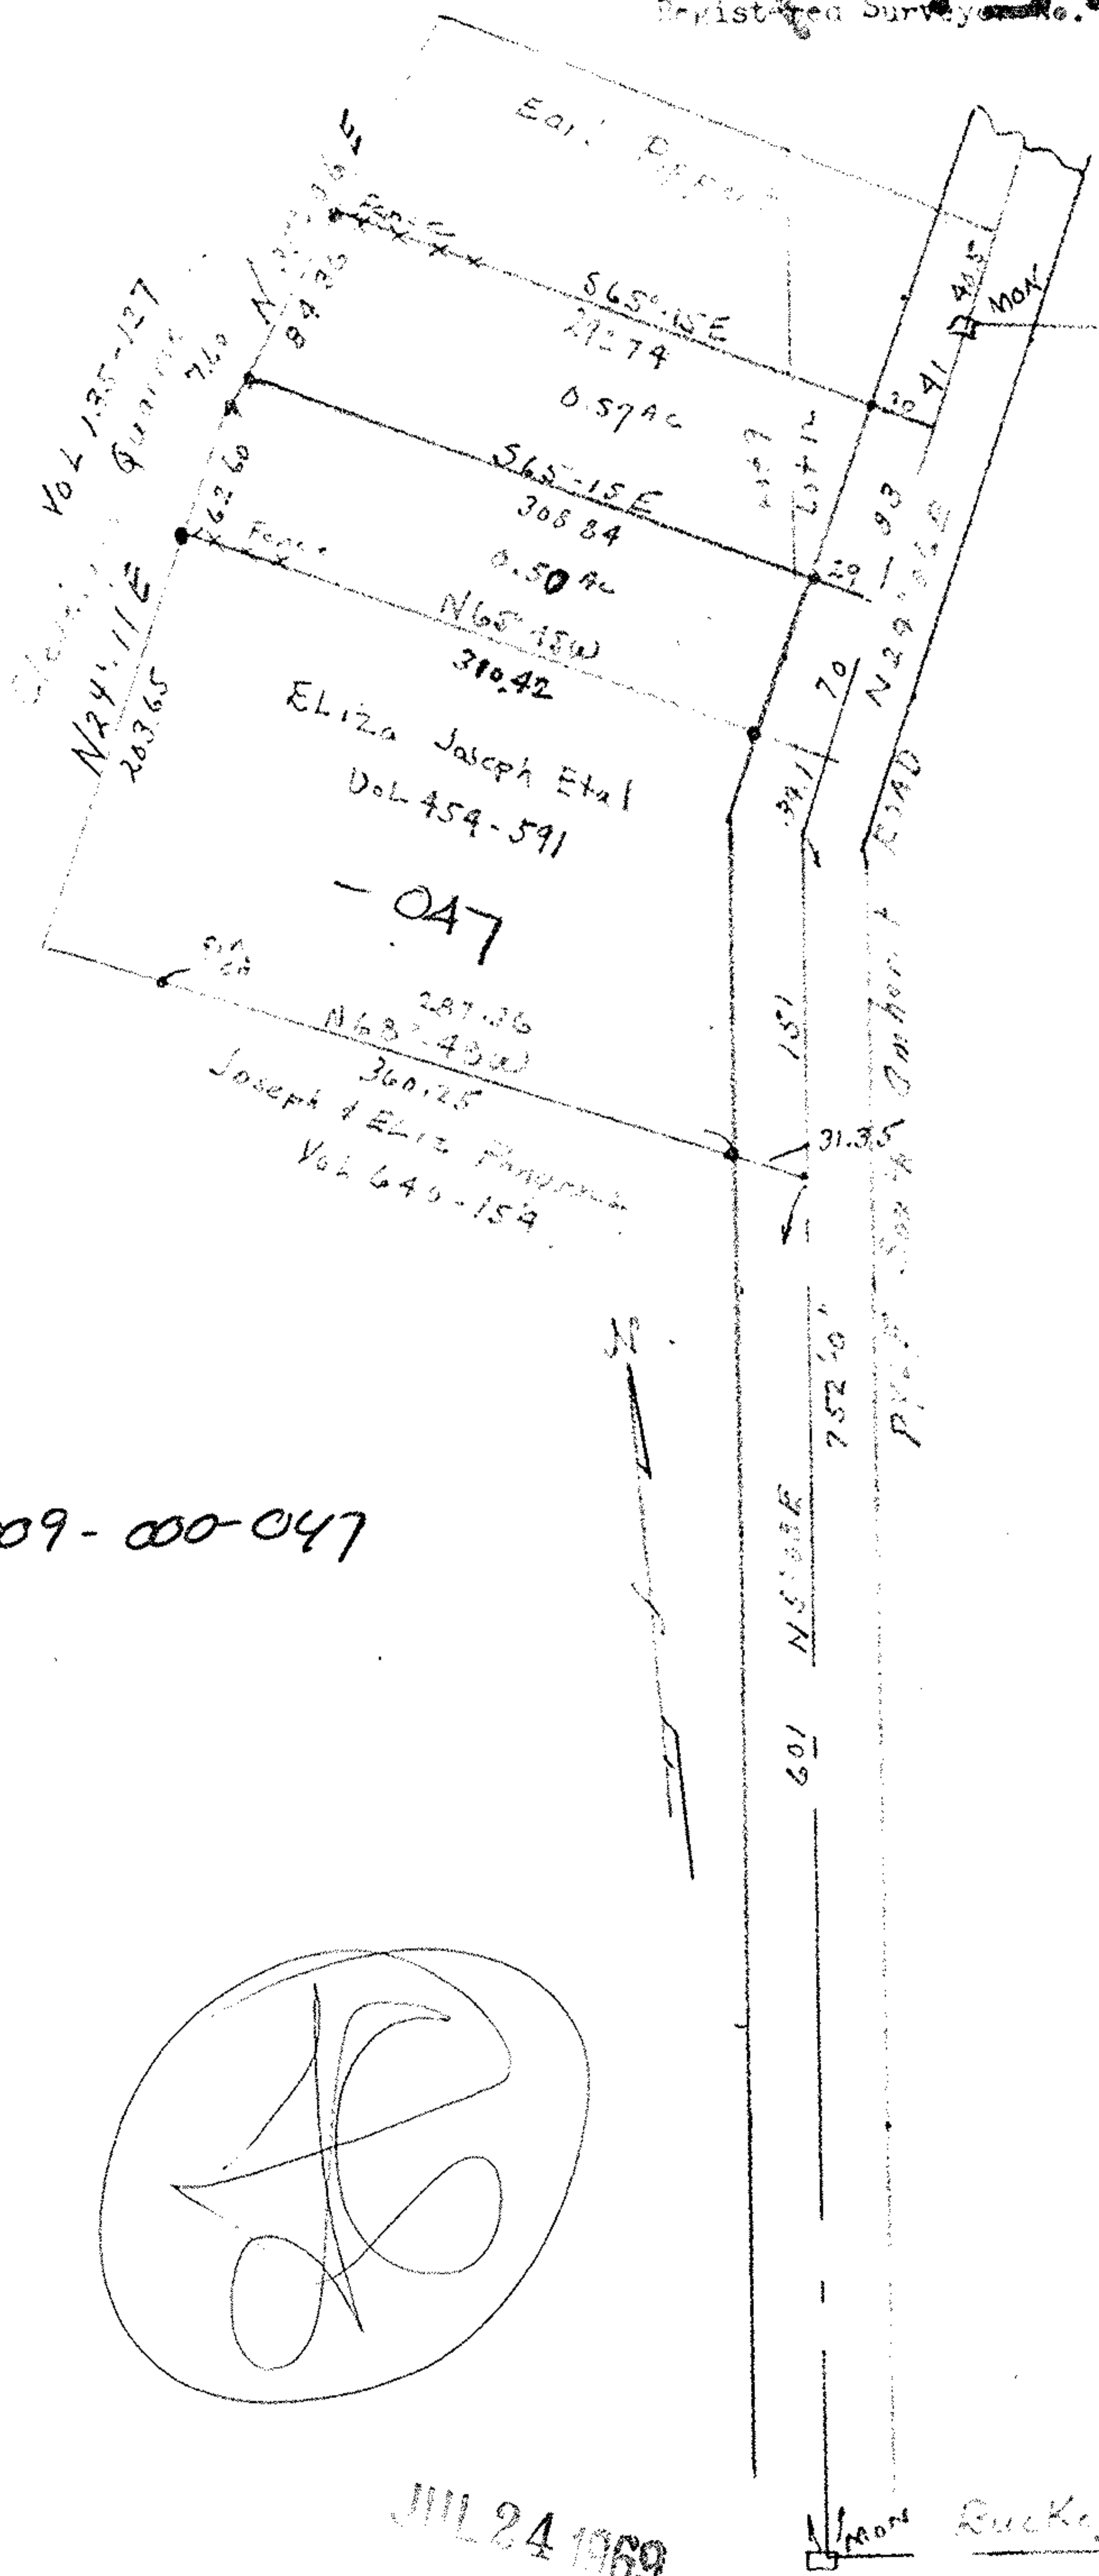

05-00-009-000-047

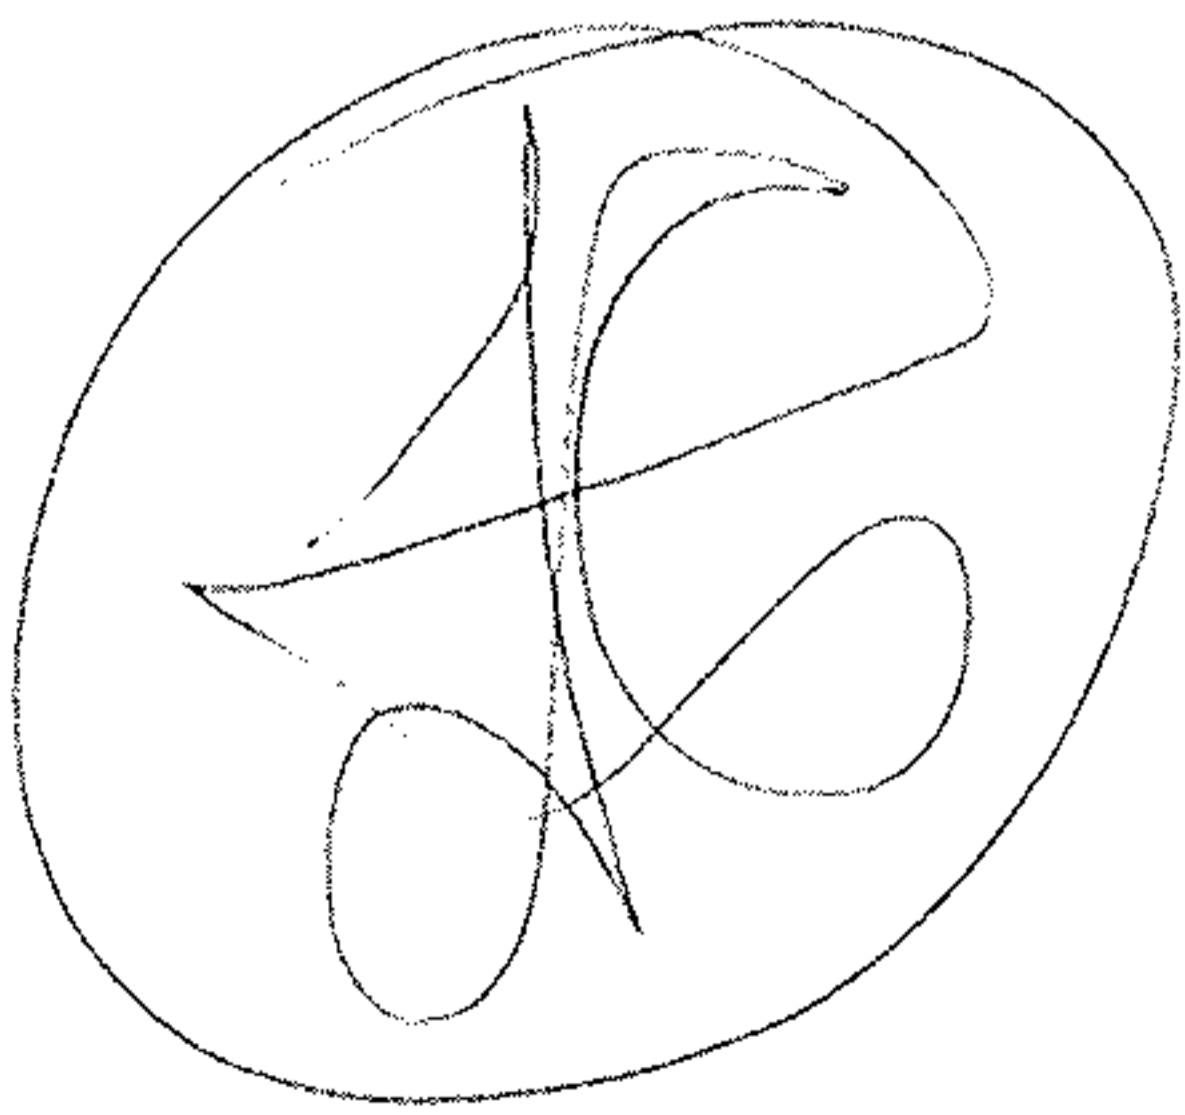

JUL 24 1969

Arnold F. Keepp

5-00-009-B