


Map of Part of Lot 10 Amherst Twp. now Village of South Amherst Co. of Lorain
 State of Ohio Scale 1" = 60' March 25, 1985
 By Arnold F. Koepf Reg. Surveyor
 N. LINE O. L. 10

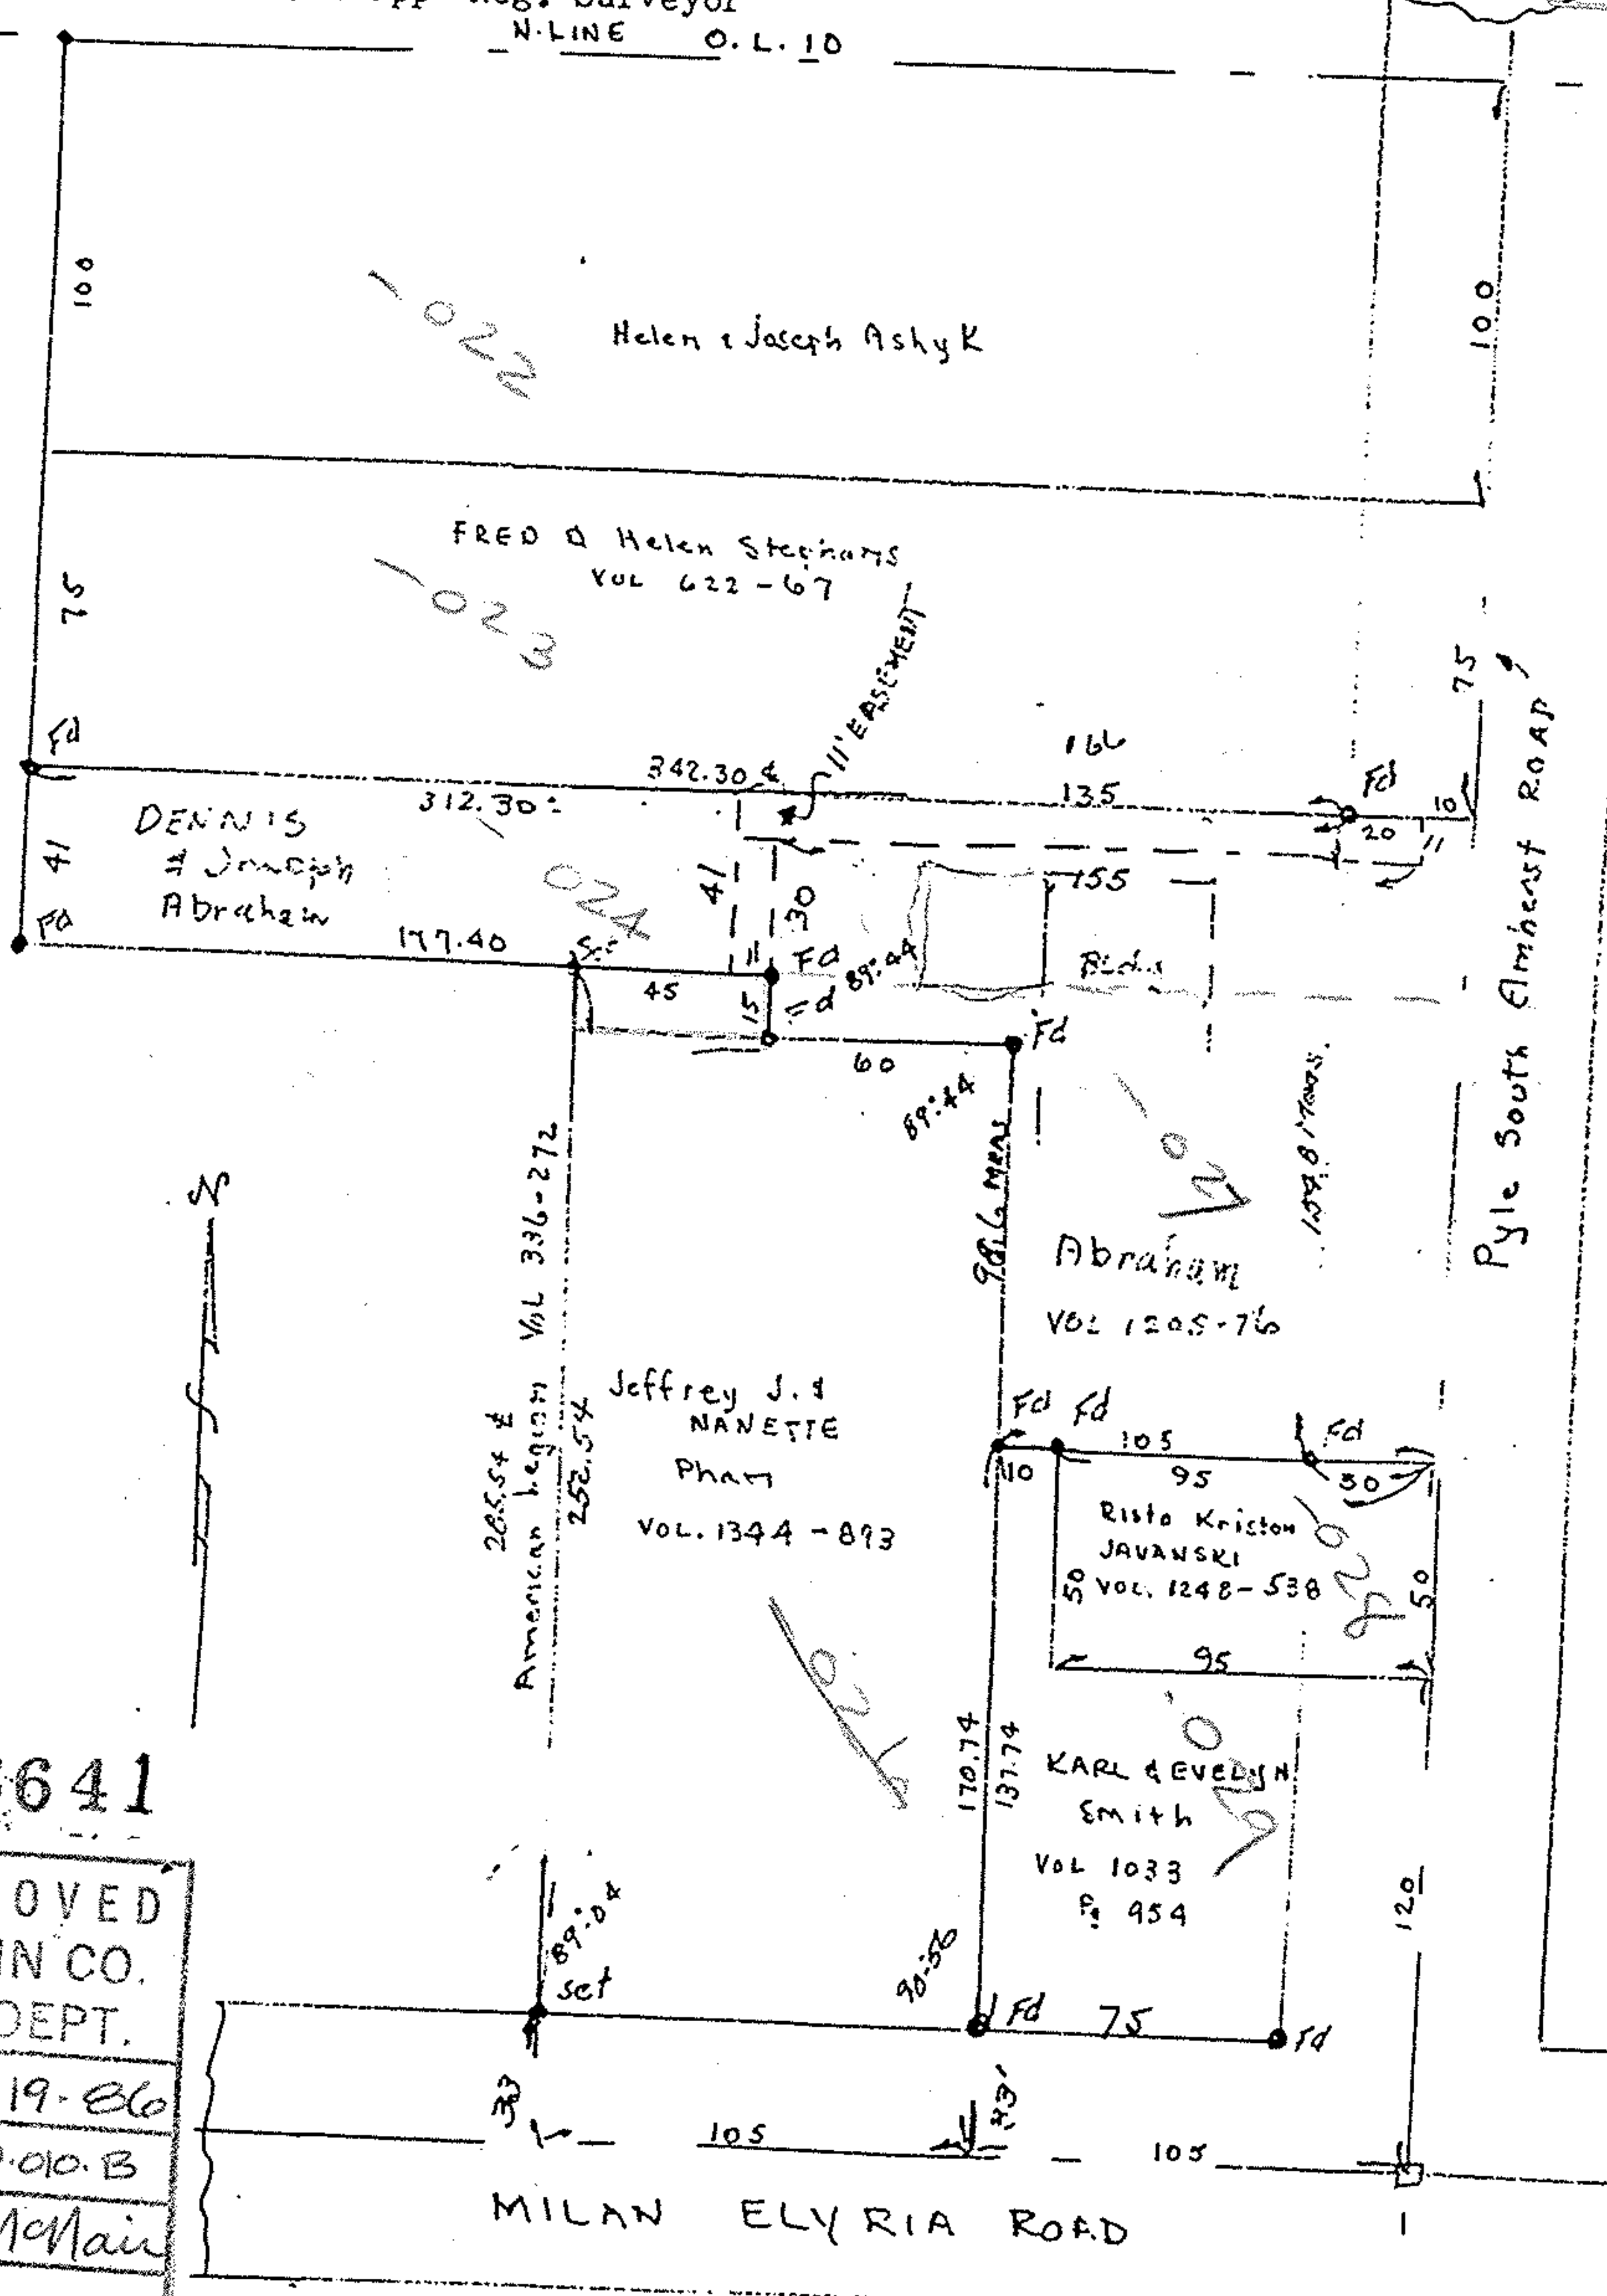

#16641

APPROVED
 LORAIN CO.
 MAP DEPT.
 DATE 3-19-86
 PAGE 500-010-B
 BY T. McMain
 VOID
 AFTER

05-00-010-101-022, 023, 024, 027

101-05-00-010-101