


5-00-021-A #18779 05-00-021-102

norman r. hura & associates

development consultants  
4808 edgewood drive  
lorain, ohio 44053

#18779
APPROVED
LORAIN CO.
MAP DEPT.
DATE 12-19-07
PAGE 5-00-021-A
BY T. McLean
VOID AFTER 18779

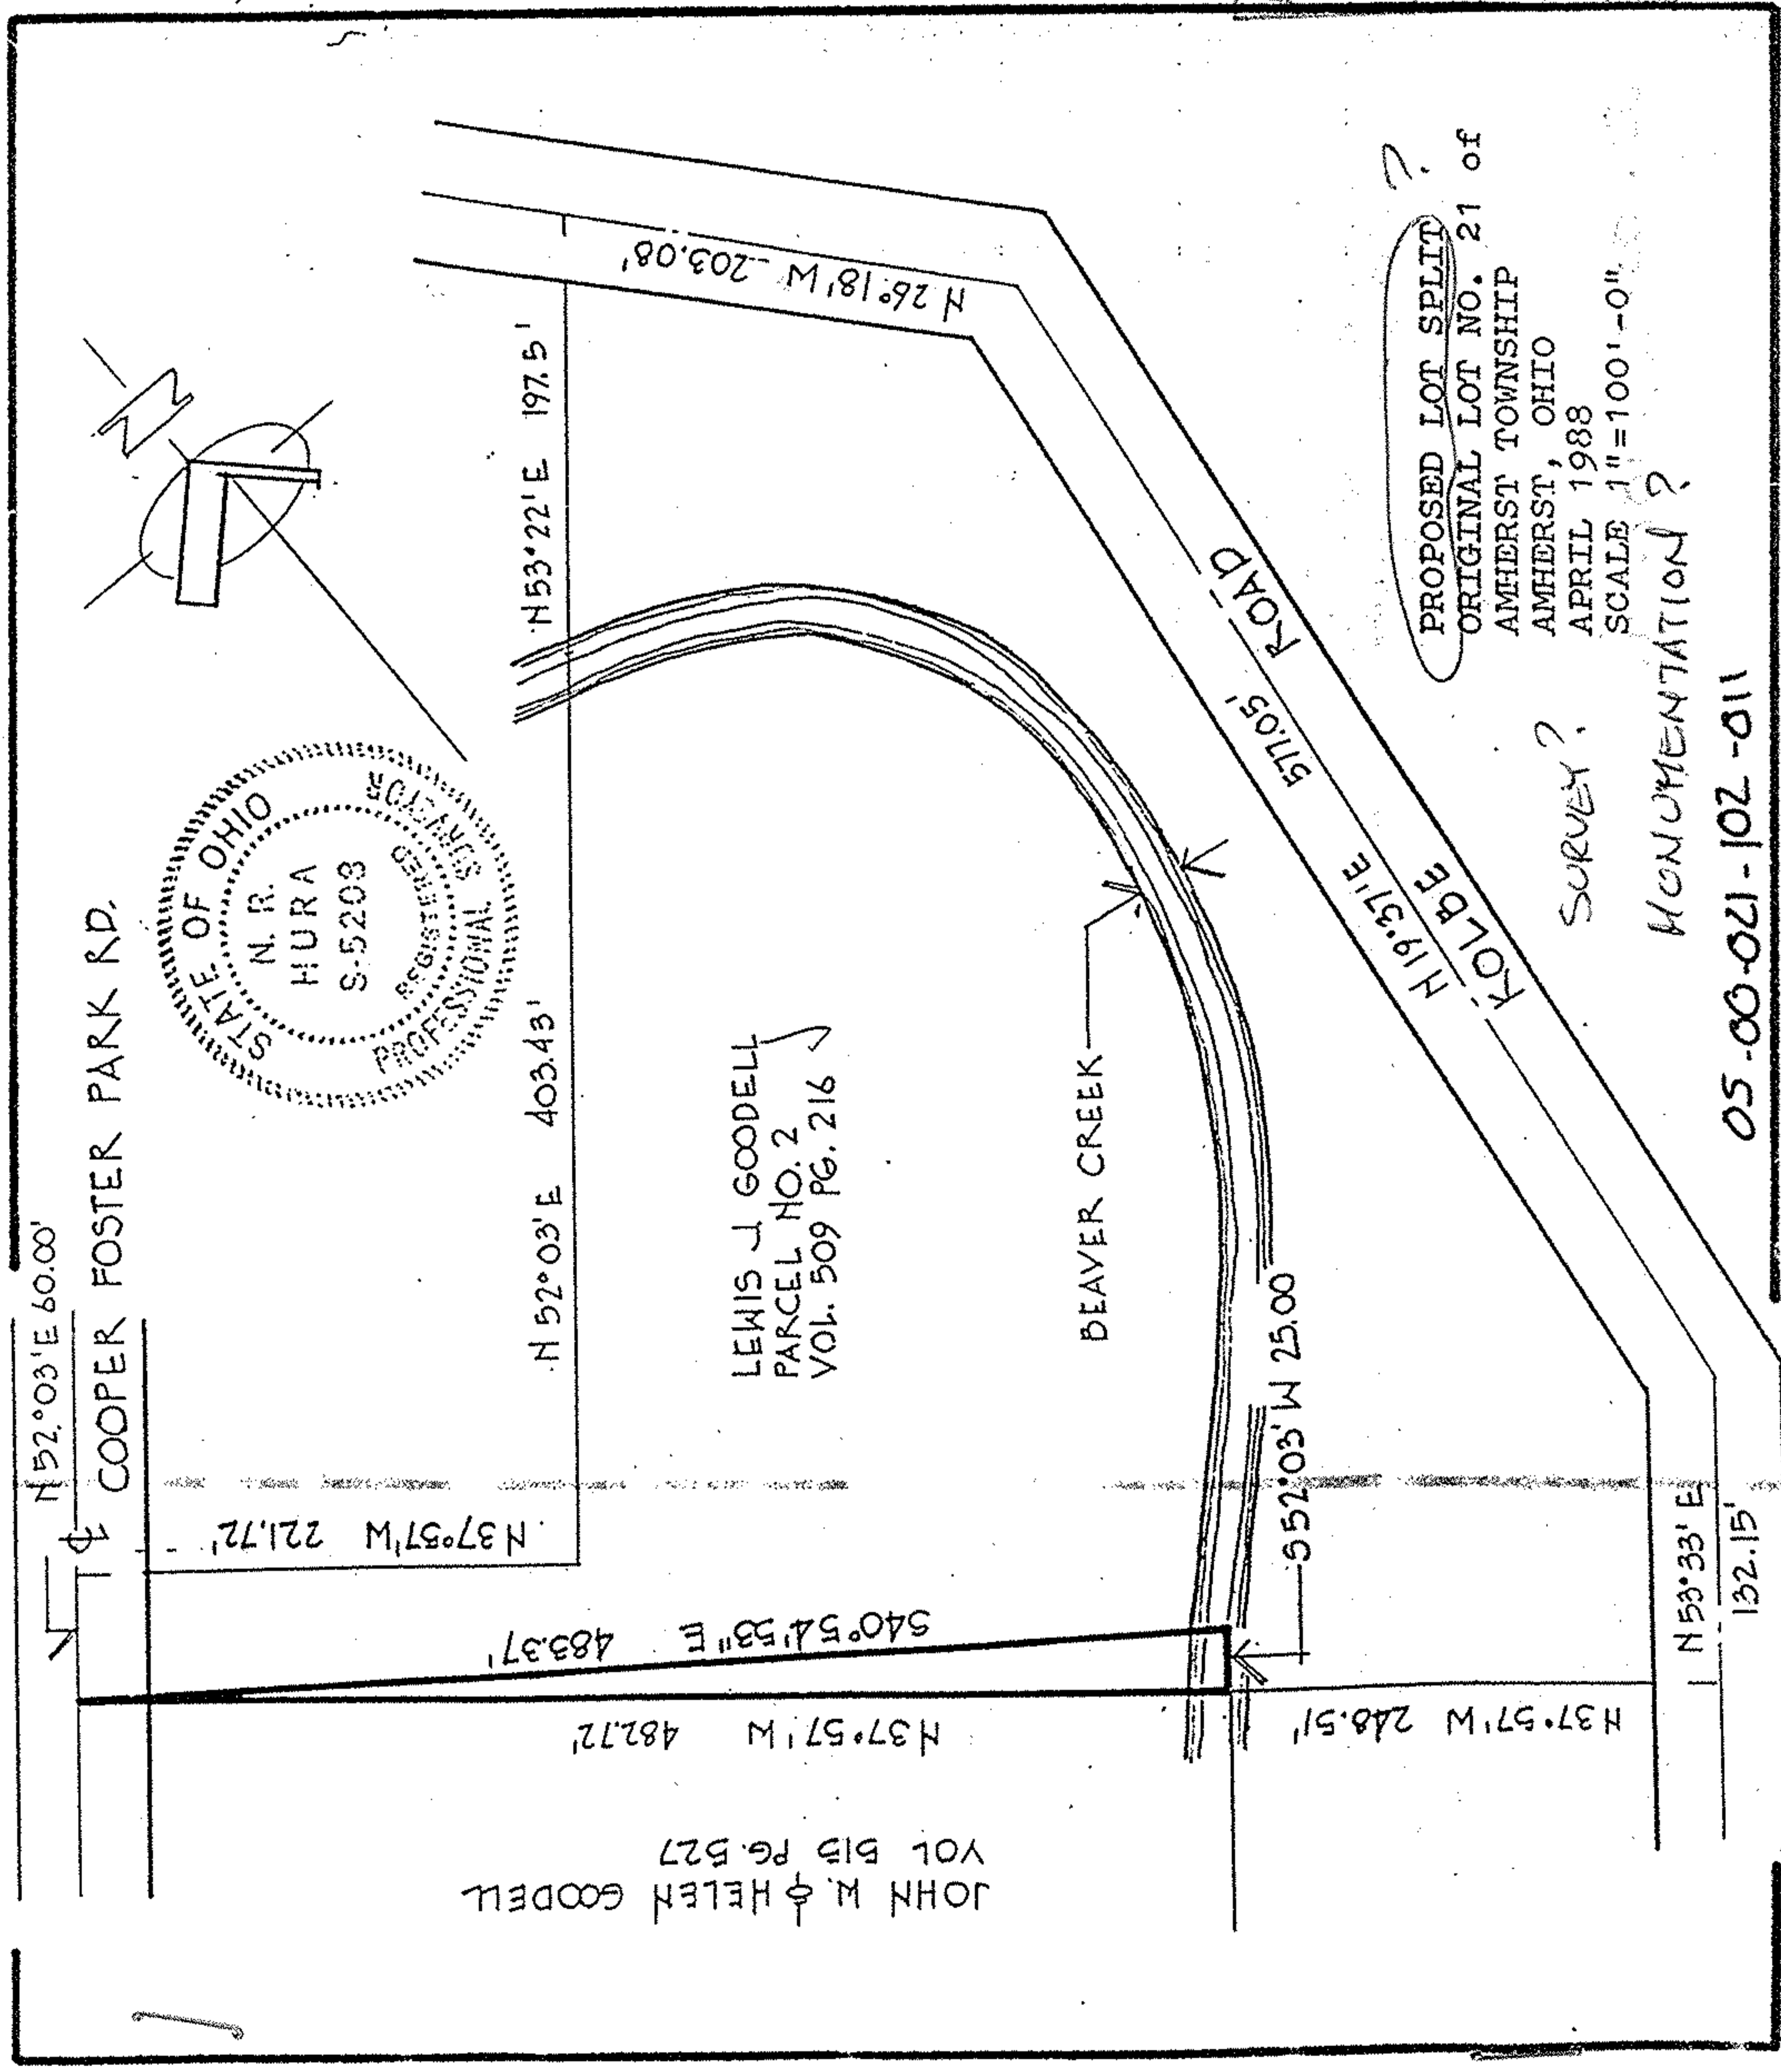

PROPOSED LOT SPLIT  
 ORIGINAL LOT NO. 21 of  
 AMHERST TOWNSHIP  
 AMHERST, OHIO  
 APRIL 1988  
 SCALE 1" = 100' - 0"  
 SURVEY?  
 MONUMENTATION?

05-00-021-102-011