


Sub Lot 37
 A Robert and Olga Havanas V.1158, P.744 2/27/76

05-00-024-102-

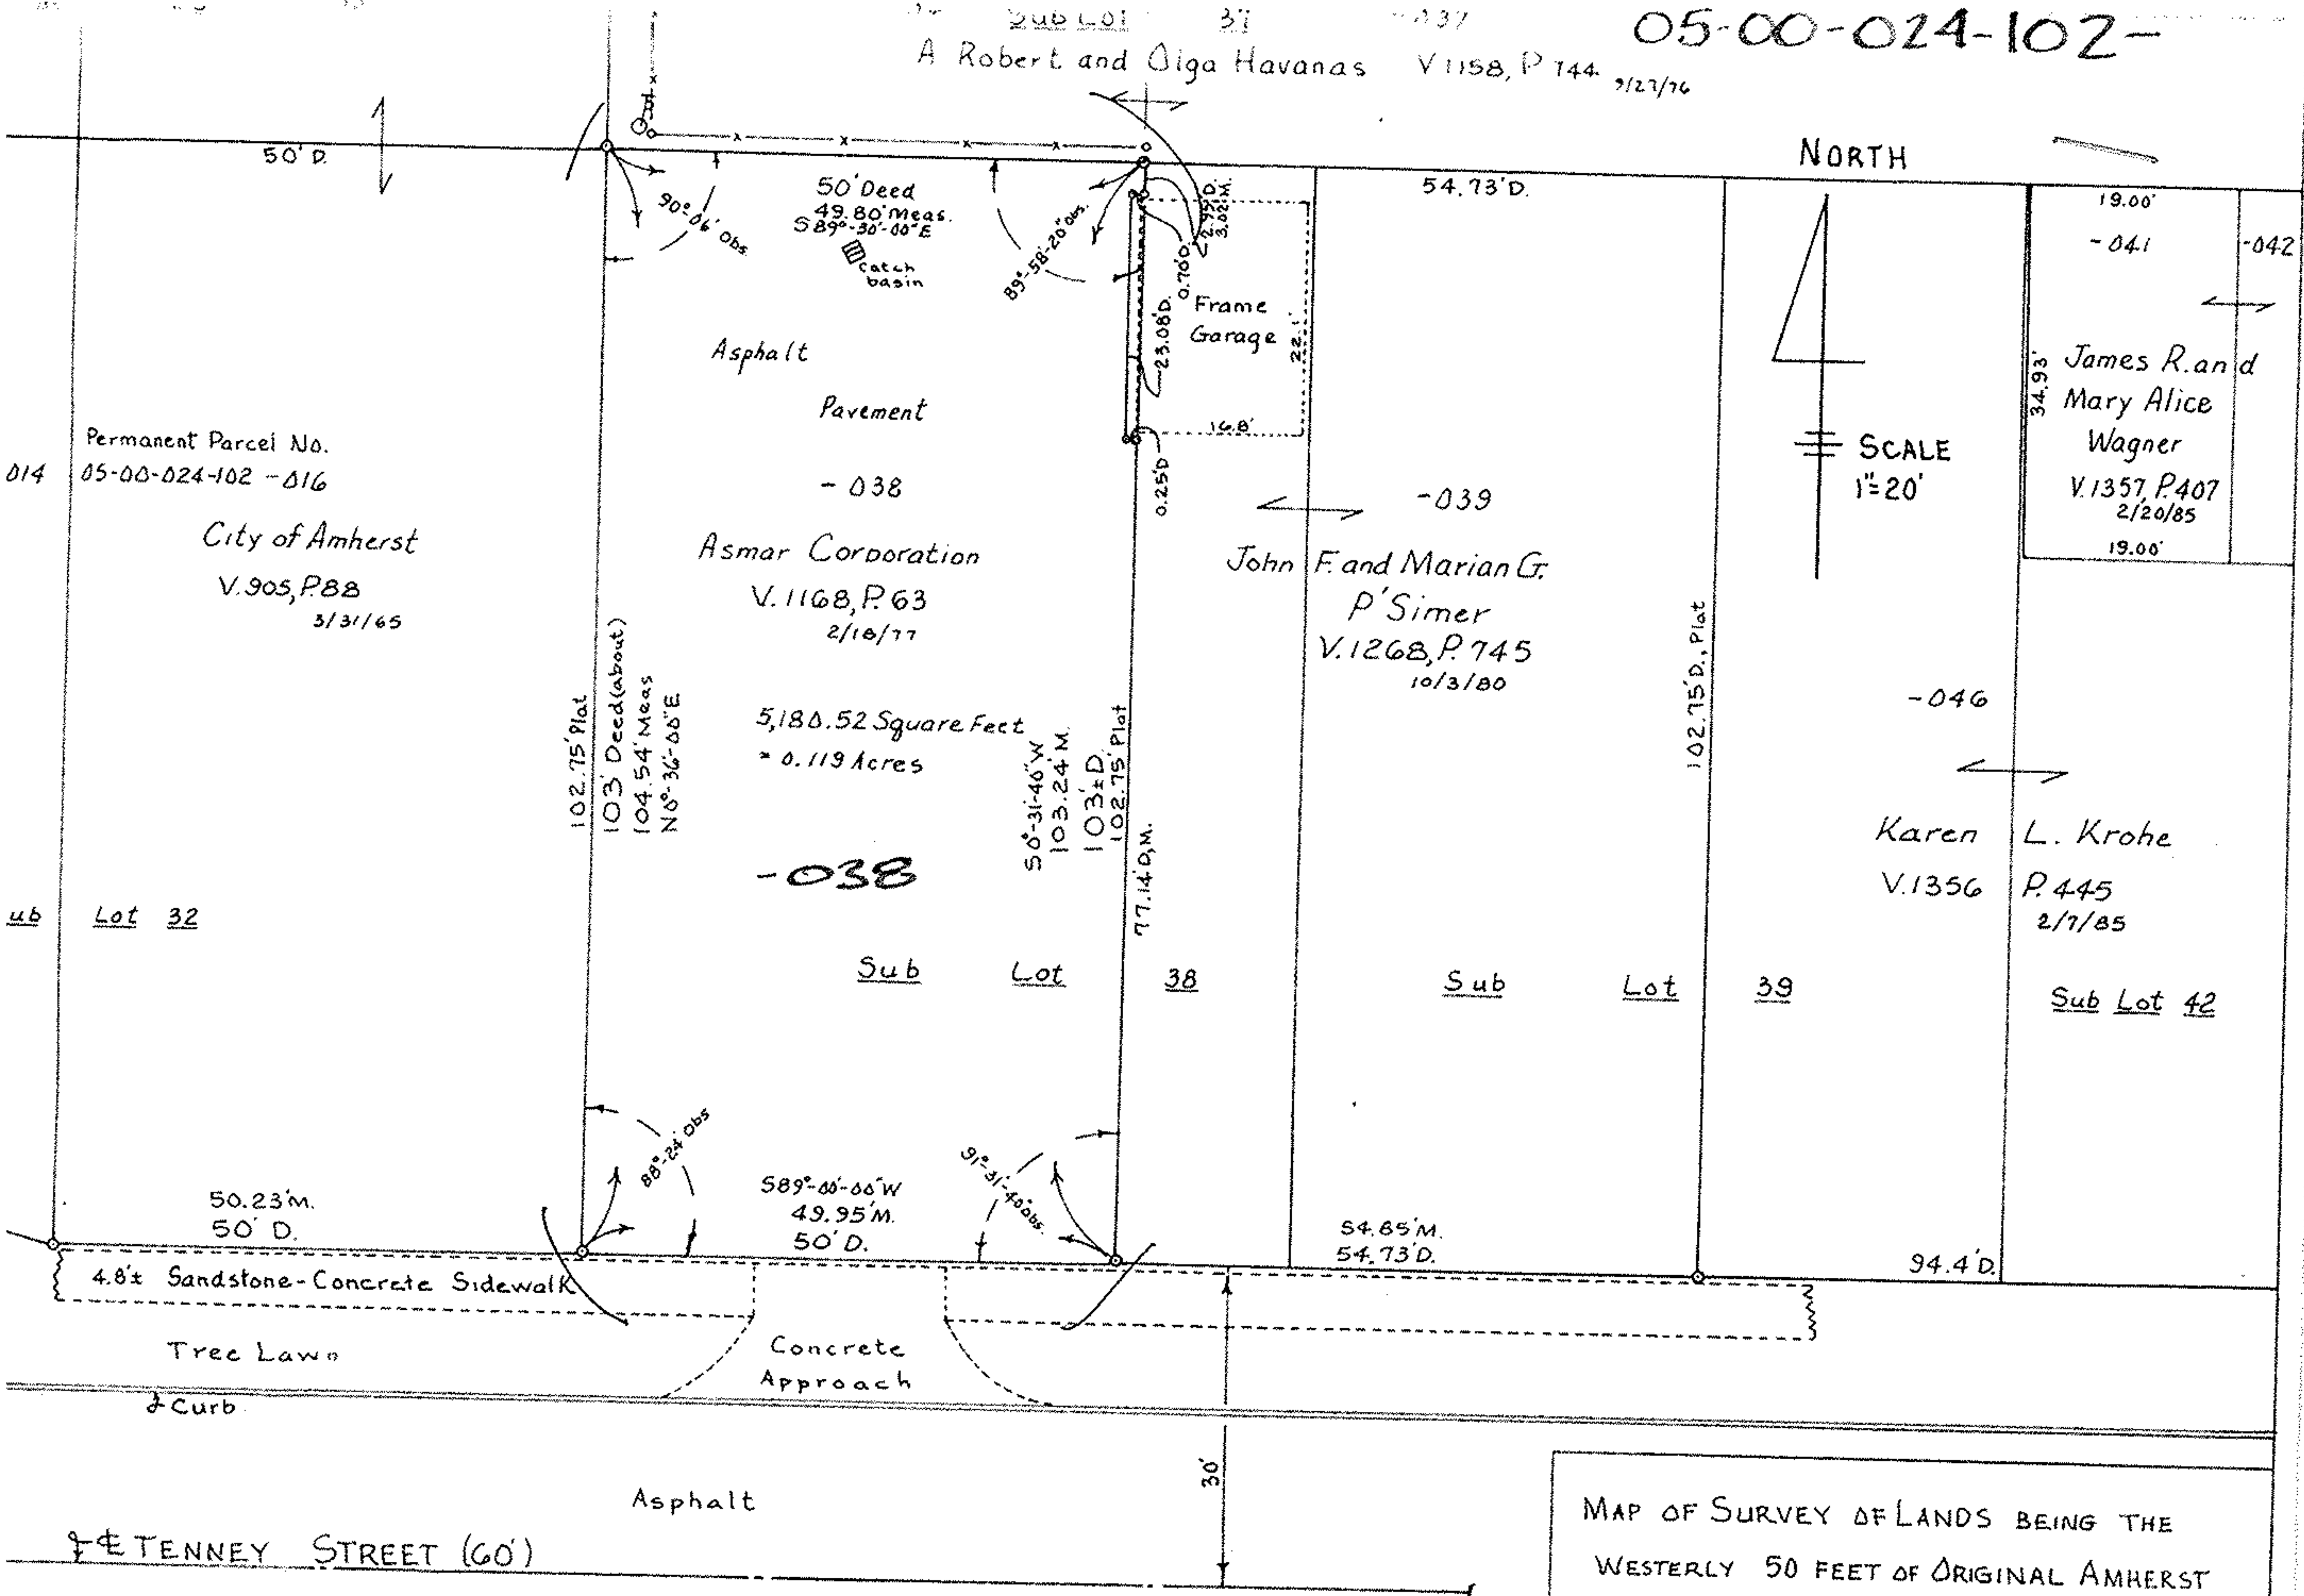

25-00-024-102-016, 038, 039, 046

LEGEND: Iron Pin Found
 Shown thus: ○

Prepared by: Charles P. Waryu Reg. Surveyor No. 5029

MAP OF SURVEY OF LANDS BEING THE WESTERLY 50 FEET OF ORIGINAL AMHERST VILLAGE LOT NO. 38, PART OF ORIGINAL AMHERST TOWNSHIP LOT NO. 24 RECORDED PLAT VOL. I PAGE 187, CITY OF AMHERST OHIO
 Prepared for Milad H. Abraham