

05-00-023-113

5-00-023-B

5-8-78


J. Johnson

11628

Map of Part of Sublot 1 Axtell Homestead Addition Vol. 7 Page 9
Scale 1" = 50'
March 8, 1978

By Arnold F. Koepp Registered Surveyor No. 4306

Map revised for 10 foot parcel March 31, 1978

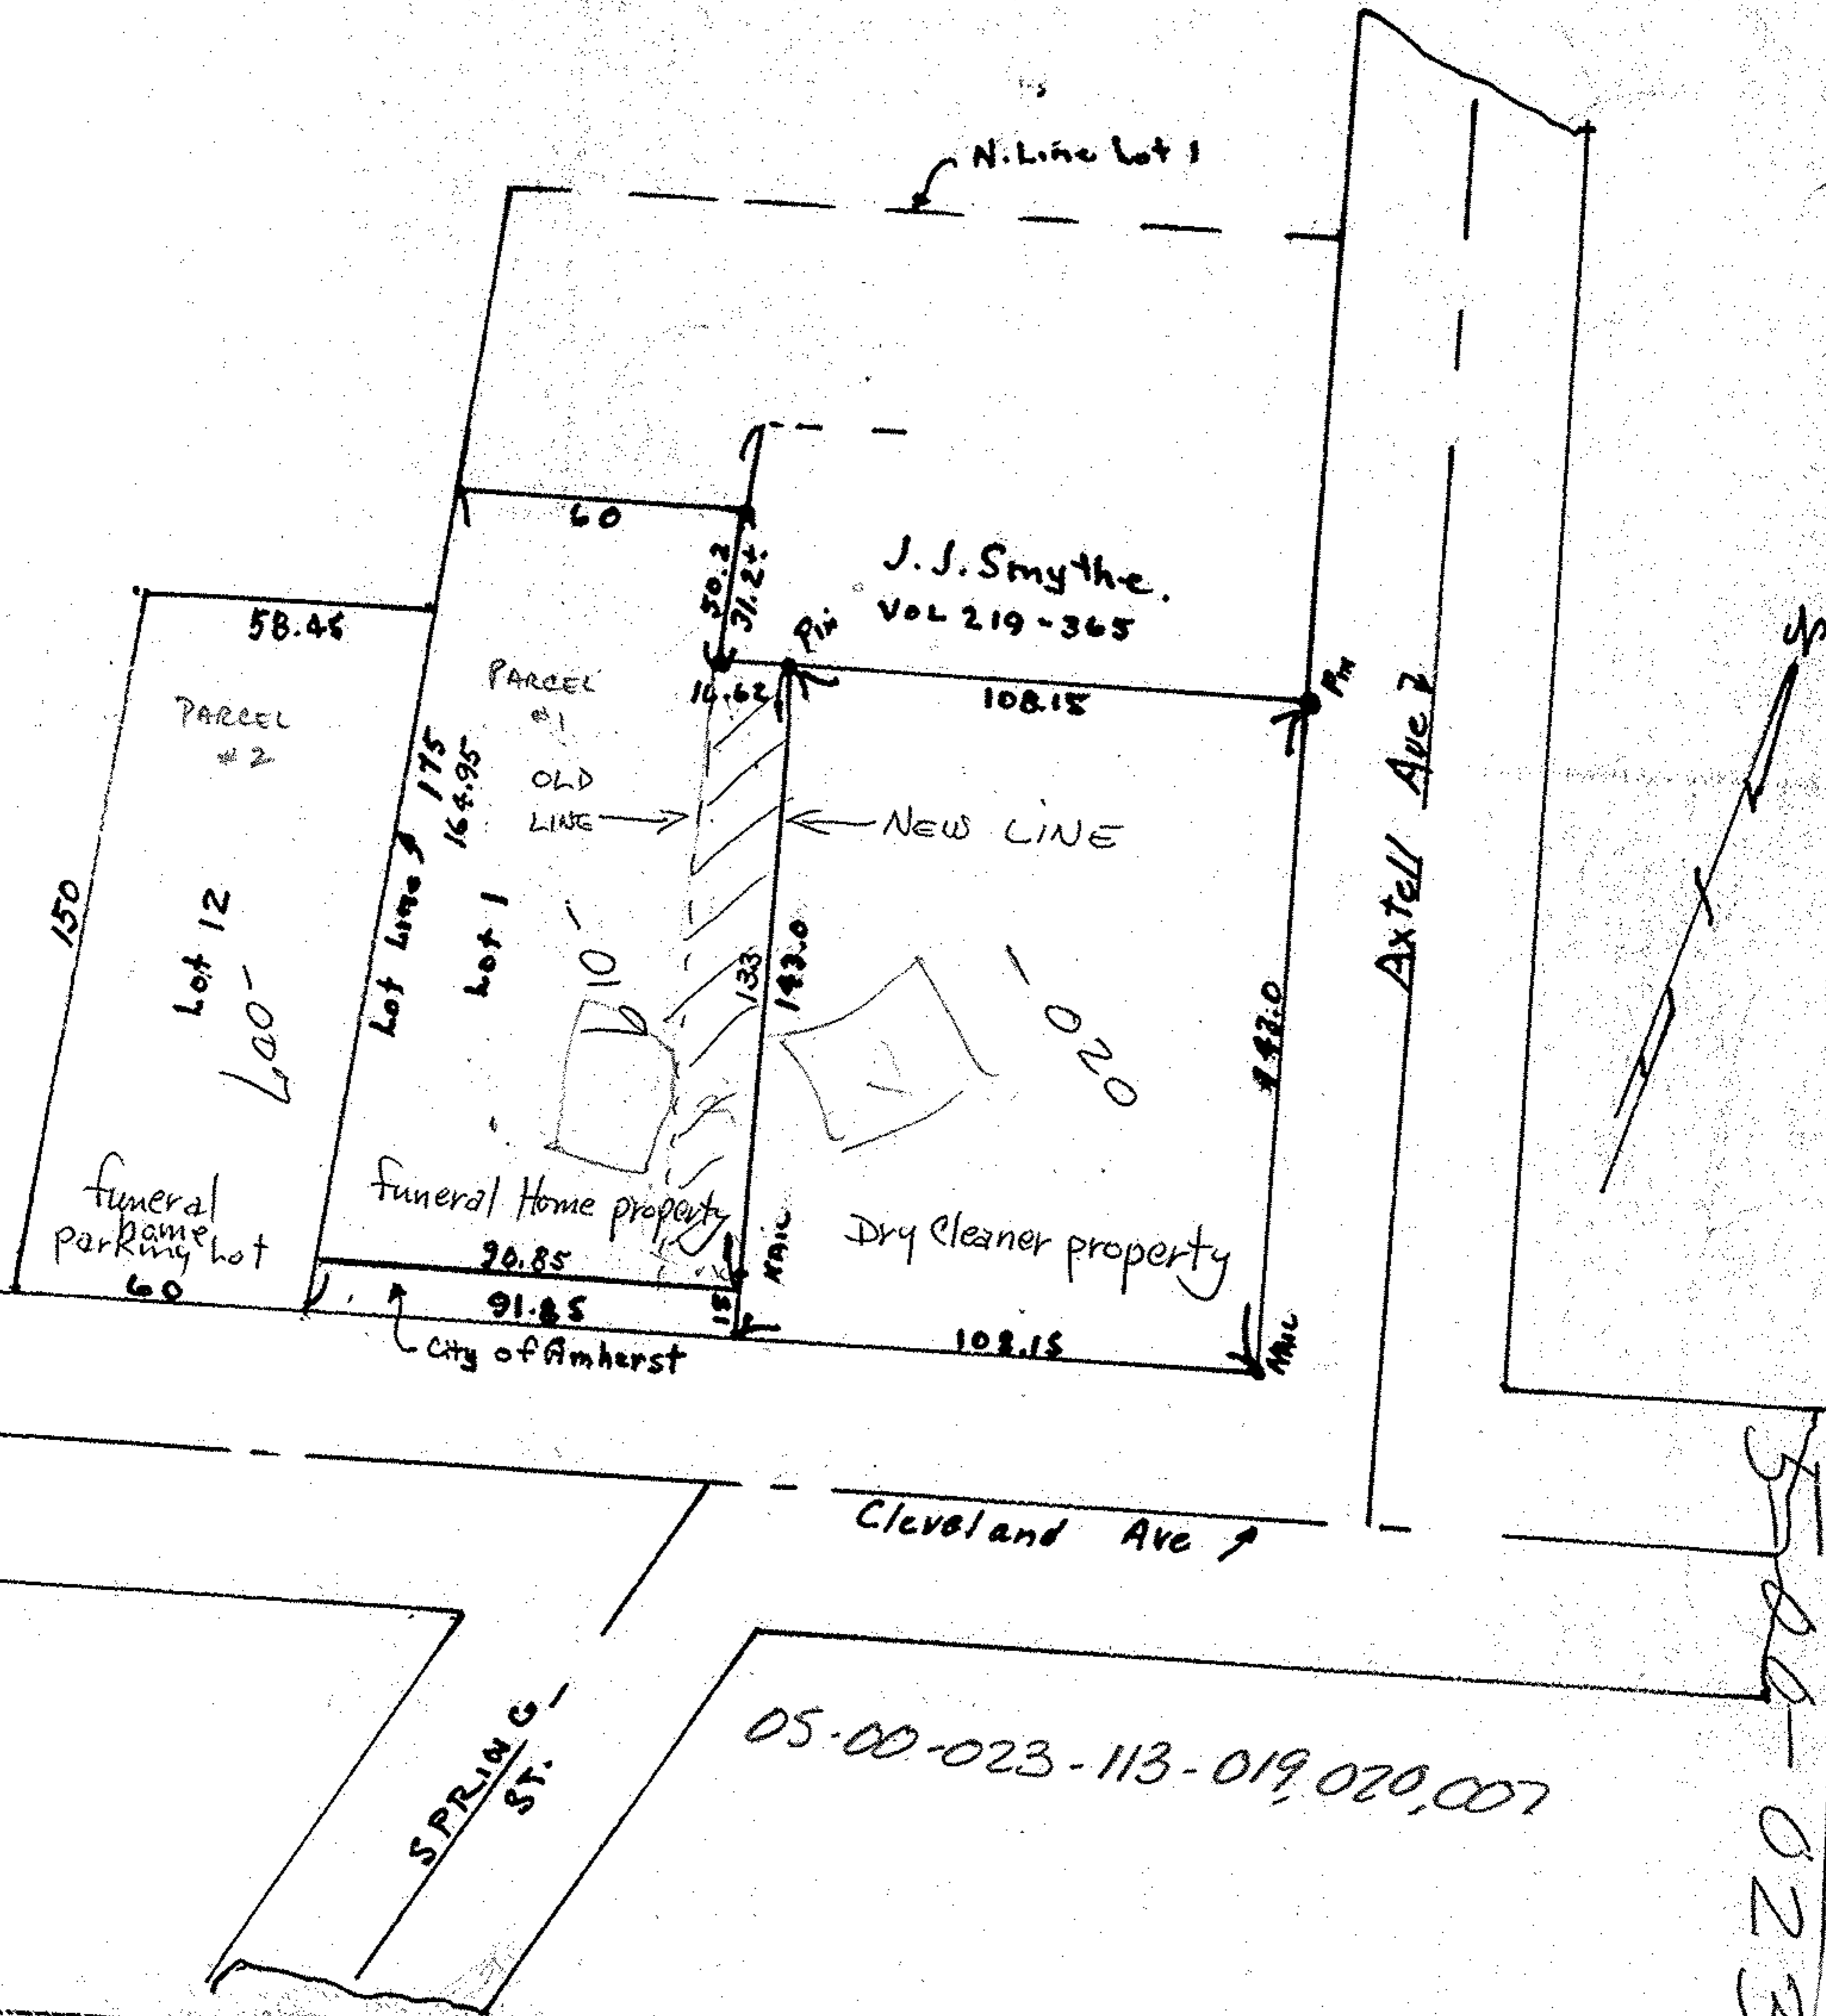

05-00-023-113-019,020,007

5-00-023-B