

SCALE: 1"=100'

MIDDLE RIDGE ROAD  
N 61°42' E 458.03'  
60'

1.P.Fd  
D.U. 1420 PG. 798

N 03°-04' E 784.19


#17772

5-00-026-B

P4-024  
7.767 Ac.

S 02°-33' W 924.59

STATE OF OHIO D.U. 606, PG. 306

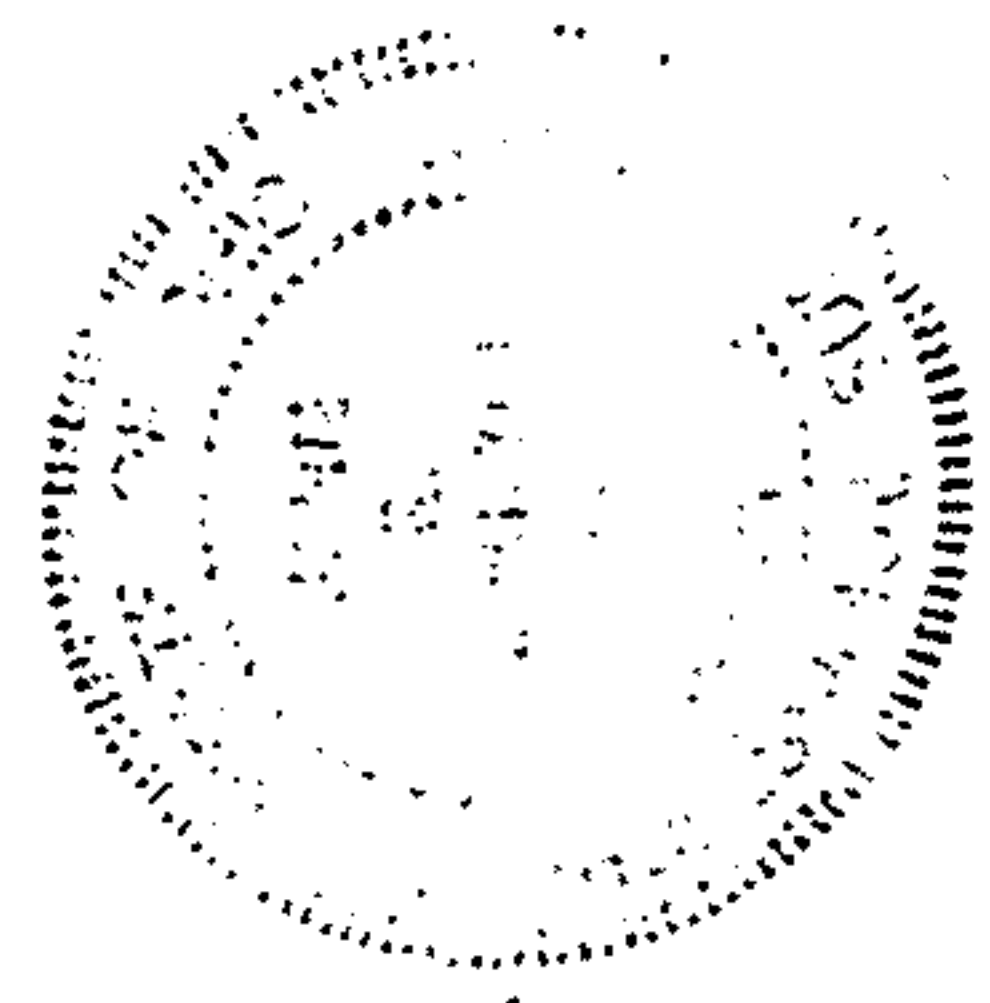

05-00-026-101-024

#17772

APPROVED LORAIN CO. MAP DEPT.
DATE <b>11-19-87</b>
PAGE <b>5-00-026-B</b>
BY <b>C. FRANCIS</b>
VOID AFTER <b>17772</b>

MAP of BOUNDARY SURVEY

PREPARED FOR: ESTATE of JOHN H. LUDWIG

PART of ORIG. AMHERST TWP. LOT 26

NOW in CITY of AMHERST LORAIN COUNTY OHIO

Pt. P.P. No. 05-00-026-101-024

K. E. MCCARTNEY & ASSOCIATES

SEPT. 28, 1987

#871619

STATE OF OHIO  
D.U. 603 PG. 120  
(No. 2)