


05-00-030-000-044

1324 7

Map of C.L. 30
Amherst Twp. South Amherst
Village, Lorain Co. Ohio
Scale 1" = 100'
Dec. 15, 1980
By Arnold F. Koopp
Reg. Surveyor

#18357

APPROVED	
LORAIN CO.	
MAP DEPT.	
DATE 3-21-89	
PAGE 5-00-030-A	
BY T. McMan	
VOID AFTER	18357

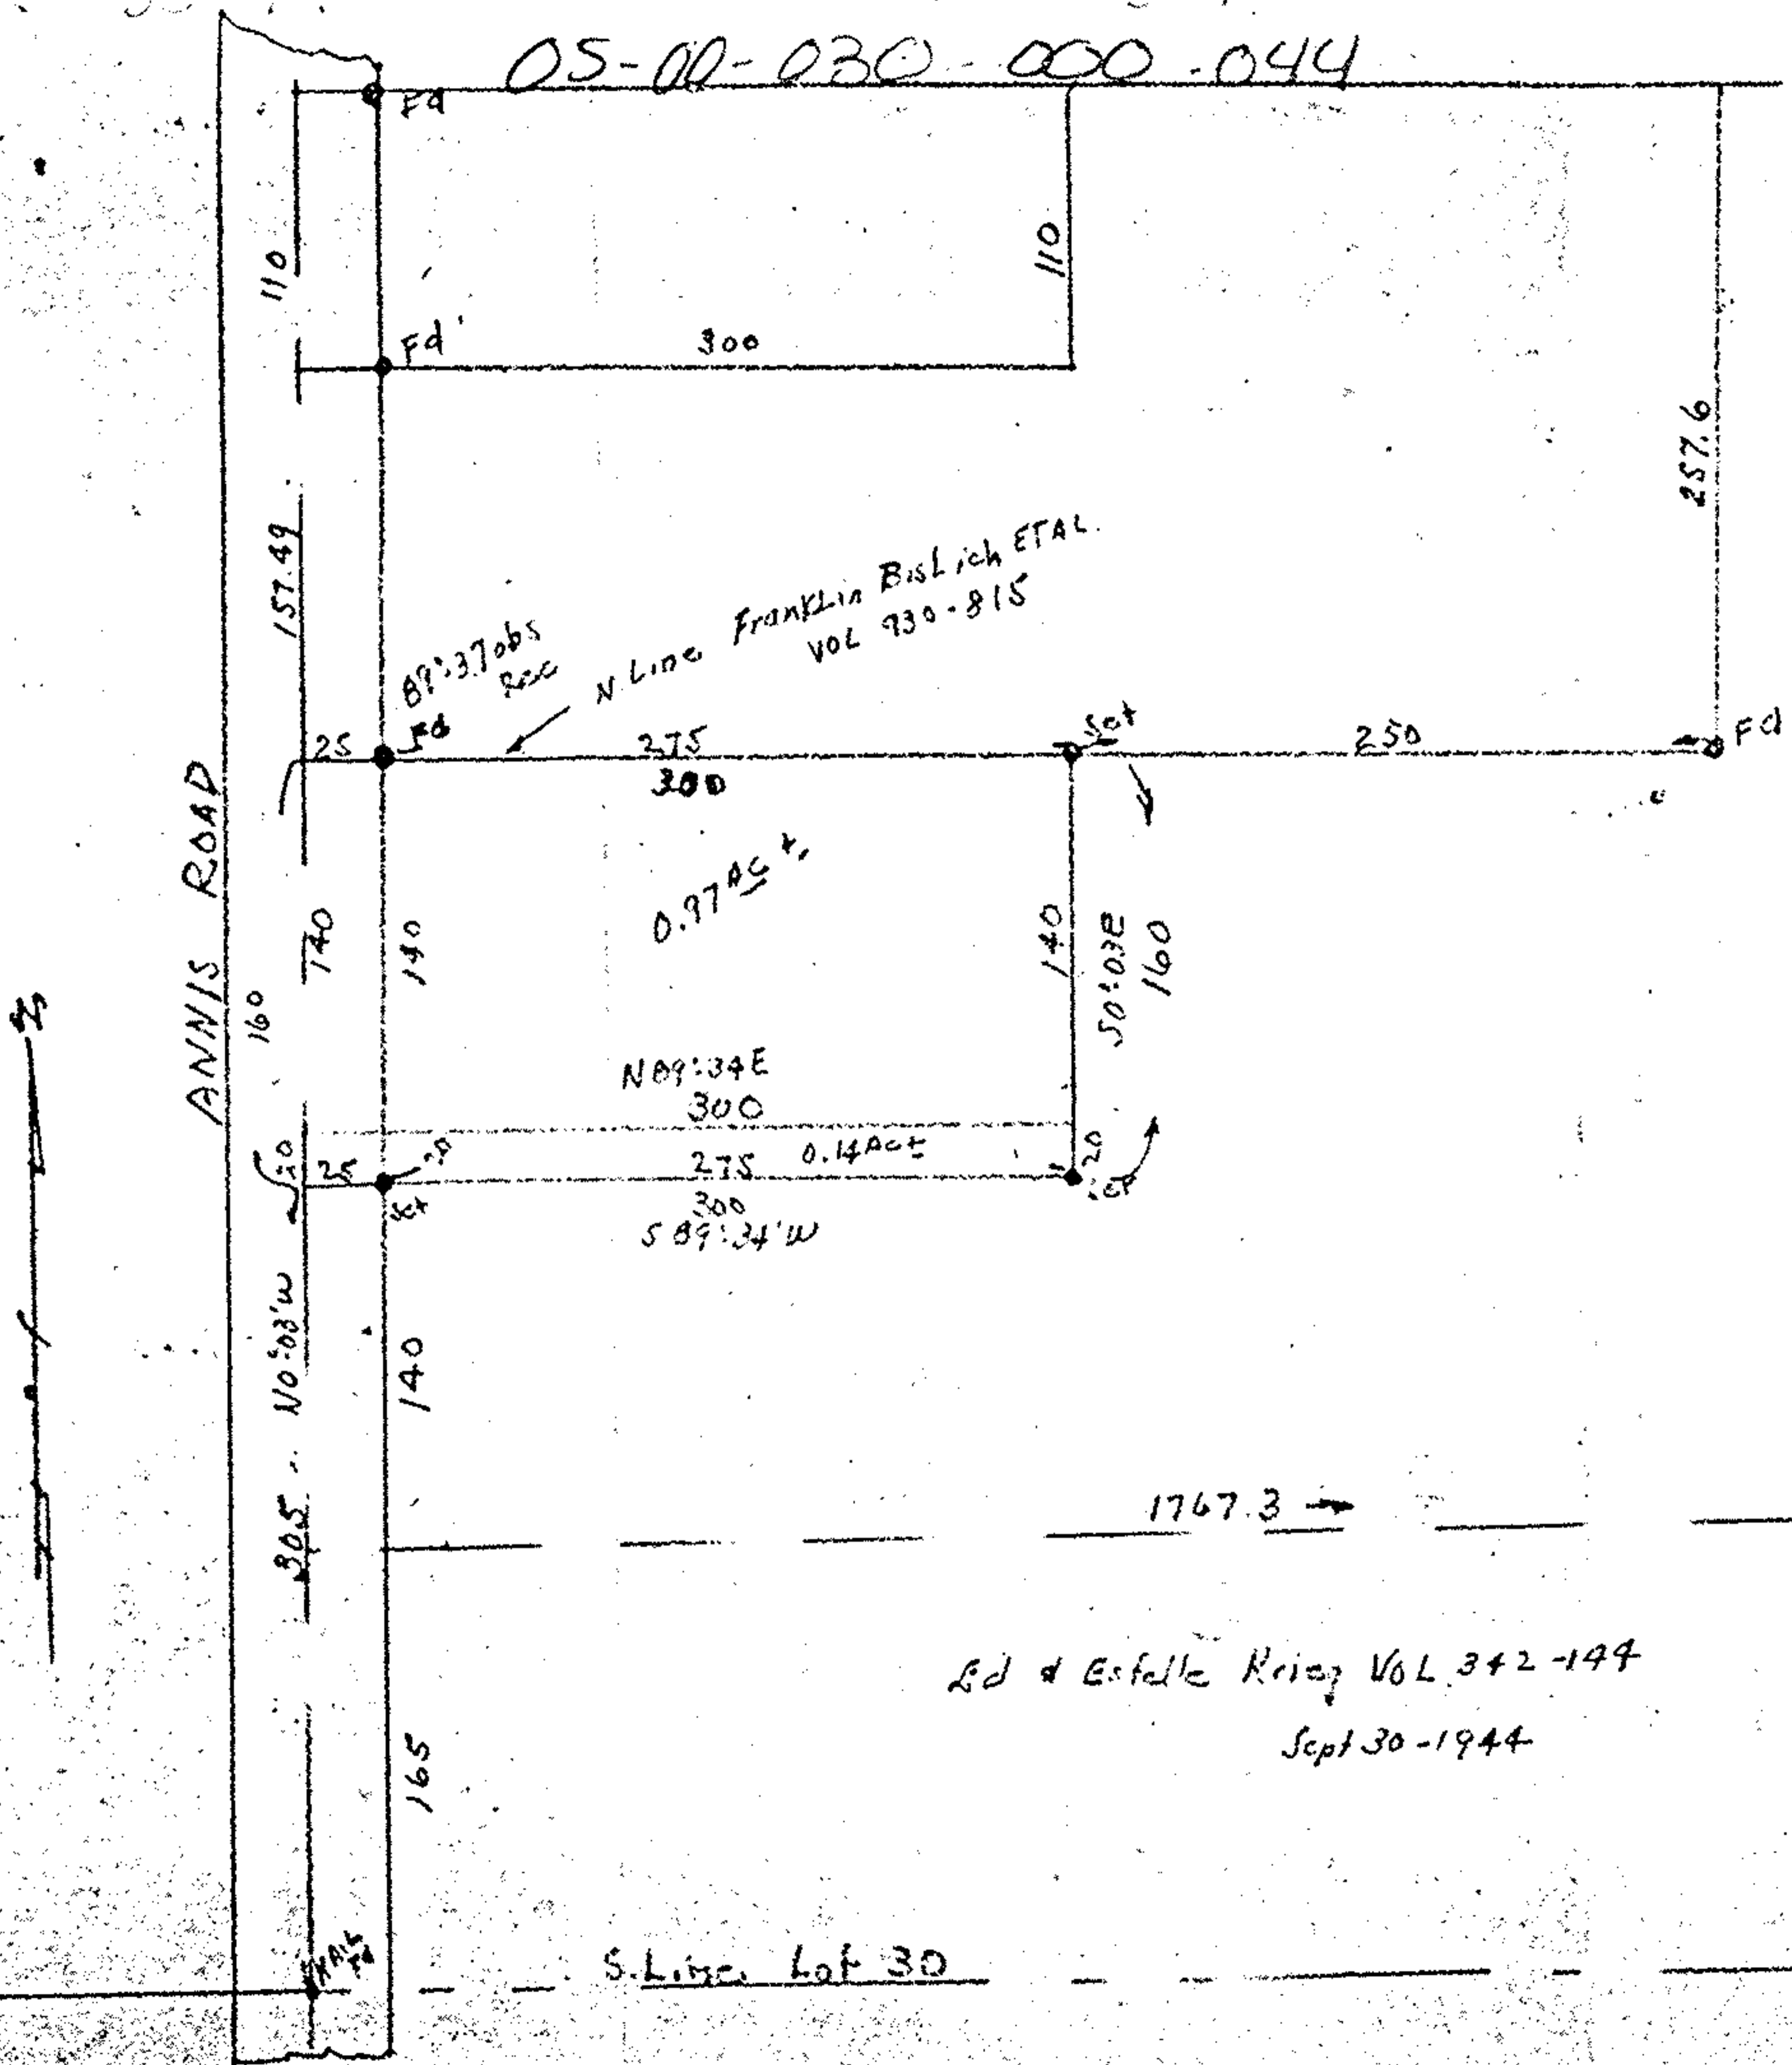

Ed & Estelle Reisz VOL 342-144
Sept 30-1944

