


5-G  
5-00-031-B

#17365

05-00-051-000  
050

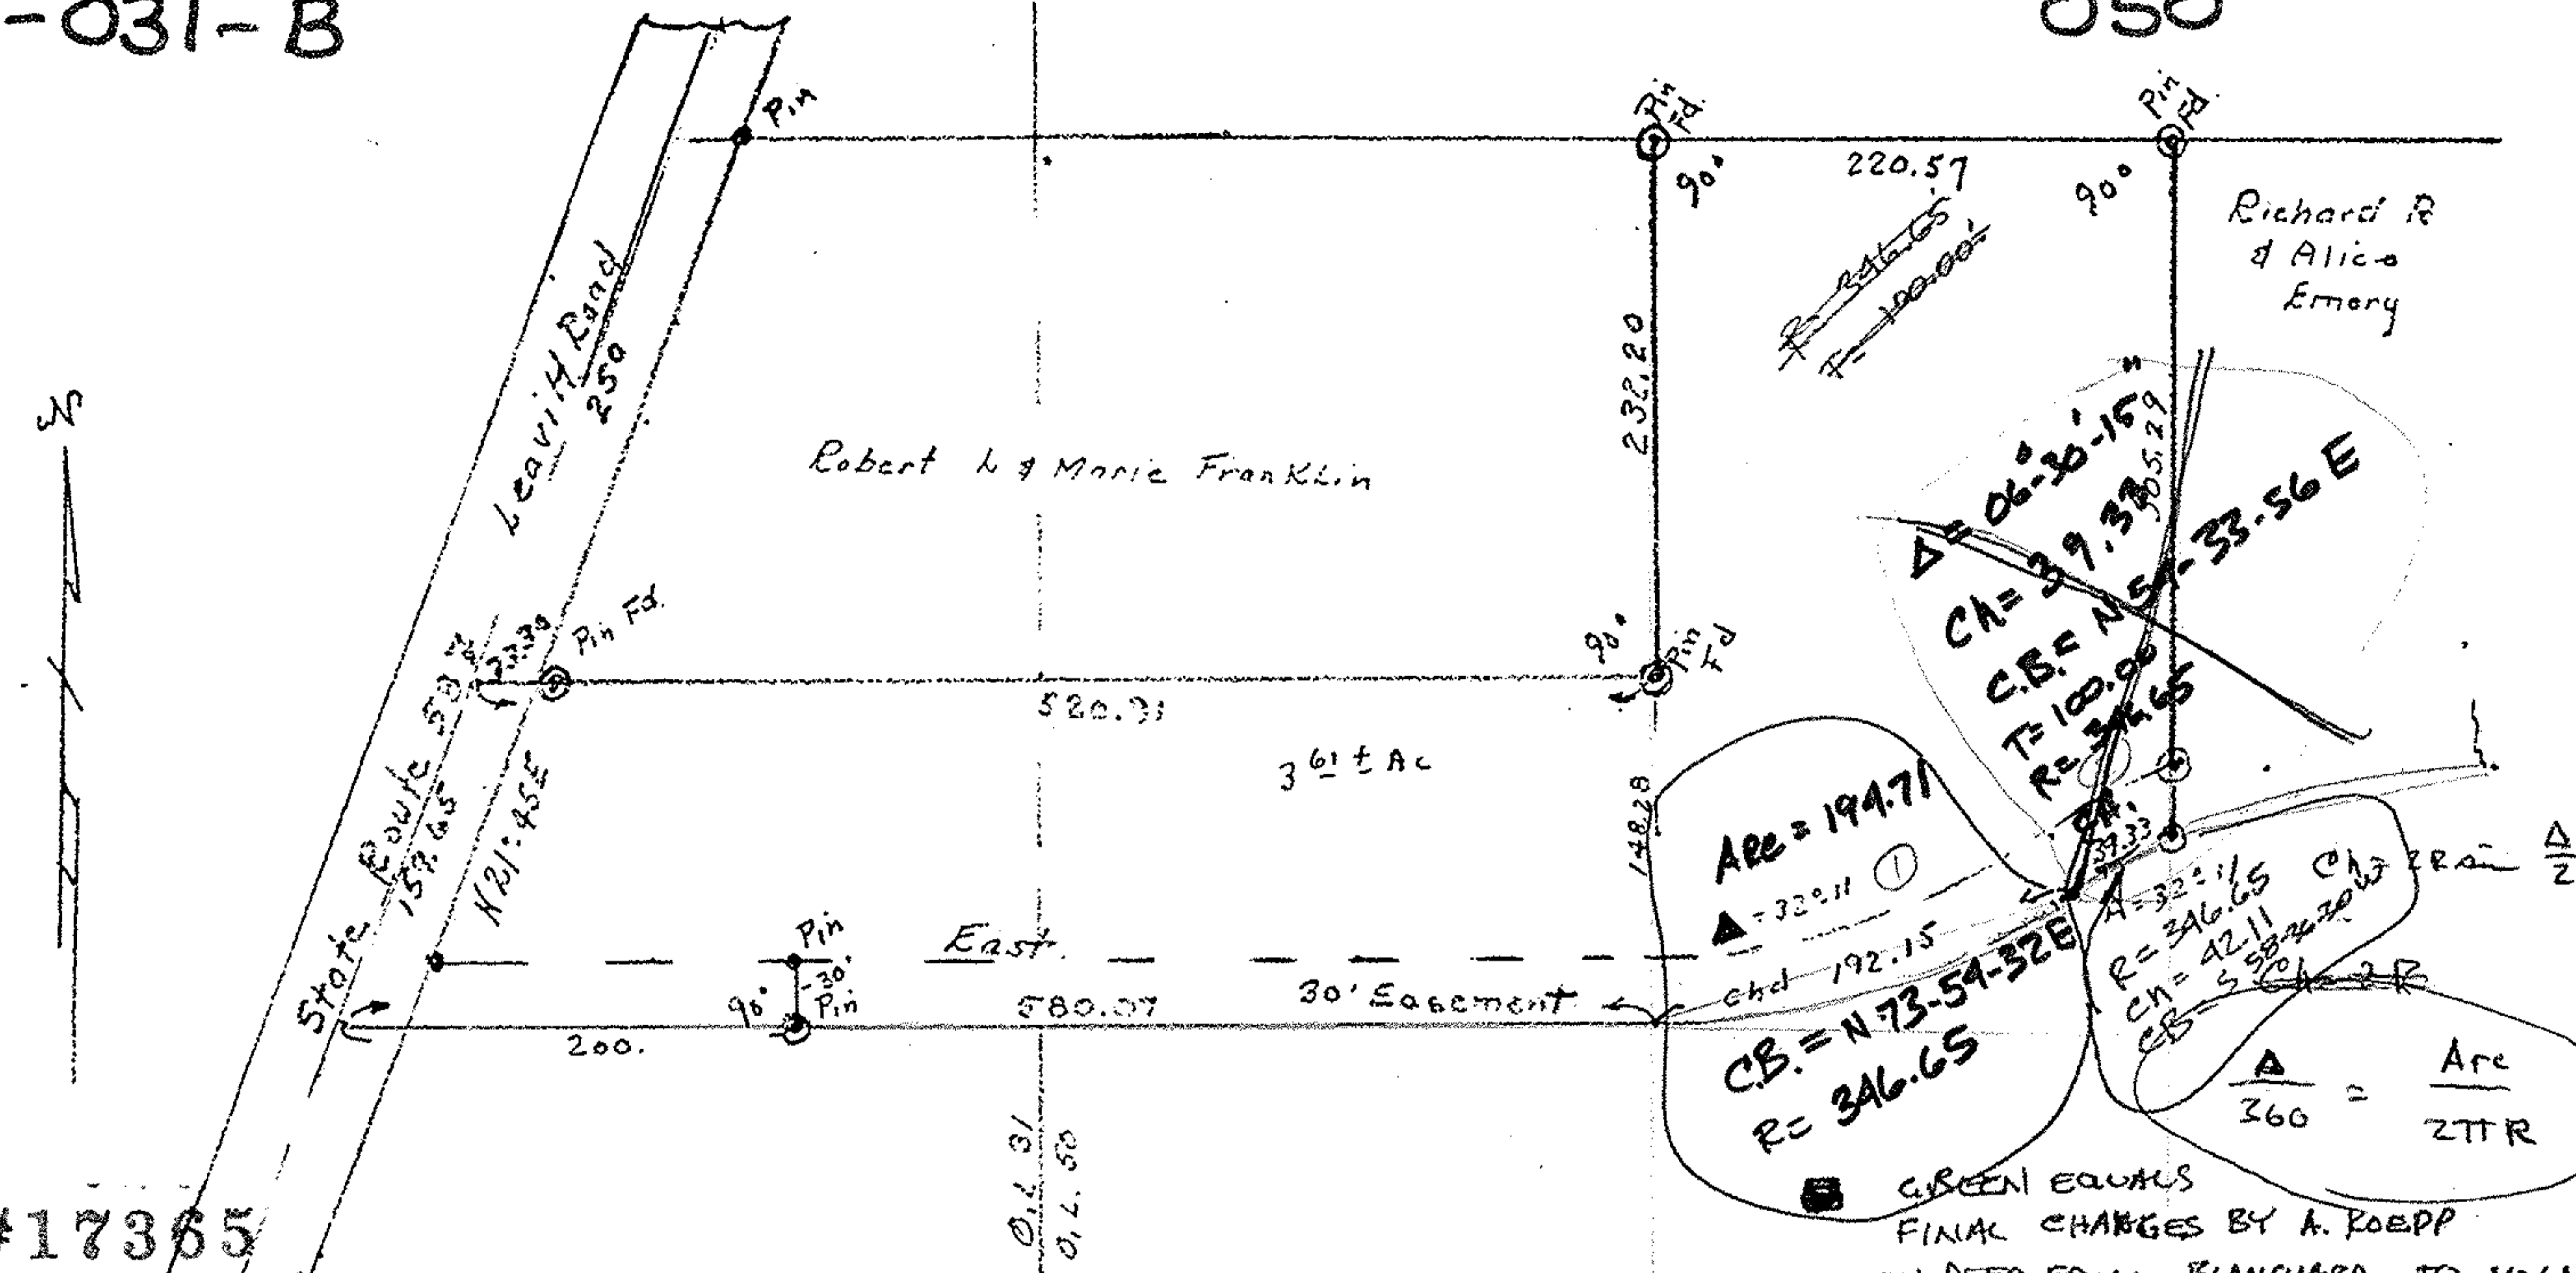

#17365

APPROVED  
LORAIN CO  
MAP DEPT.

DATE 4/8/87

PAGE 5-G & 5-00-031-B

BY T. McMan

VOID AFTER

SURVEY PARTS OF ORIGINAL LOTS 31 & 50 AMHERST TWP.  
LORAIN CO. OHIO SCALE 1"=100' OCT. 1972  
BY A.F. KOEPP REGISTERED SURVEYOR

IRON PINS FOUND

① Ch = 192.15 CB S57-49-00W

② ~~Ch = 29.33~~ CHANGE TO Ch = 63.35  
CB S66-18-30W

05-00-050-000-014,003