

05-00-051-000-000

Steve Bara
Pl. Vol 702 Pg 287

Corwin Burrell
ET AL

Pl. Vol 906 Pg 202

62.364 acres
Remainder


o Iron pipe set
□ MB fd

John Poznywak
Reg Surveyor
5292

Survey for Corwin Burrell

ORIGINAL LOT	<u>51</u>	DATE	<u>June 5, 1990</u>
TOWNSHIP	<u>Ambers</u>	SCALE	<u>1" = 200</u>
CITY OF	_____	FIELD BOOK	_____
COUNTY OF	<u>Lorain</u>	DRAWN BY	_____
STATE OF	<u>OHIO</u>	CHECKED BY	_____
W. O.	_____	FILE NO.	<u>5-00-051</u>

05-00-051-000-008 RECEIVED

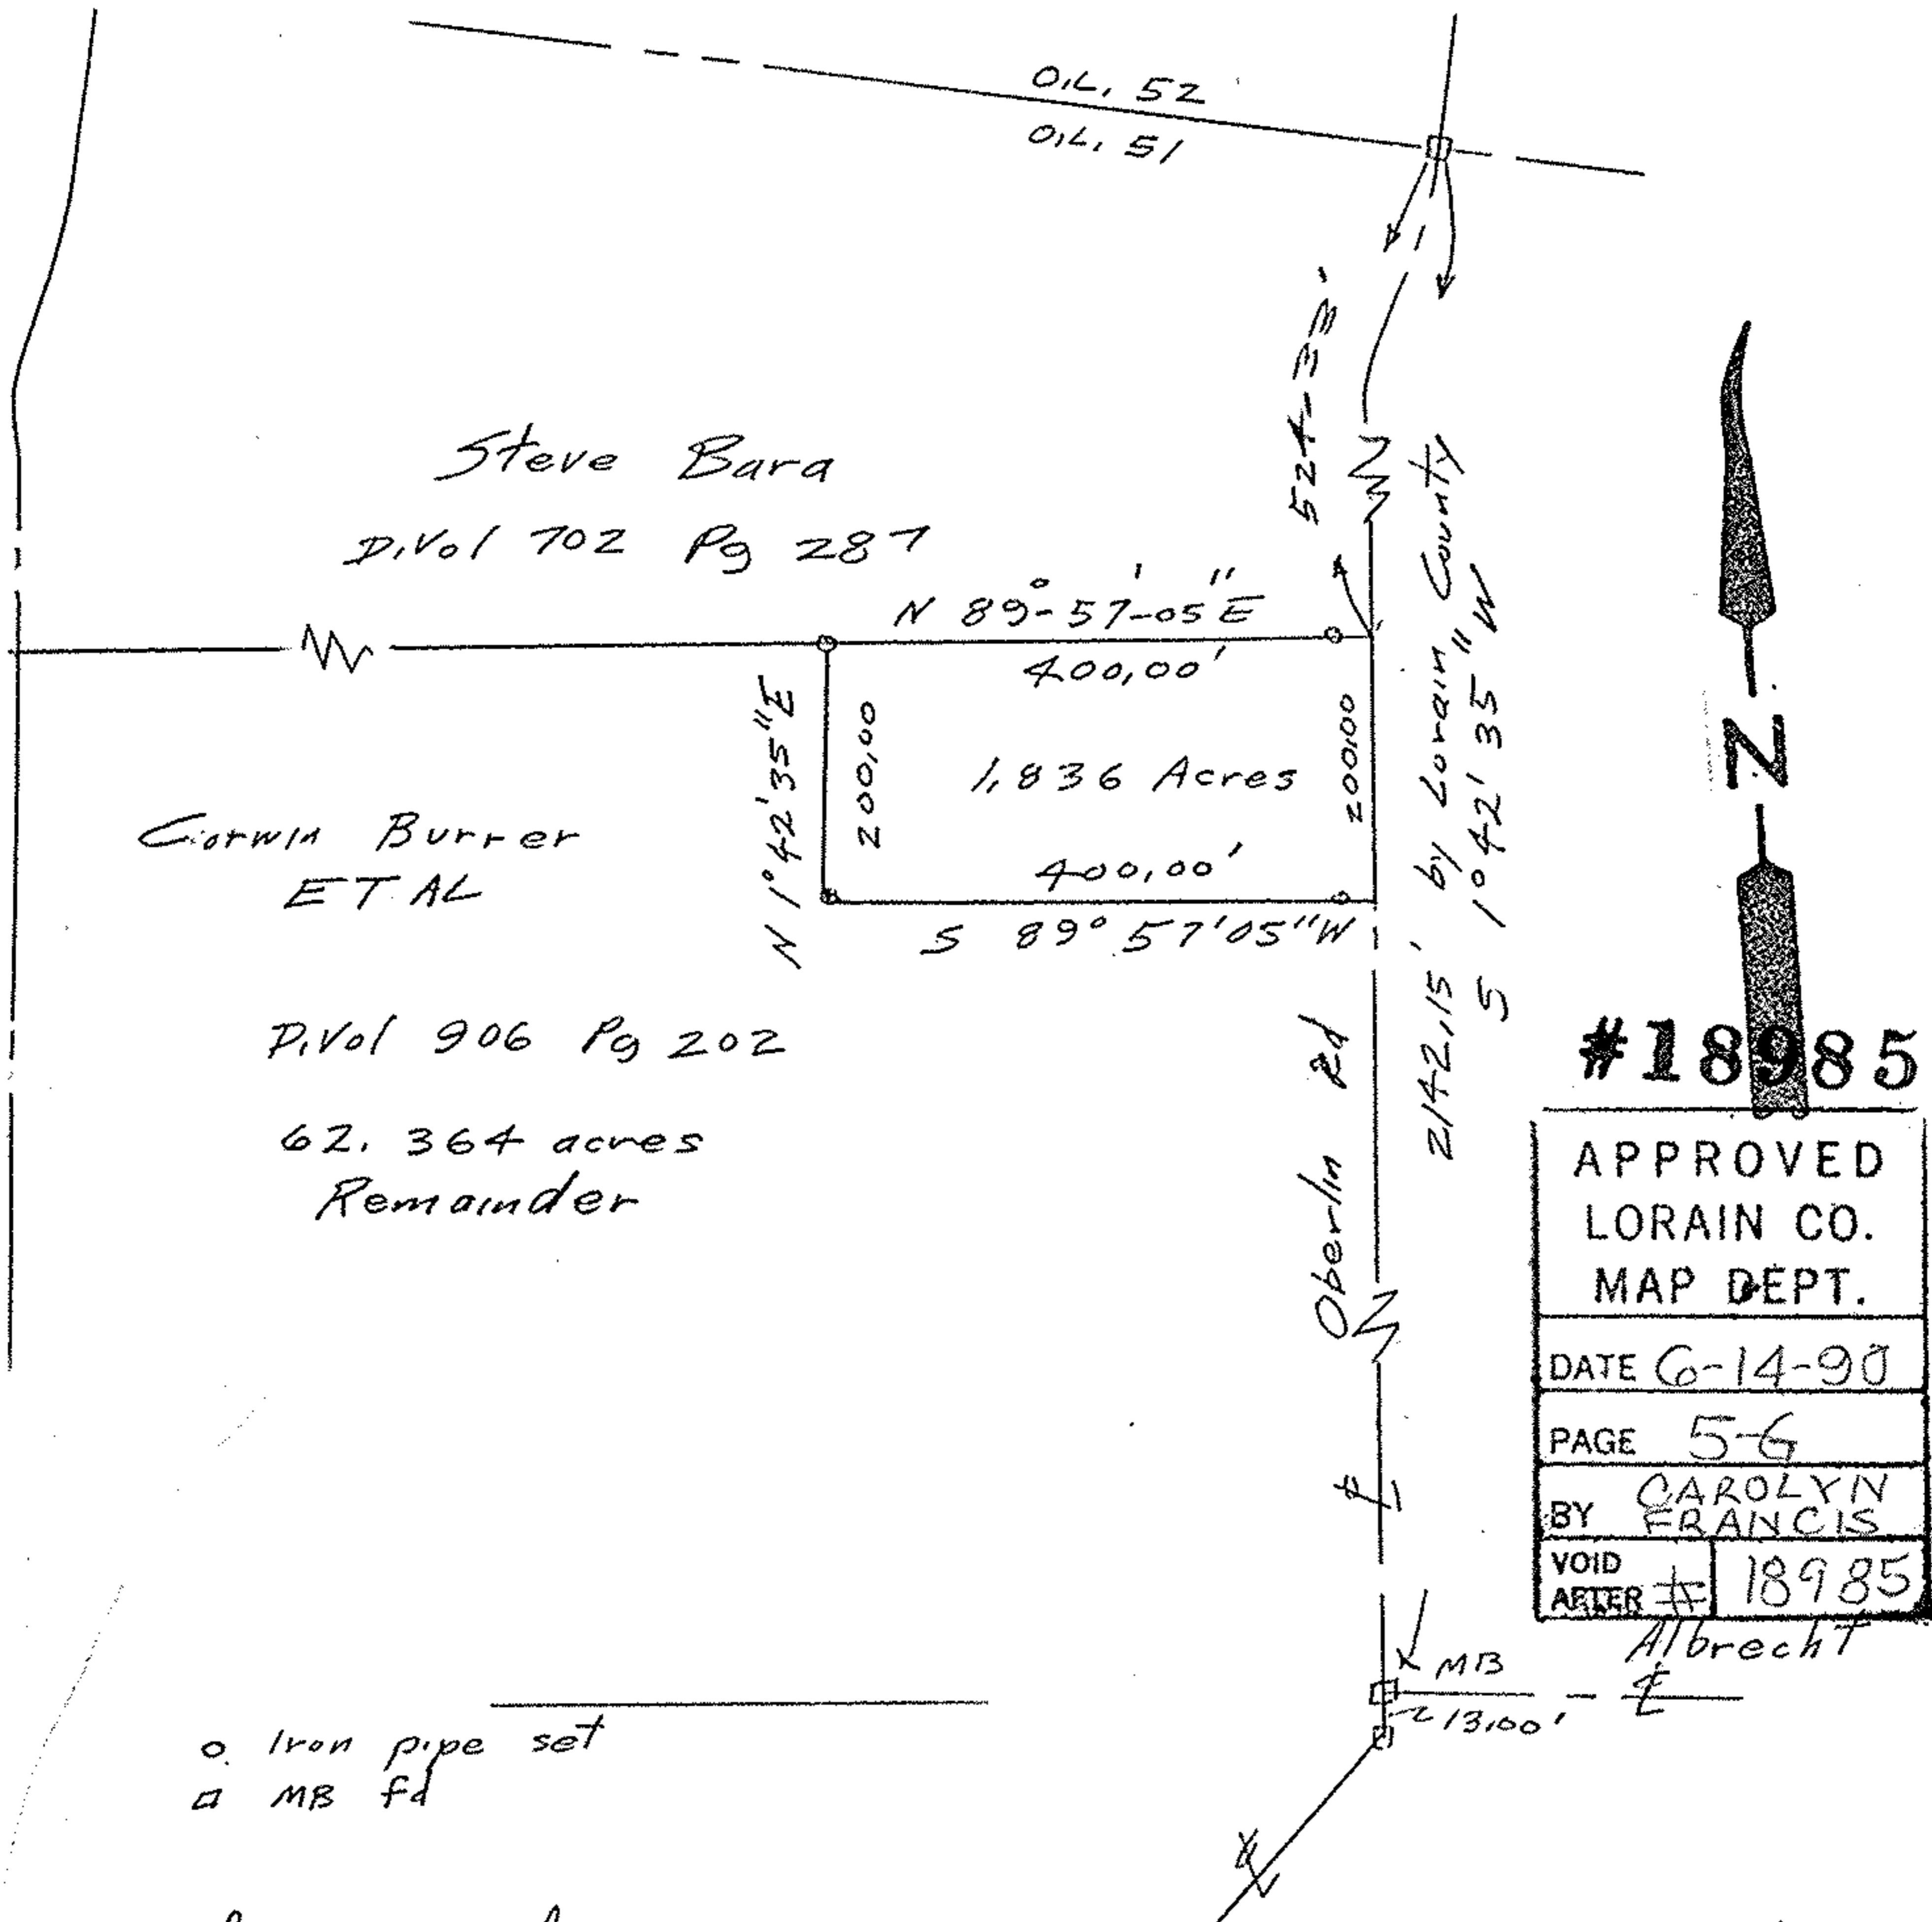

#18985

APPROVED LORAIN CO. MAP DEPT.	
DATE <u>6-14-90</u>	
PAGE <u>5-6</u>	
BY <u>CAROLYN FRANCIS</u>	
VOID ARTER	# <u>18985</u>

Albrecht