


05-00-051-00

#18985

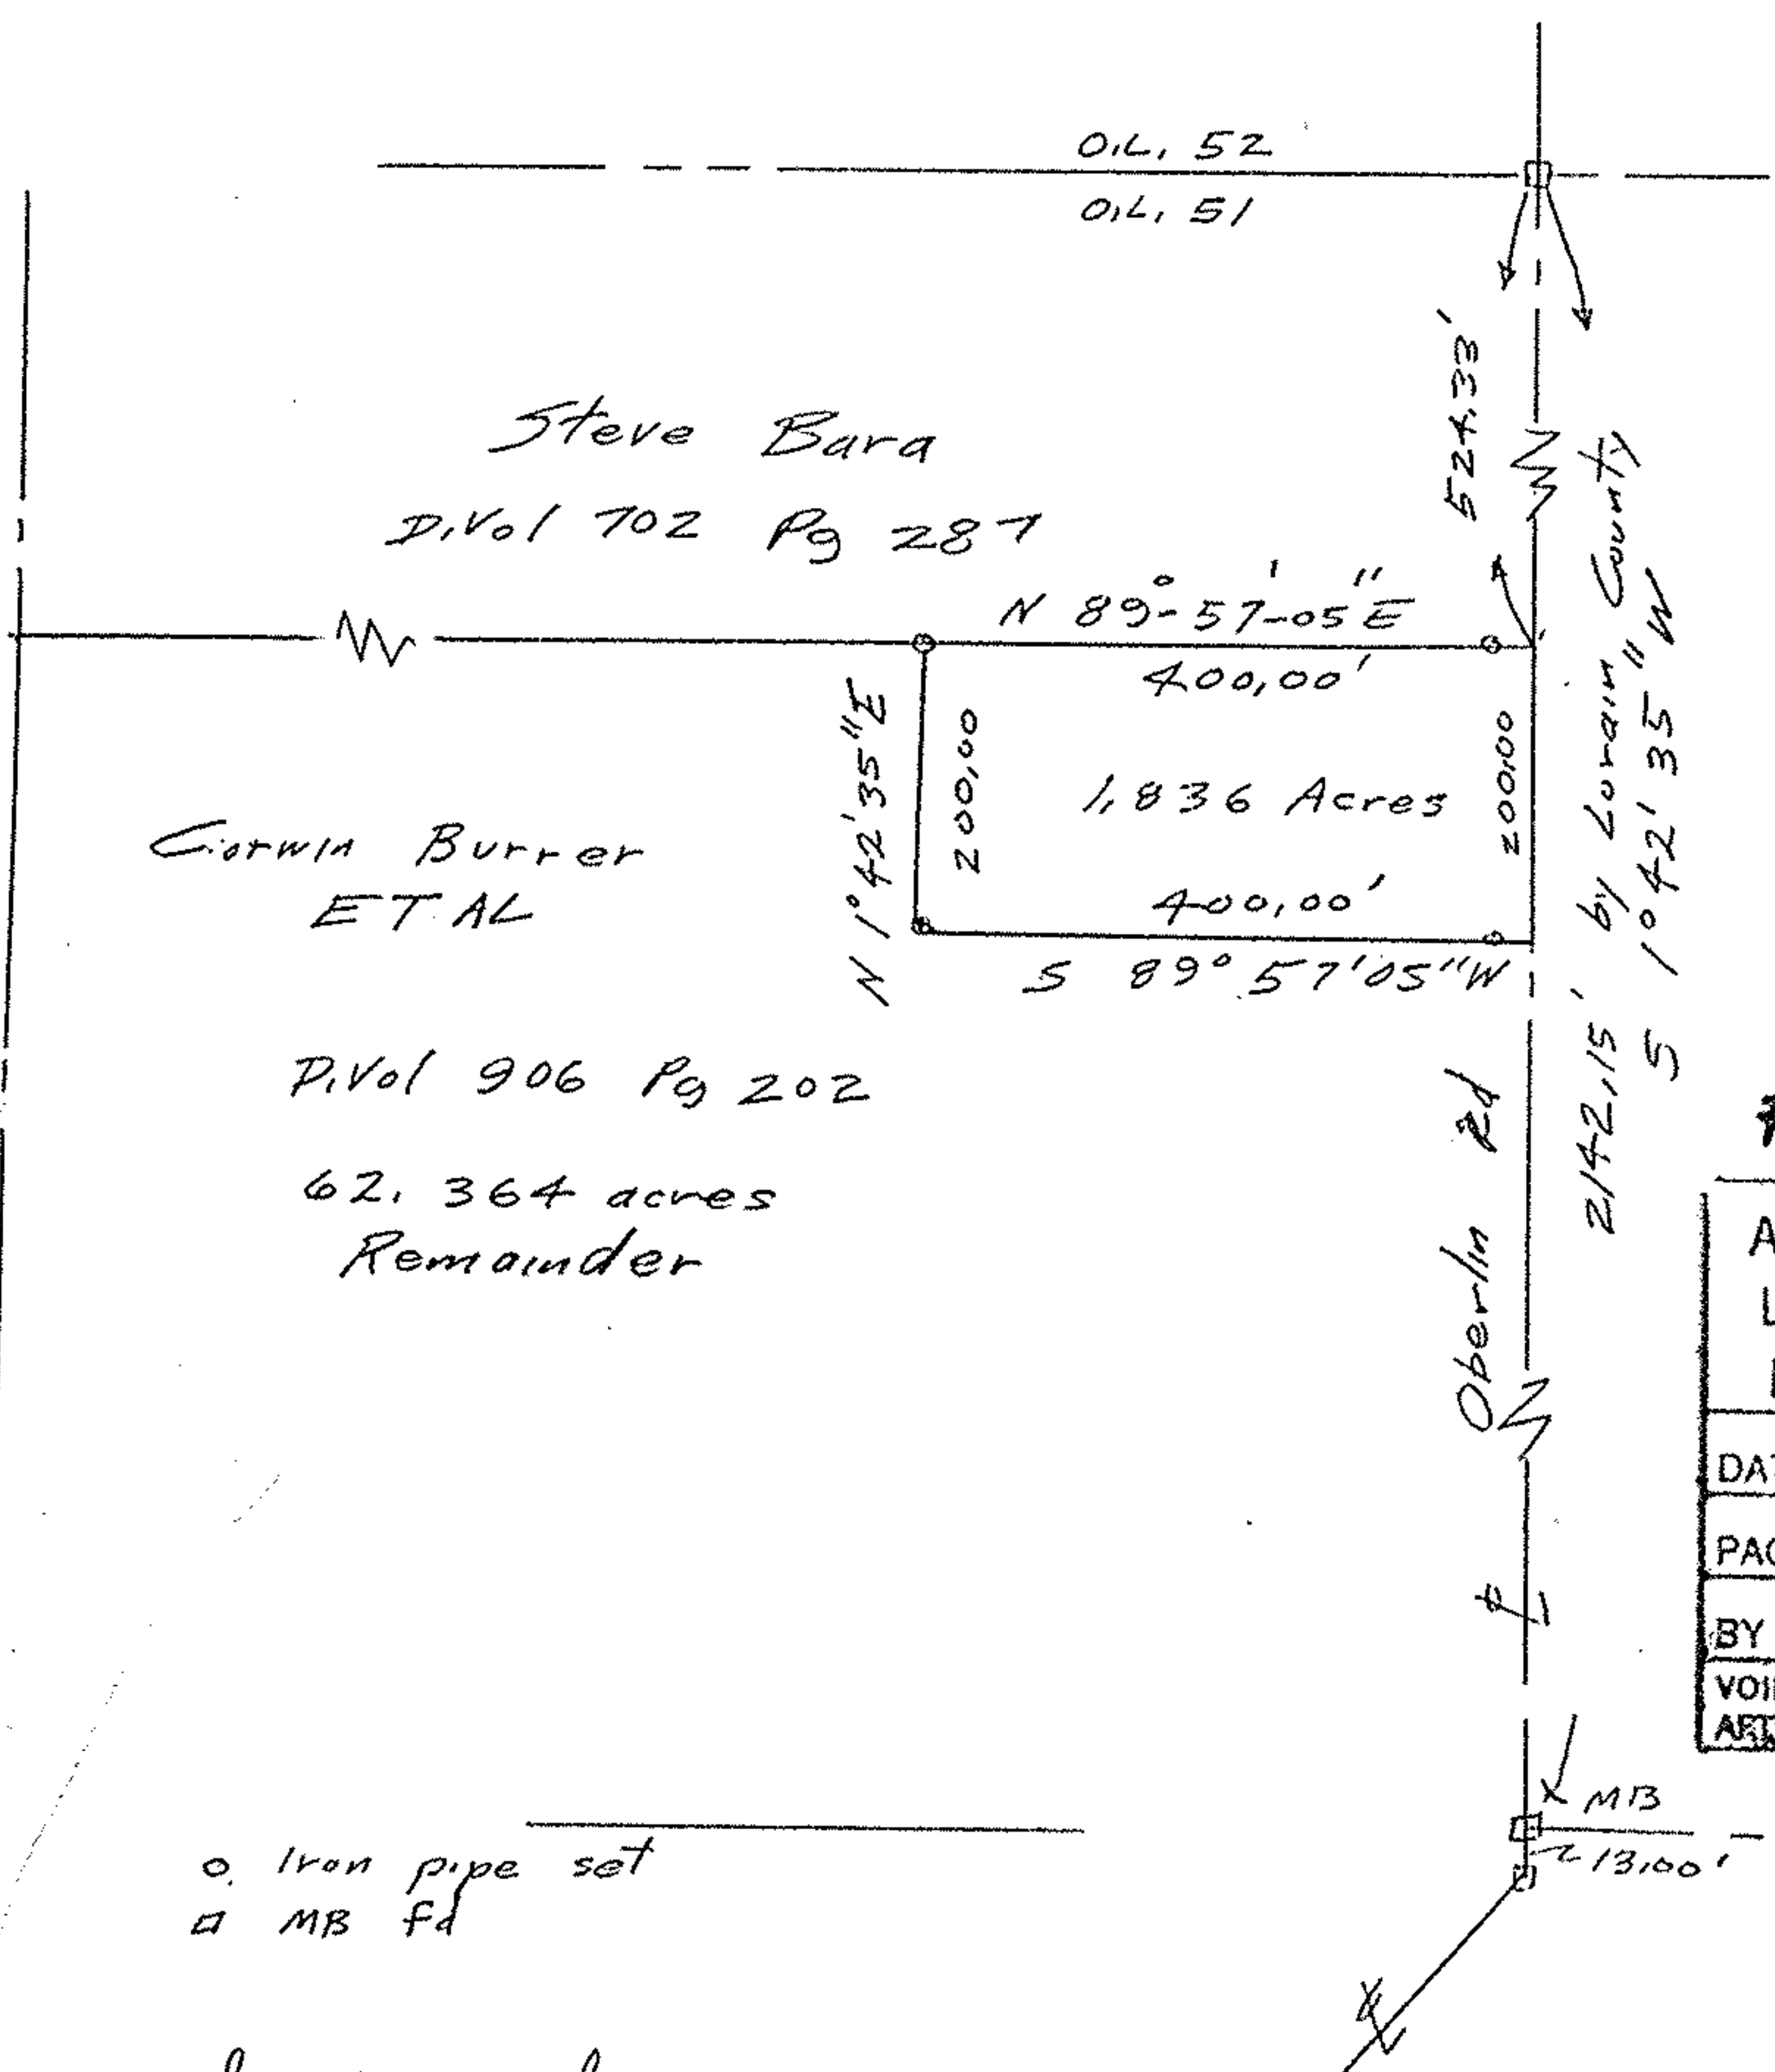

Steve Bara
 D. Vol 702 Pg 287

Corwin Burrer
 ET AL

D. Vol 906 Pg 202
 62,364 acres
 Remainder

o. Iron pipe set
 □ MB fd

#18985

APPROVED LORAIN CO. MAP DEPT.	
DATE 6-14-90	
PAGE 5-6	
BY CAROLYN FRANCIS	
VOID AFTER	# 18985

Albrecht

John Poznywak
 Reg Surveyor
 5292

Survey for Corwin Burrer

ORIGINAL LOT	<u>51</u>	DATE	<u>June 5, 1990</u>
TOWNSHIP	<u>Amherst</u>	SCALE	<u>1" = 200</u>
CITY OF	_____	FIELD BOOK	_____
COUNTY OF	<u>Lorain</u>	DRAWN BY	_____
STATE OF	<u>OHIO</u>	CHECKED BY	_____
W. O.	_____	FILE NO.	<u>5-00-051</u>

05-00-051-000-018