



ROCK CREEK TWP (containing)

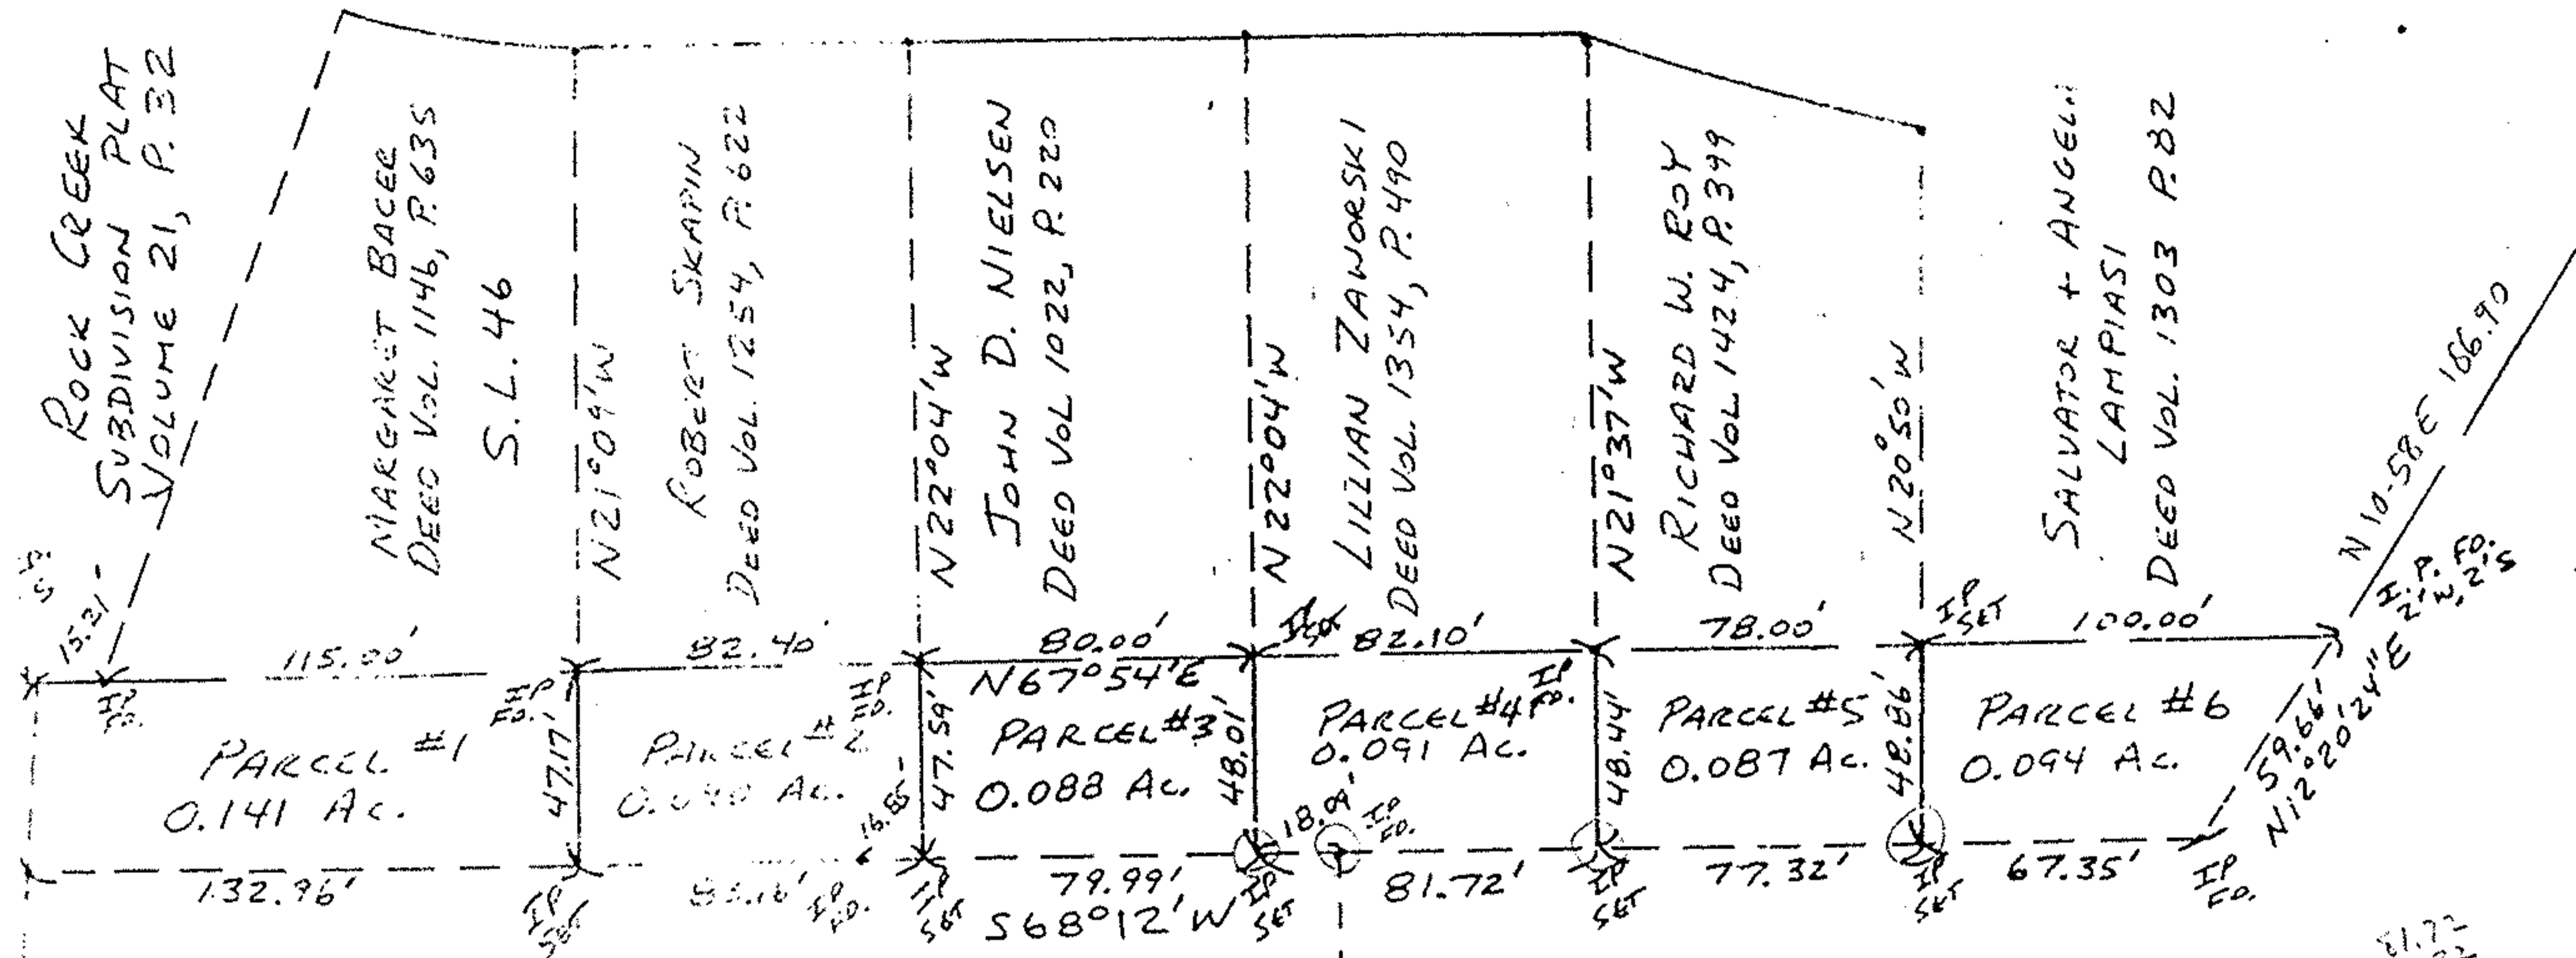

JOSEPH R. + ROBERT RAPOSE DEED VOL. 1254, P. 11

BURTON J. + MARILYN A. JENNE DEED VOL. 1329 P. 696

JOHN D. NIELSEN DEED VOL. 100, P. 505

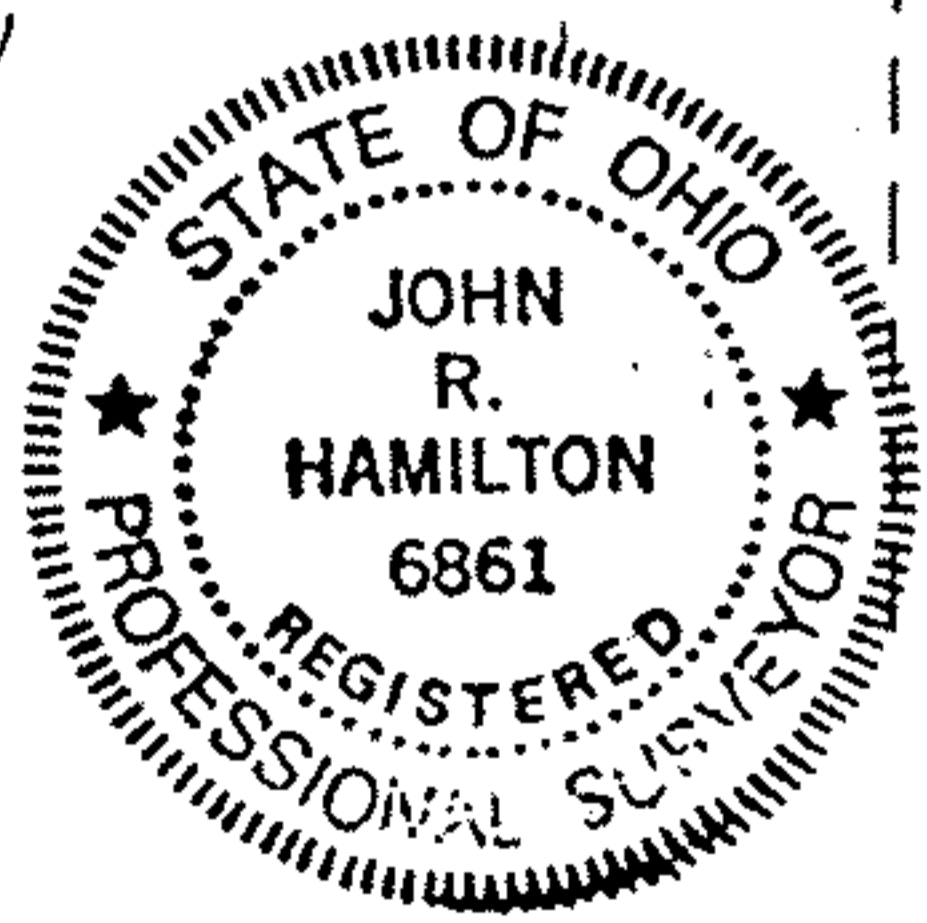

|                            |               |
|----------------------------|---------------|
| P.P. No. 05-00-042-000-028 | .18 AC. ORIG. |
| PARCEL #1 SPLIT            | .141 AC.      |
| PART OF PARCEL #2 SPLIT    | .039 AC.      |
|                            | 0 REM.        |
| P.P. No. 05-00-042-000-027 | .95 AC. ORIG. |
| PART OF PARCEL #2 SPLIT    | .051          |
| PARCELS #3-#6 SPLIT        | .36           |
|                            | .539 AC. REM. |

MAP OF SURVEY FOR JOHN NIELSEN  
 AGAINST TWP. - D.L. 42 - LORAIN CO.  
 SCALE 1" = 60'  
 JOHN R. HAMILTON - REG. SURV. # 6861

LORAIN COUNTY MAP DEPT.  
 P. P. No. \_\_\_\_\_

#18243

APPROVED  
 LORAIN CO.  
 MAP DEPT.  
 DATE 12-2-88  
 PAGE 5-00-042-A  
 VOID AFTER # 18243



05-00-042-104-081 -> 084, 029, 041, 049, 051