

86

MAP OF SUB-LOT NO. 88

ROCK CREEK SUB'N. Vol. 21 P. 32

ORIG. LOT 42 AMHERST TWP.

AMHERST CITY - LORAIN COUNTY - OHIO

MAY 29-1966 8:15 P.M. SCALE: 1"=30'

Gary E. Penfound
for C.E. Penfound


REG. SURVEYORS

89


88

87

05-00-042-102-022

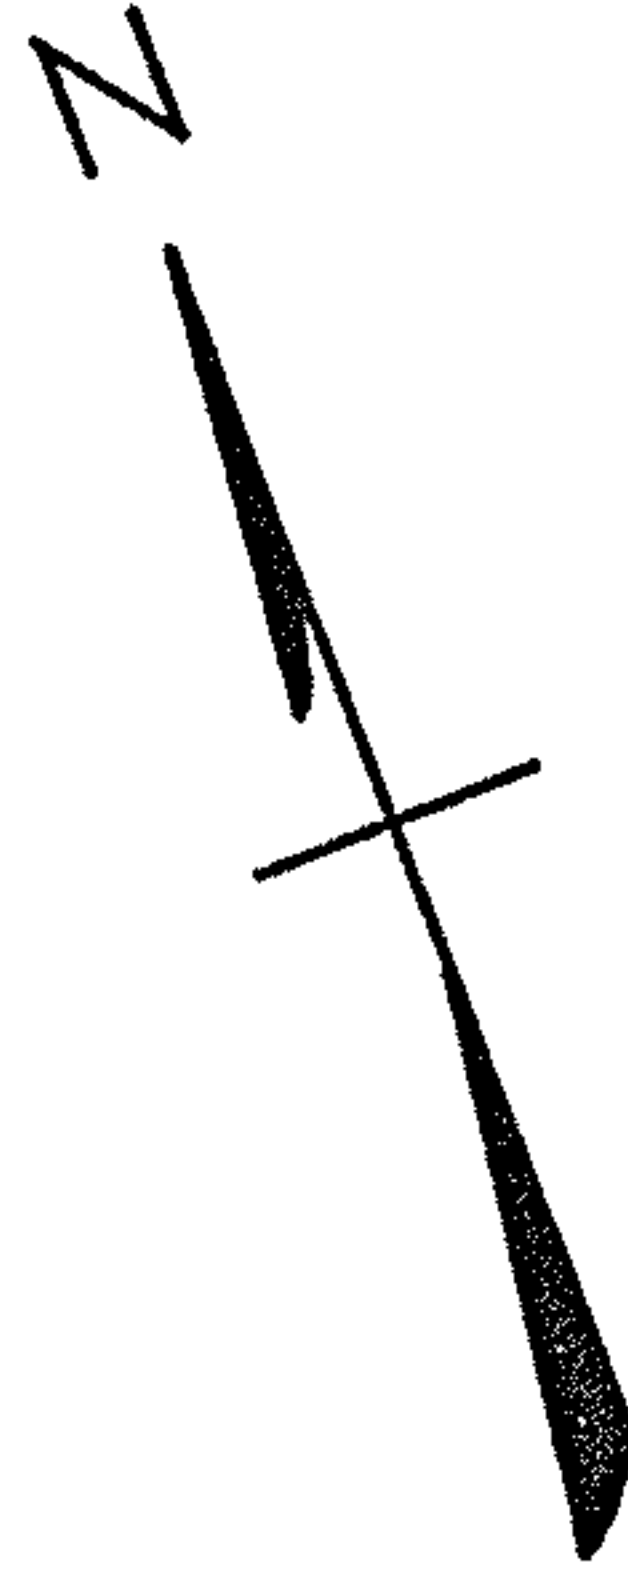

E-14511 Elmer D. & Esther J. Marshall

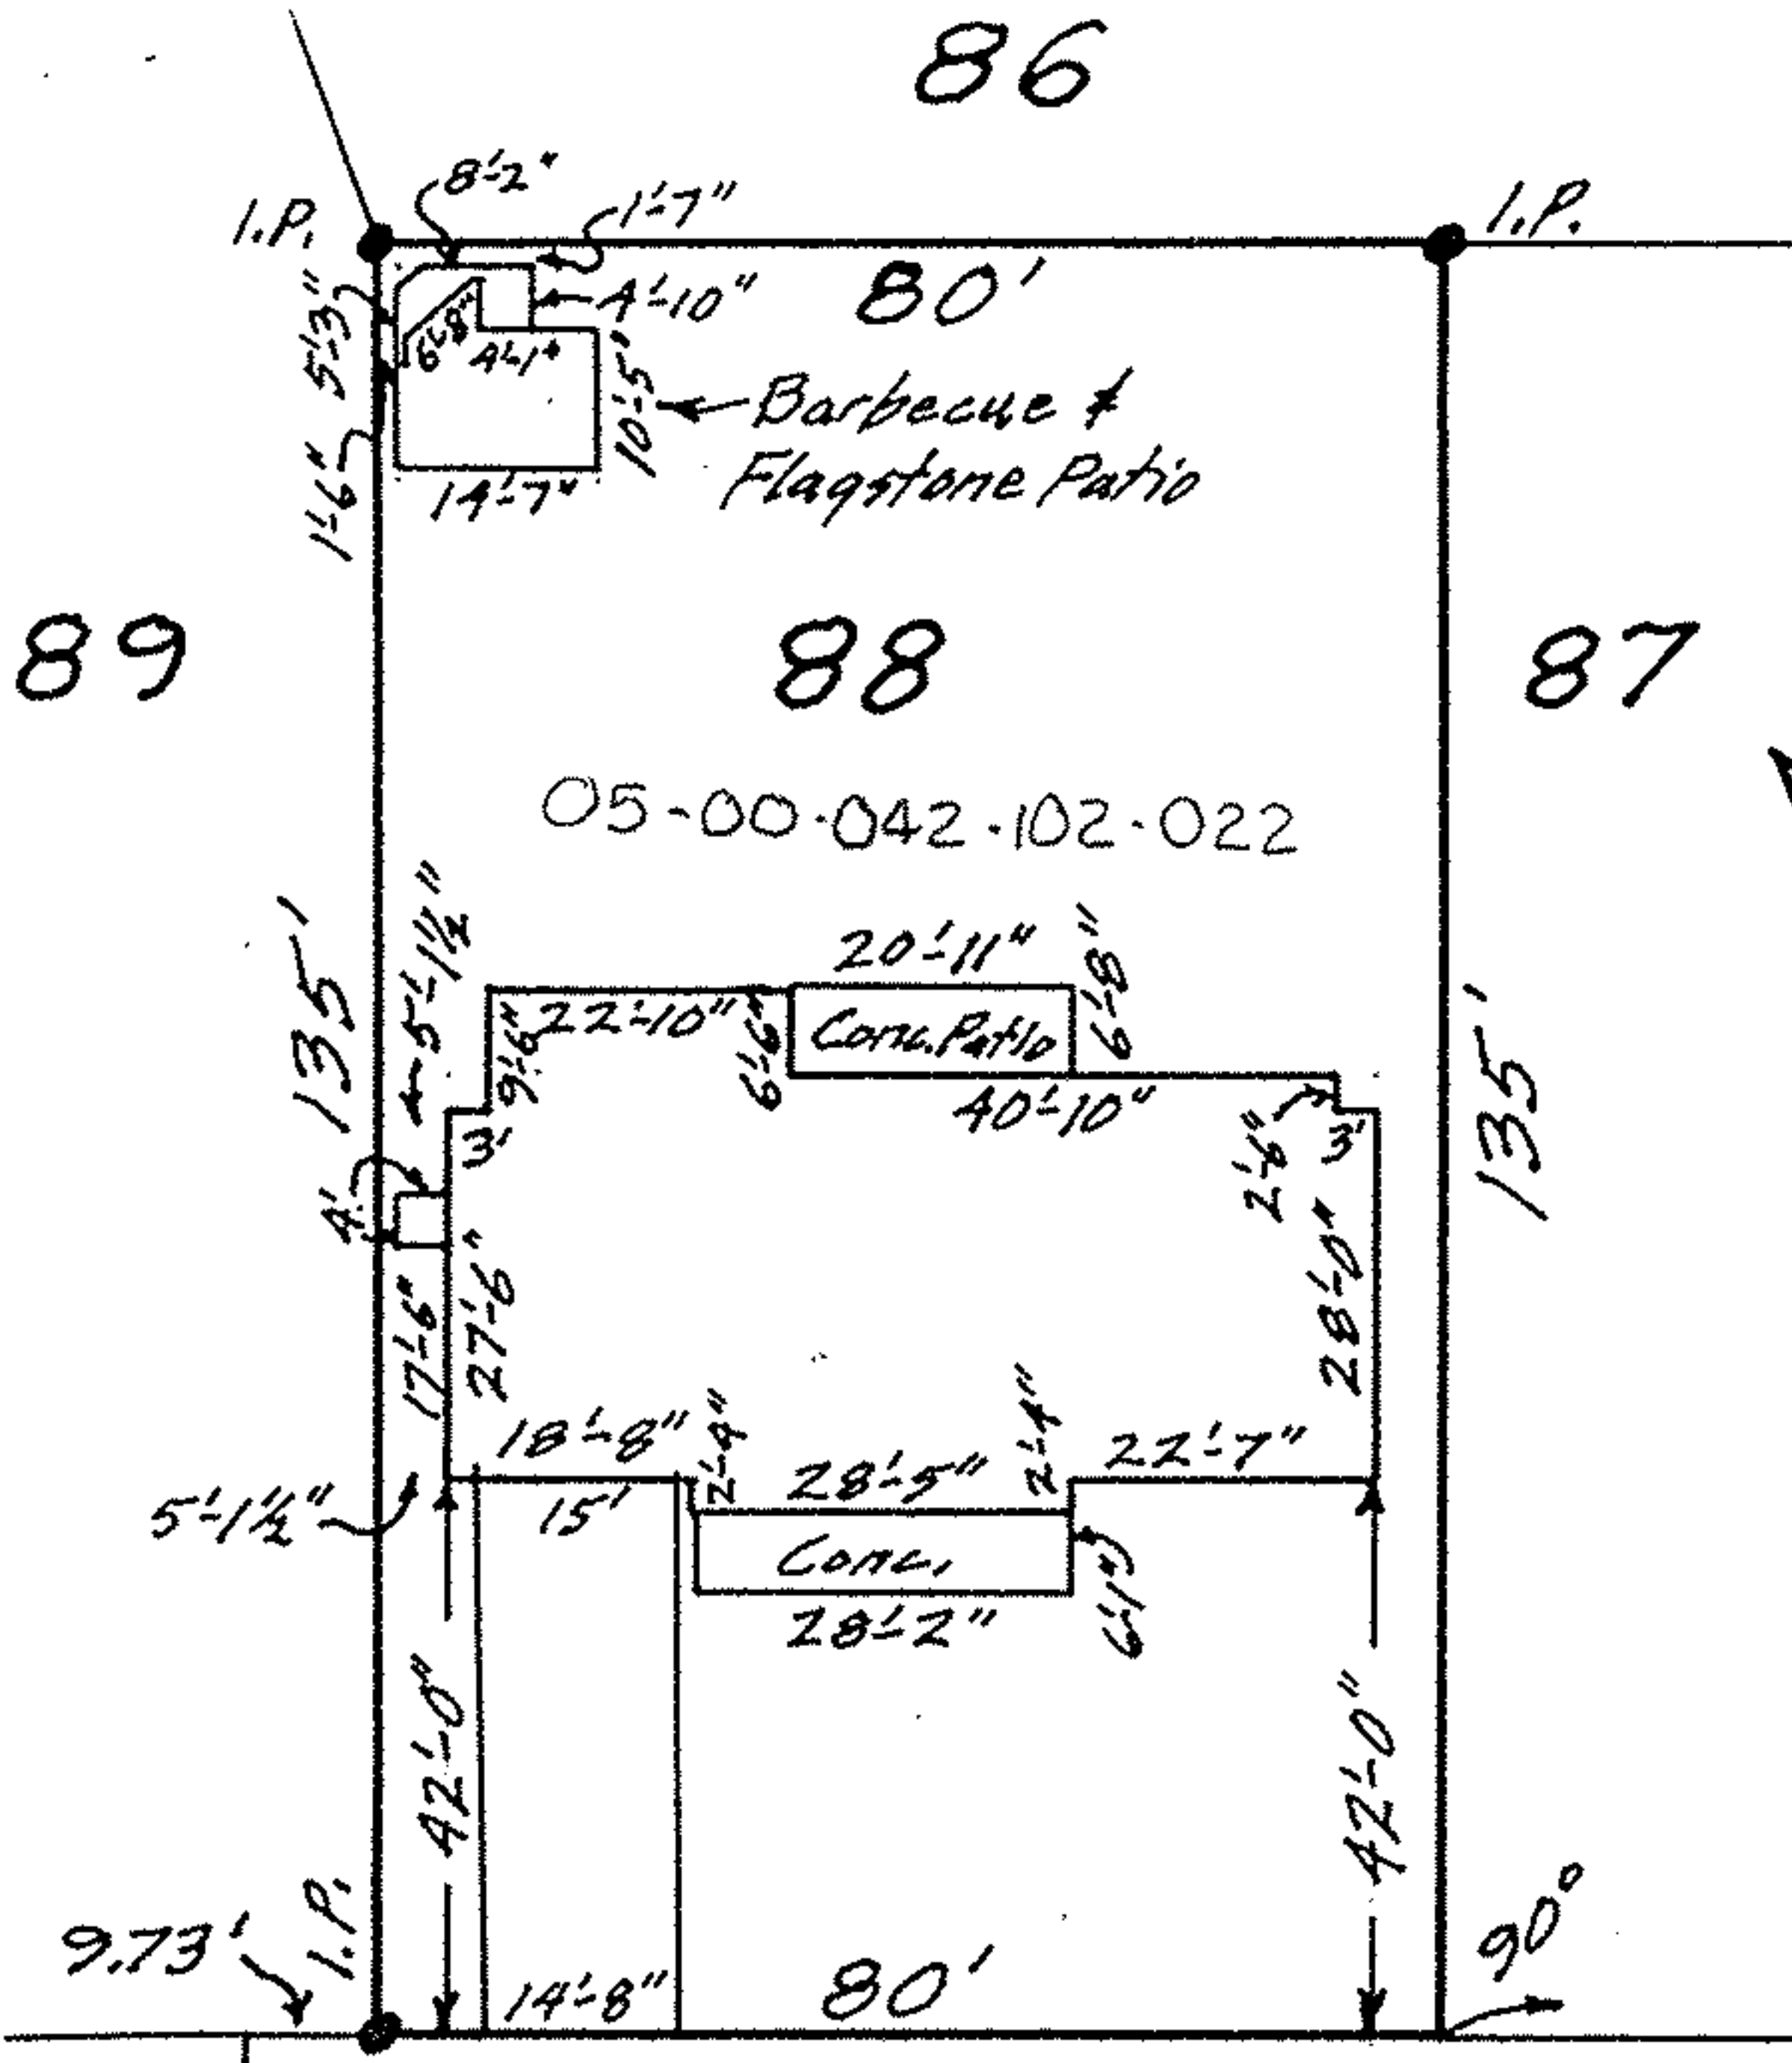

OLD OAK ROAD 60'

N. 68° 34' W.

225.17'

ROCK CREEK RUN
60'

05-00-042-102-022

R=30'