



PARK AVENUE 60'

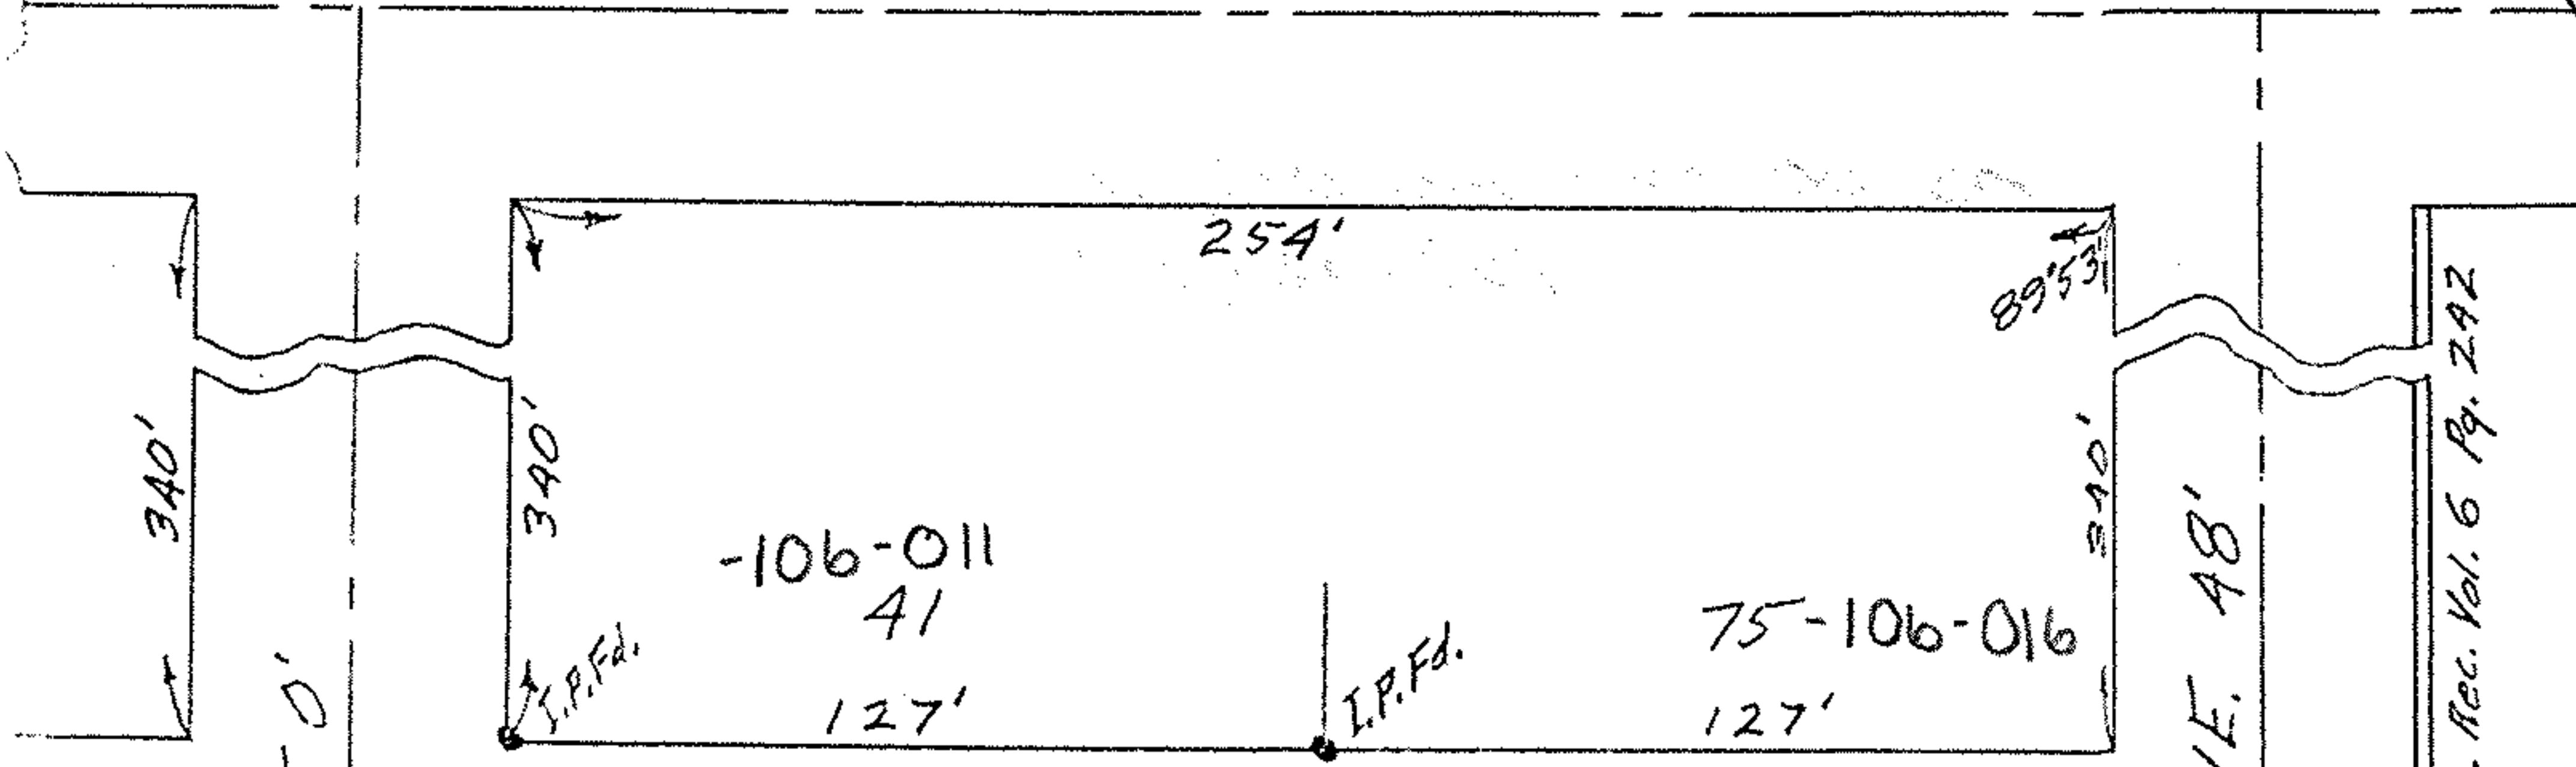

TENNEY ST. 50'

05-00-037-106-109-

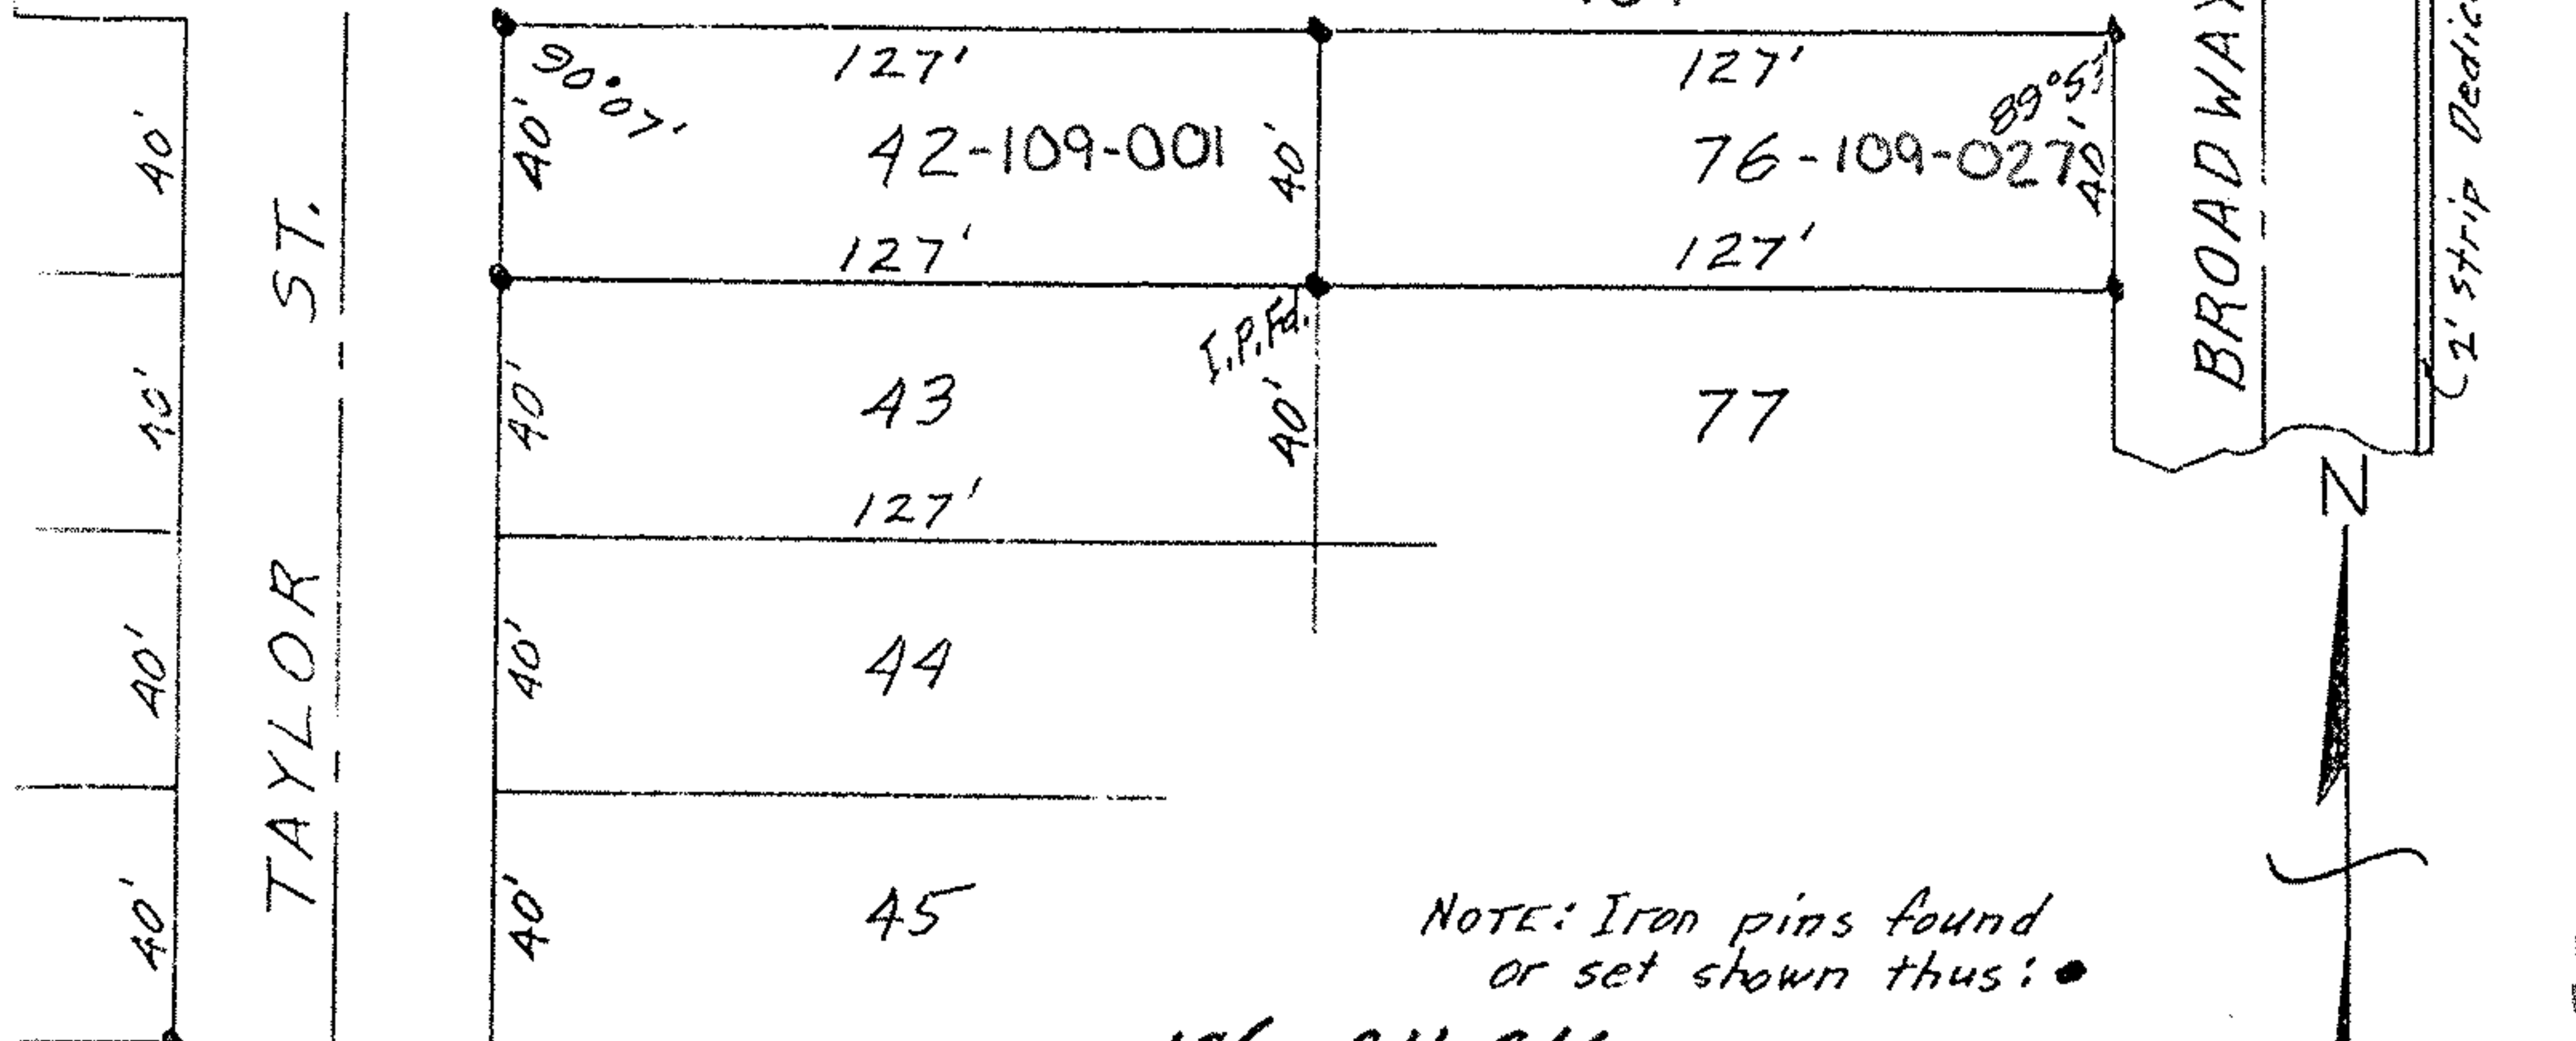

NOTE: Iron pins found or set shown thus: ●

106-011,016
05-00-037-109-027



PLAT OF SURVEY FOR ANNA BENOIT

SUB-LOTS 42 & 76 B.E. TAYLOR'S ADDN.
VOL. 7 PG. 4 LORAIN CO. PLAT RECORDS
ORIGINAL LOT 37 AMHERST TOWNSHIP
LORAIN COUNTY - OHIO

SCALE: 1" = 50' FEBRUARY 10, 1956
C.E. Penfound Registered Surveyor



2' Strip Dedicated Mix. Rec. Vol. 6 Pg. 292

05-00-037