

Monuments were set or found as
Distances are given in feet and
all of which I certify to be co



NORTH RIDGE ROAD 60'

OBERLIN ROAD 60'

#13322

John A. Bambeck
John A.
Regist

APPROVED
LORAIN CO.
MAP DEPT.
DATE 1-2-80
PAGE 5-00-060-B
BY T. M. Hair
VOID AFTER

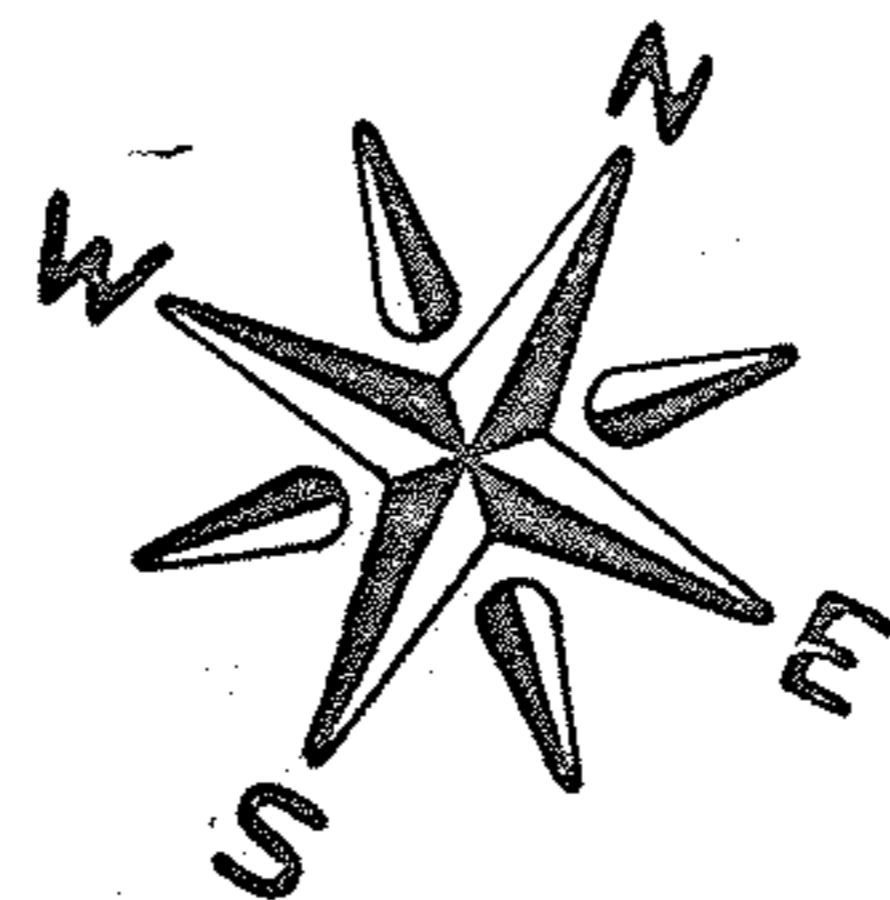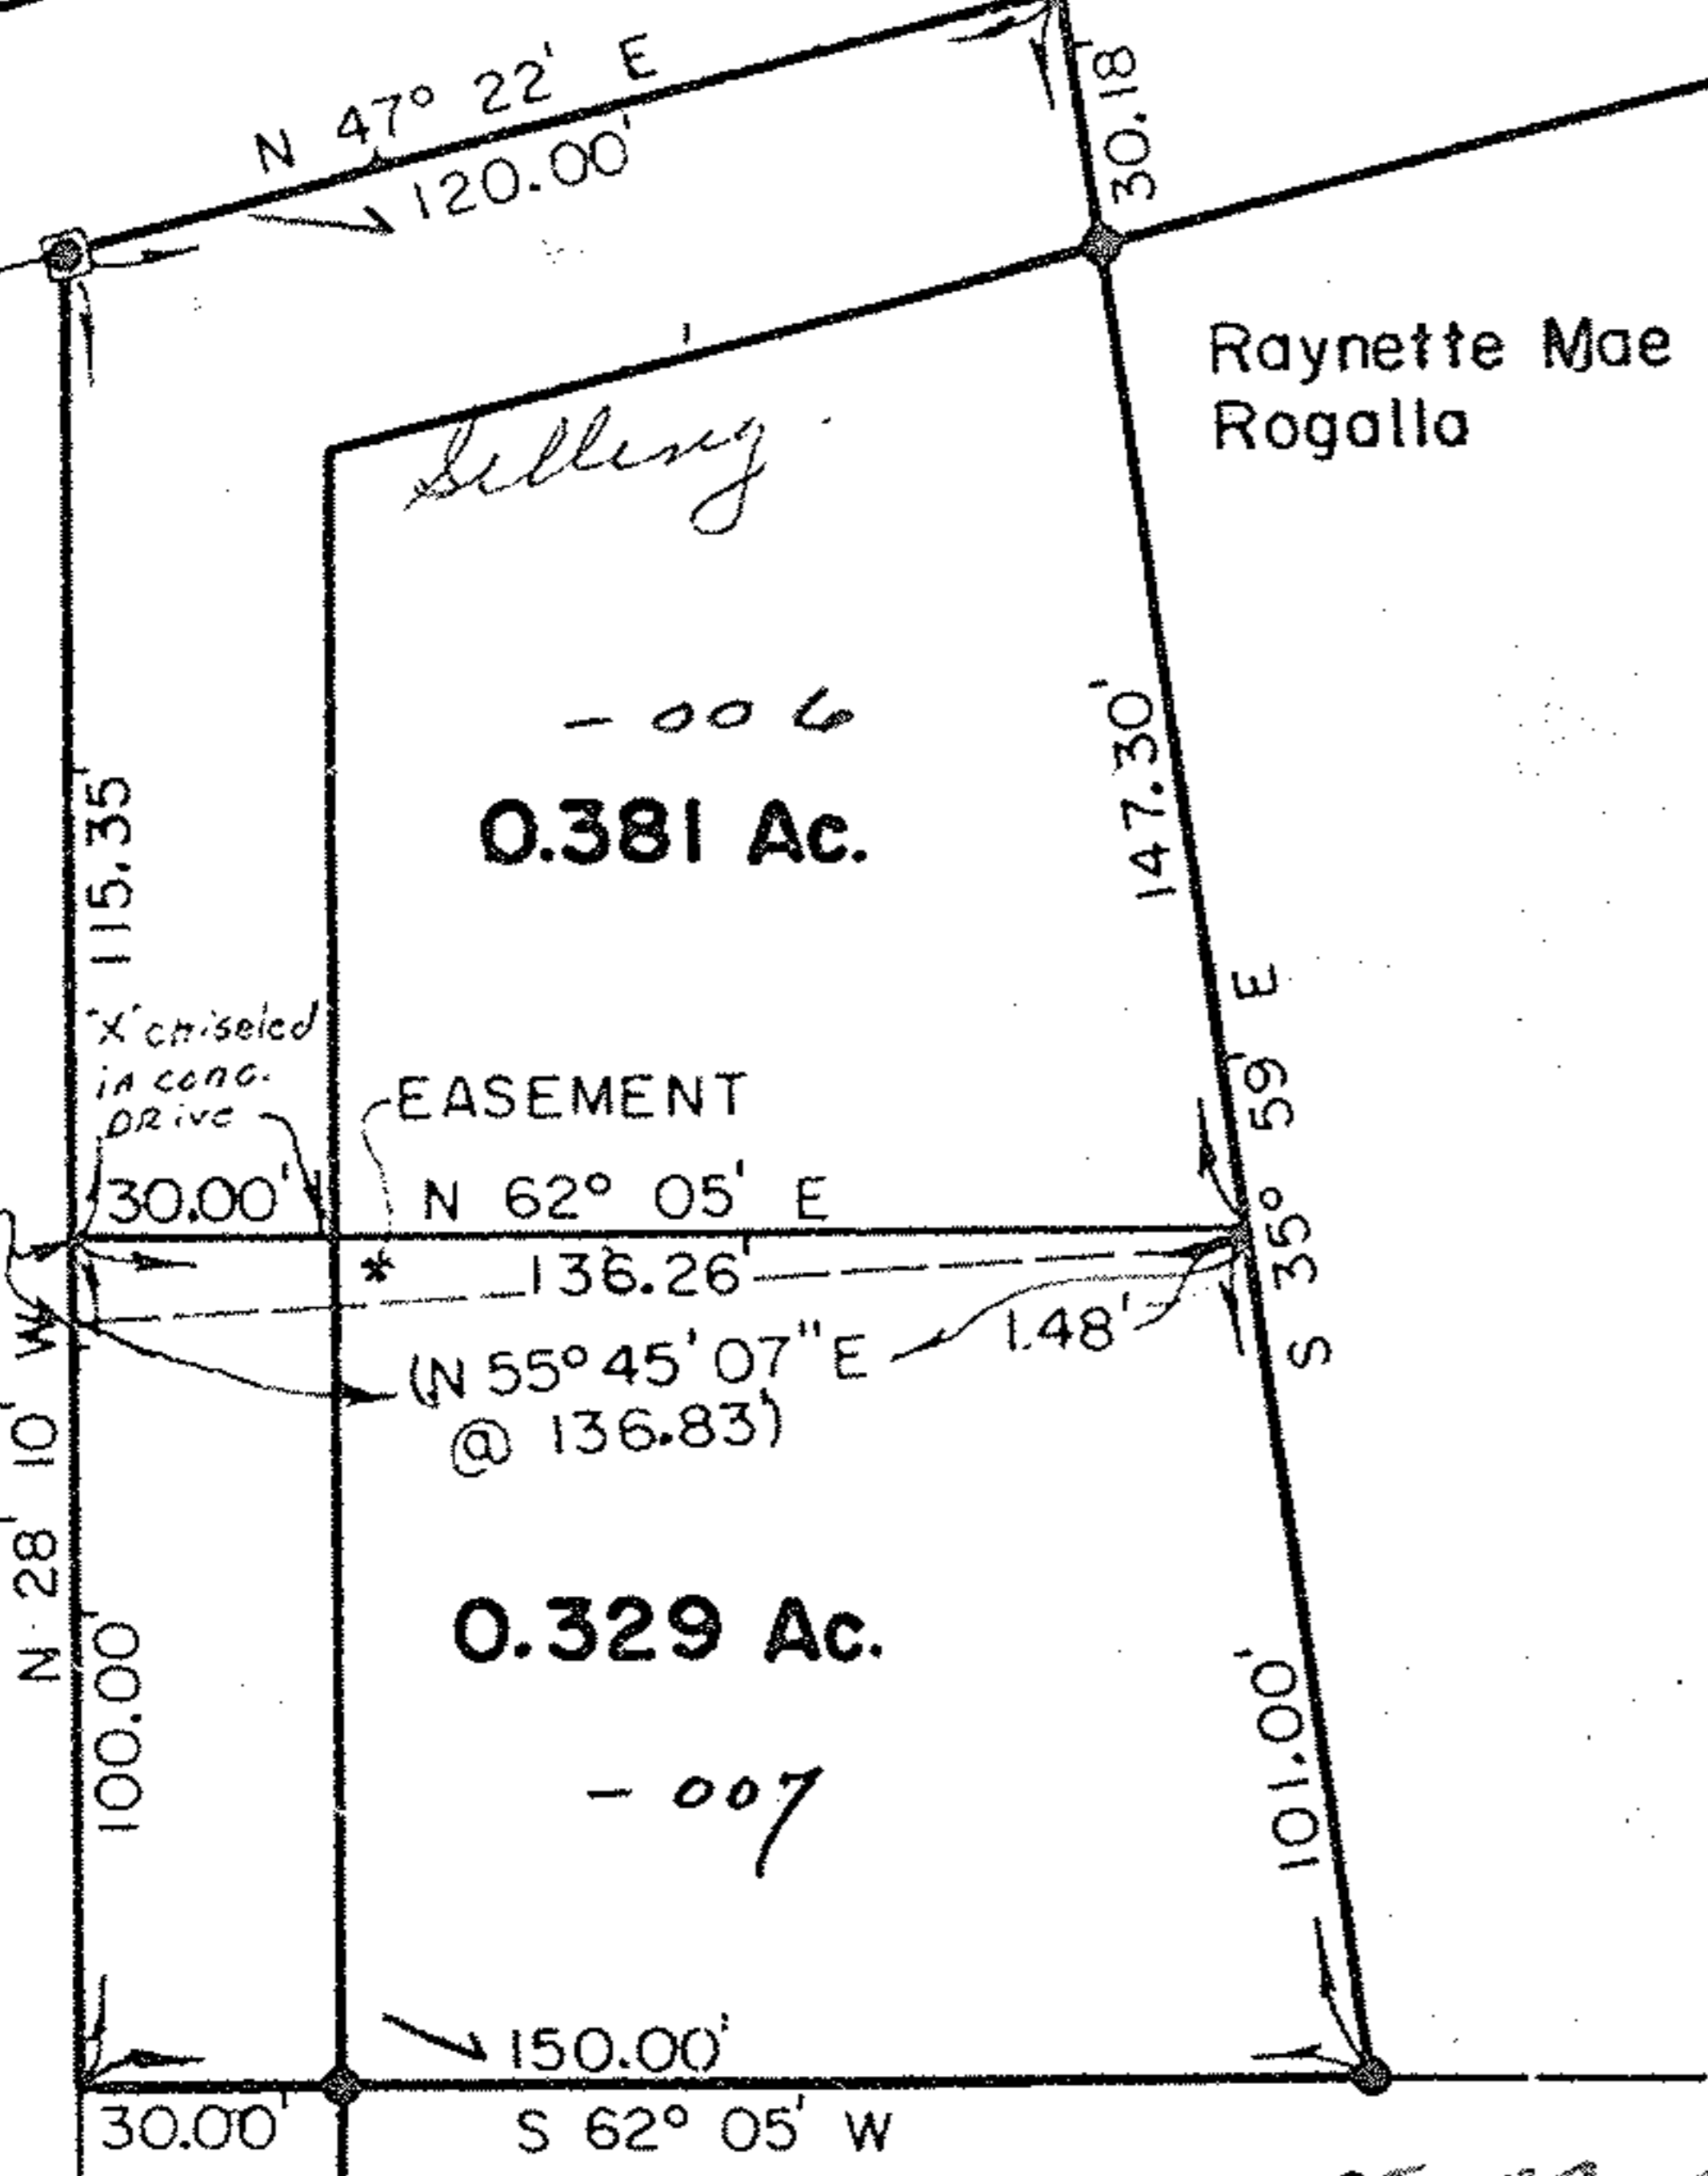

Scale in Inches

Note: bearings are based on an assumed datum

- Legend
- I.P. Set
 - I.P. Found



LOT NO: 60
TOWNSHIP: AMH
COUNTY: LORAIN
OWNER: EDW. N.
DATE: JUNE, 19

JOHN A. BAMBECK
991 MEDINA ROAD
Telephone: 216-239-

05-00-060-106-006,007