

HAPONER & ASSOCIATES, INC.

Engineers & Surveyors
 34100 Center Ridge Road
 NORTH RIDGEVILLE, OHIO 44039
 (216) 327-4776 Lorain 288-4400


SURVEY
 OF PART OF
 ORIGINAL LOT NOS.
 56 AND 57
 TWP OF AMHERST COUNTY OF LORAIN
 STATE OF OHIO

PREPARED FOR:
 BRUCE BABICS
 321 HENRY ST.
 AMHERST, O 44001

SCALE: 1"=60'
 DATE: MARCH 1988

5-00-056-000
 18481
 05-00-056-000

05-00-056-000-041

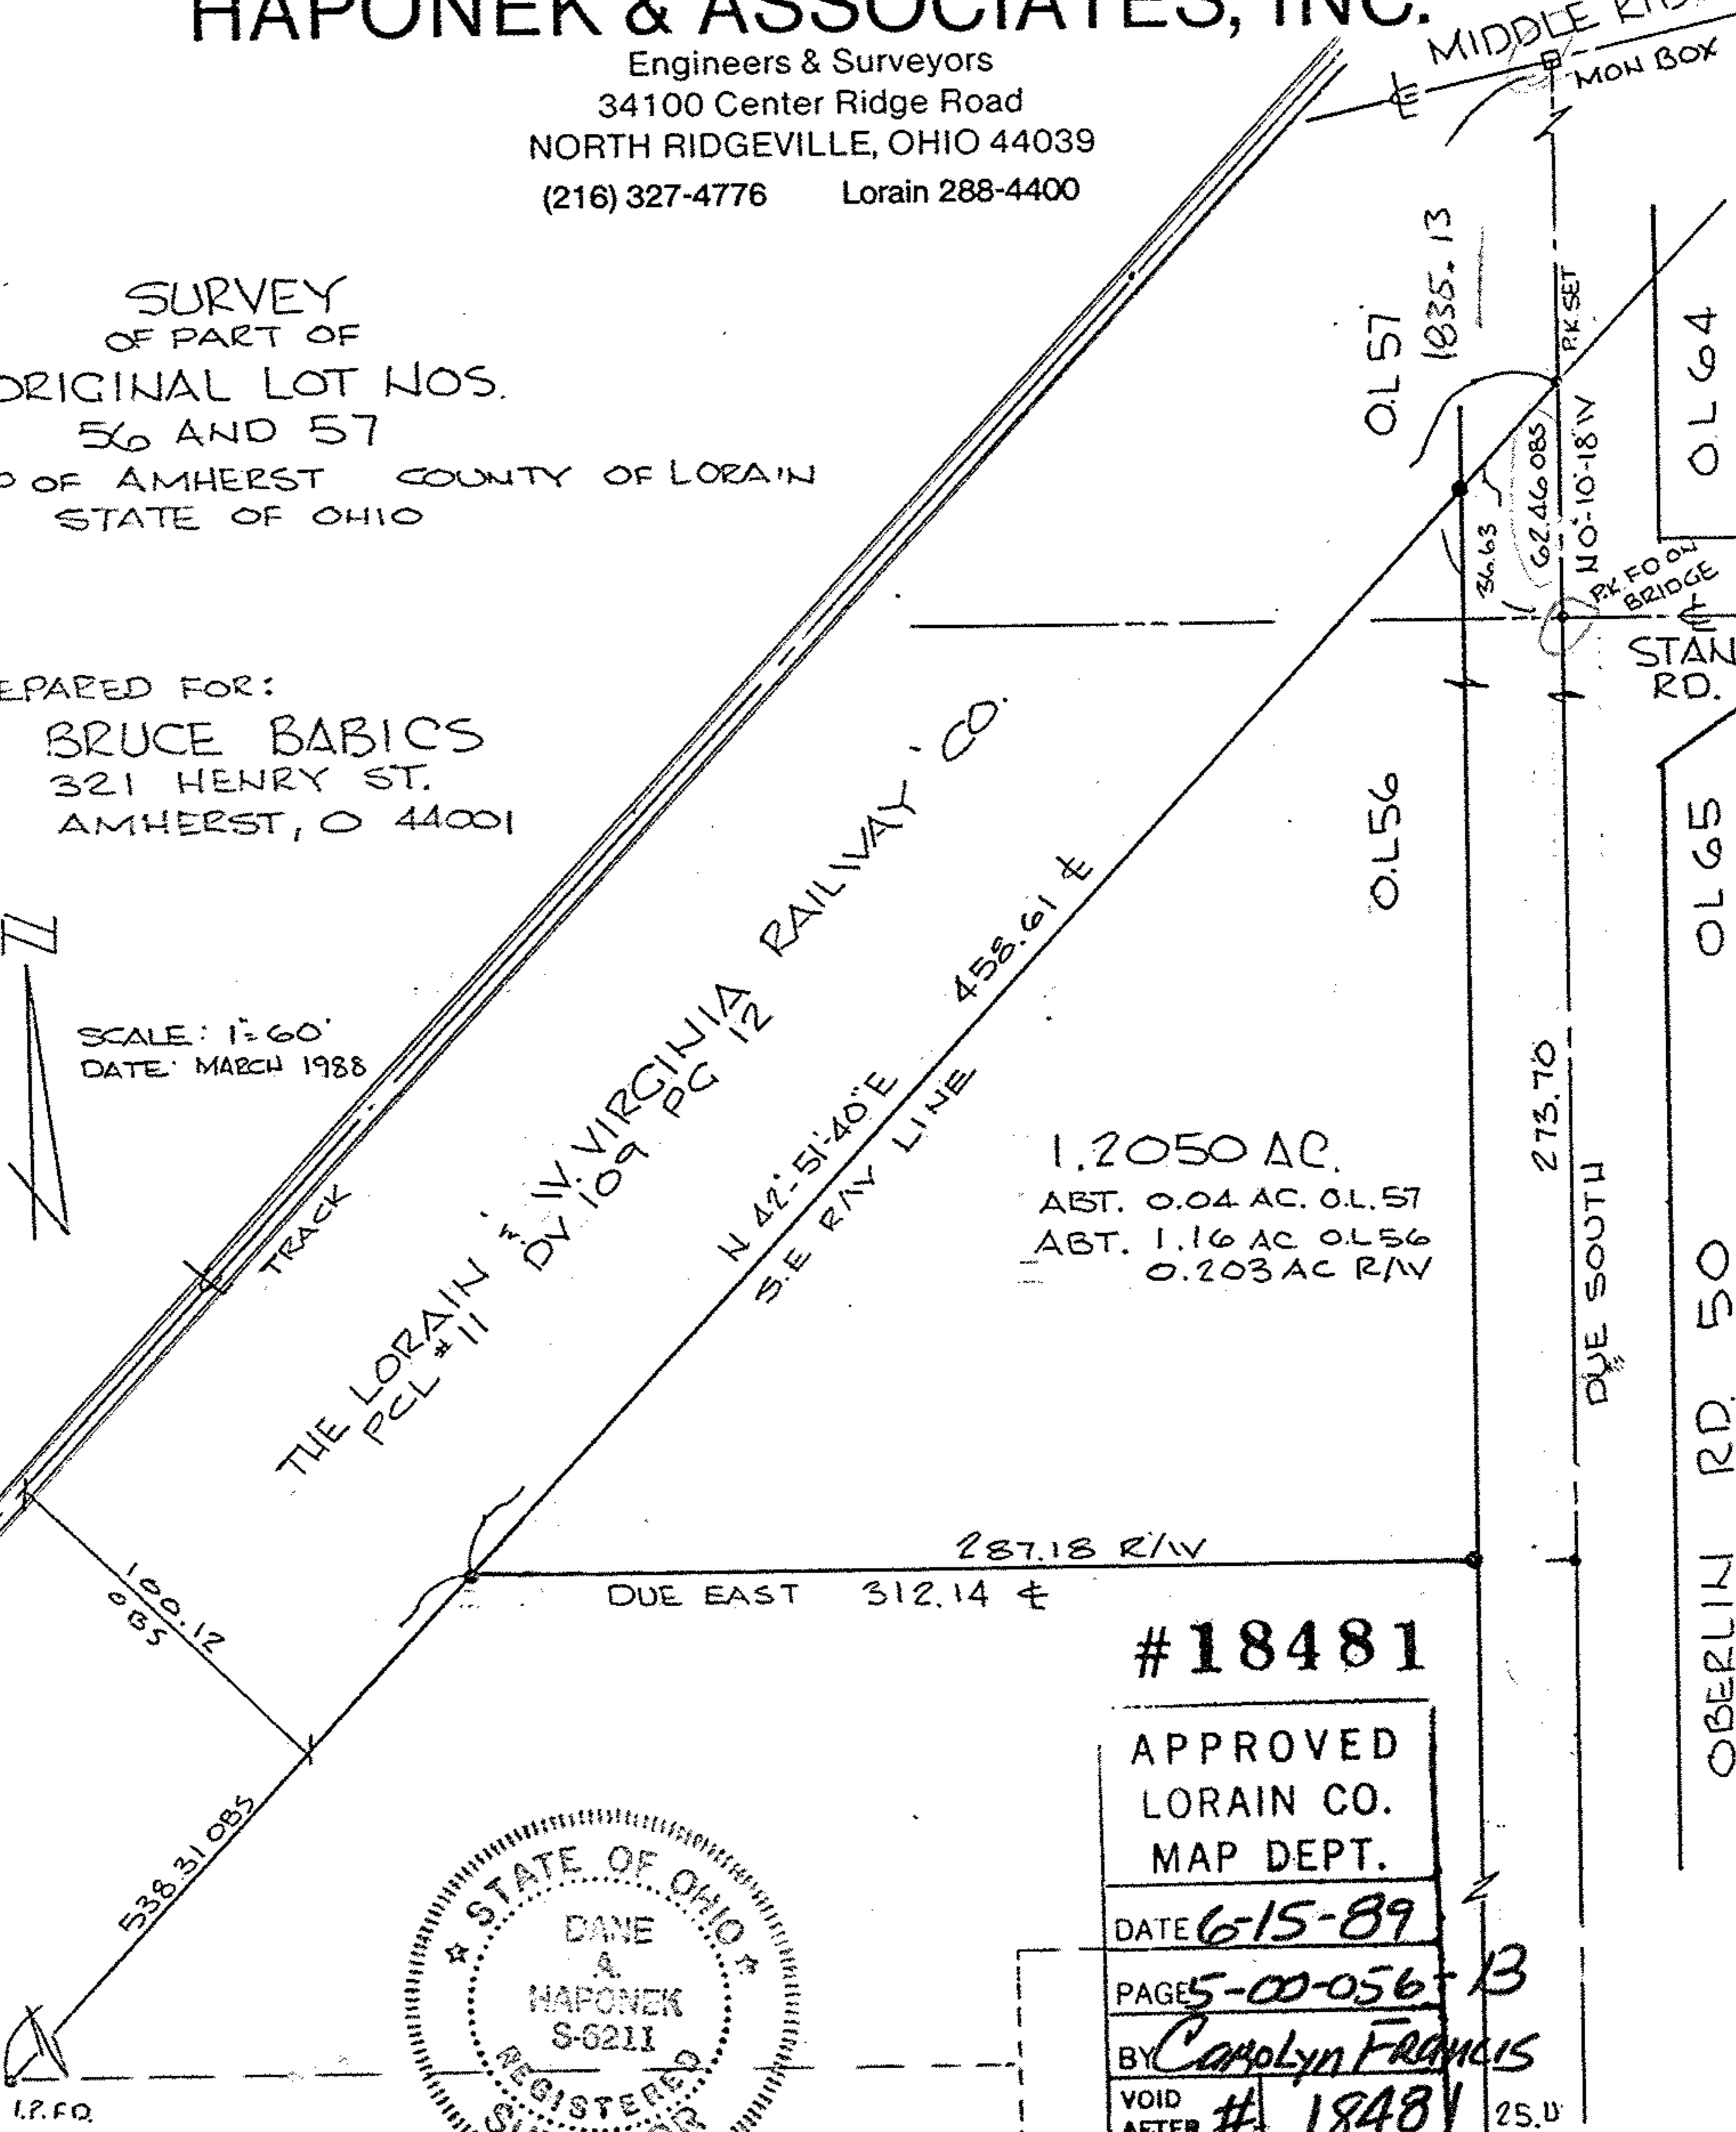

1.2050 AC.
 ABT. 0.04 AC. 0L57
 ABT. 1.16 AC 0L56
 0.203 AC R/V



#18481

APPROVED
 LORAIN CO.
 MAP DEPT.

DATE 6-15-89

PAGE 5-00-056-B

BY Carolyn Francis

VOID AFTER #18481

25.0

L.F.F.O.