

# HAPONEK & ASSOCIATES, INC.

Engineers & Surveyors  
34100 Center Ridge Road  
NORTH RIDGEVILLE, OHIO 44039  
(216) 327-4776 Lorain 288-4400

05-00-056-000-003  
05-00-057-000-000  
05-00-050-000-000

SURVEY  
OF PART OF  
ORIGINAL LOT NOS.  
56 AND 57


TWP OF AMHERST COUNTY OF LORAIN  
STATE OF OHIO

PREPARED FOR:

BRUCE BABICS  
321 HENRY ST.  
AMHERST, O 44001

SCALE: 1"=60'  
DATE: MARCH 1988

VOID

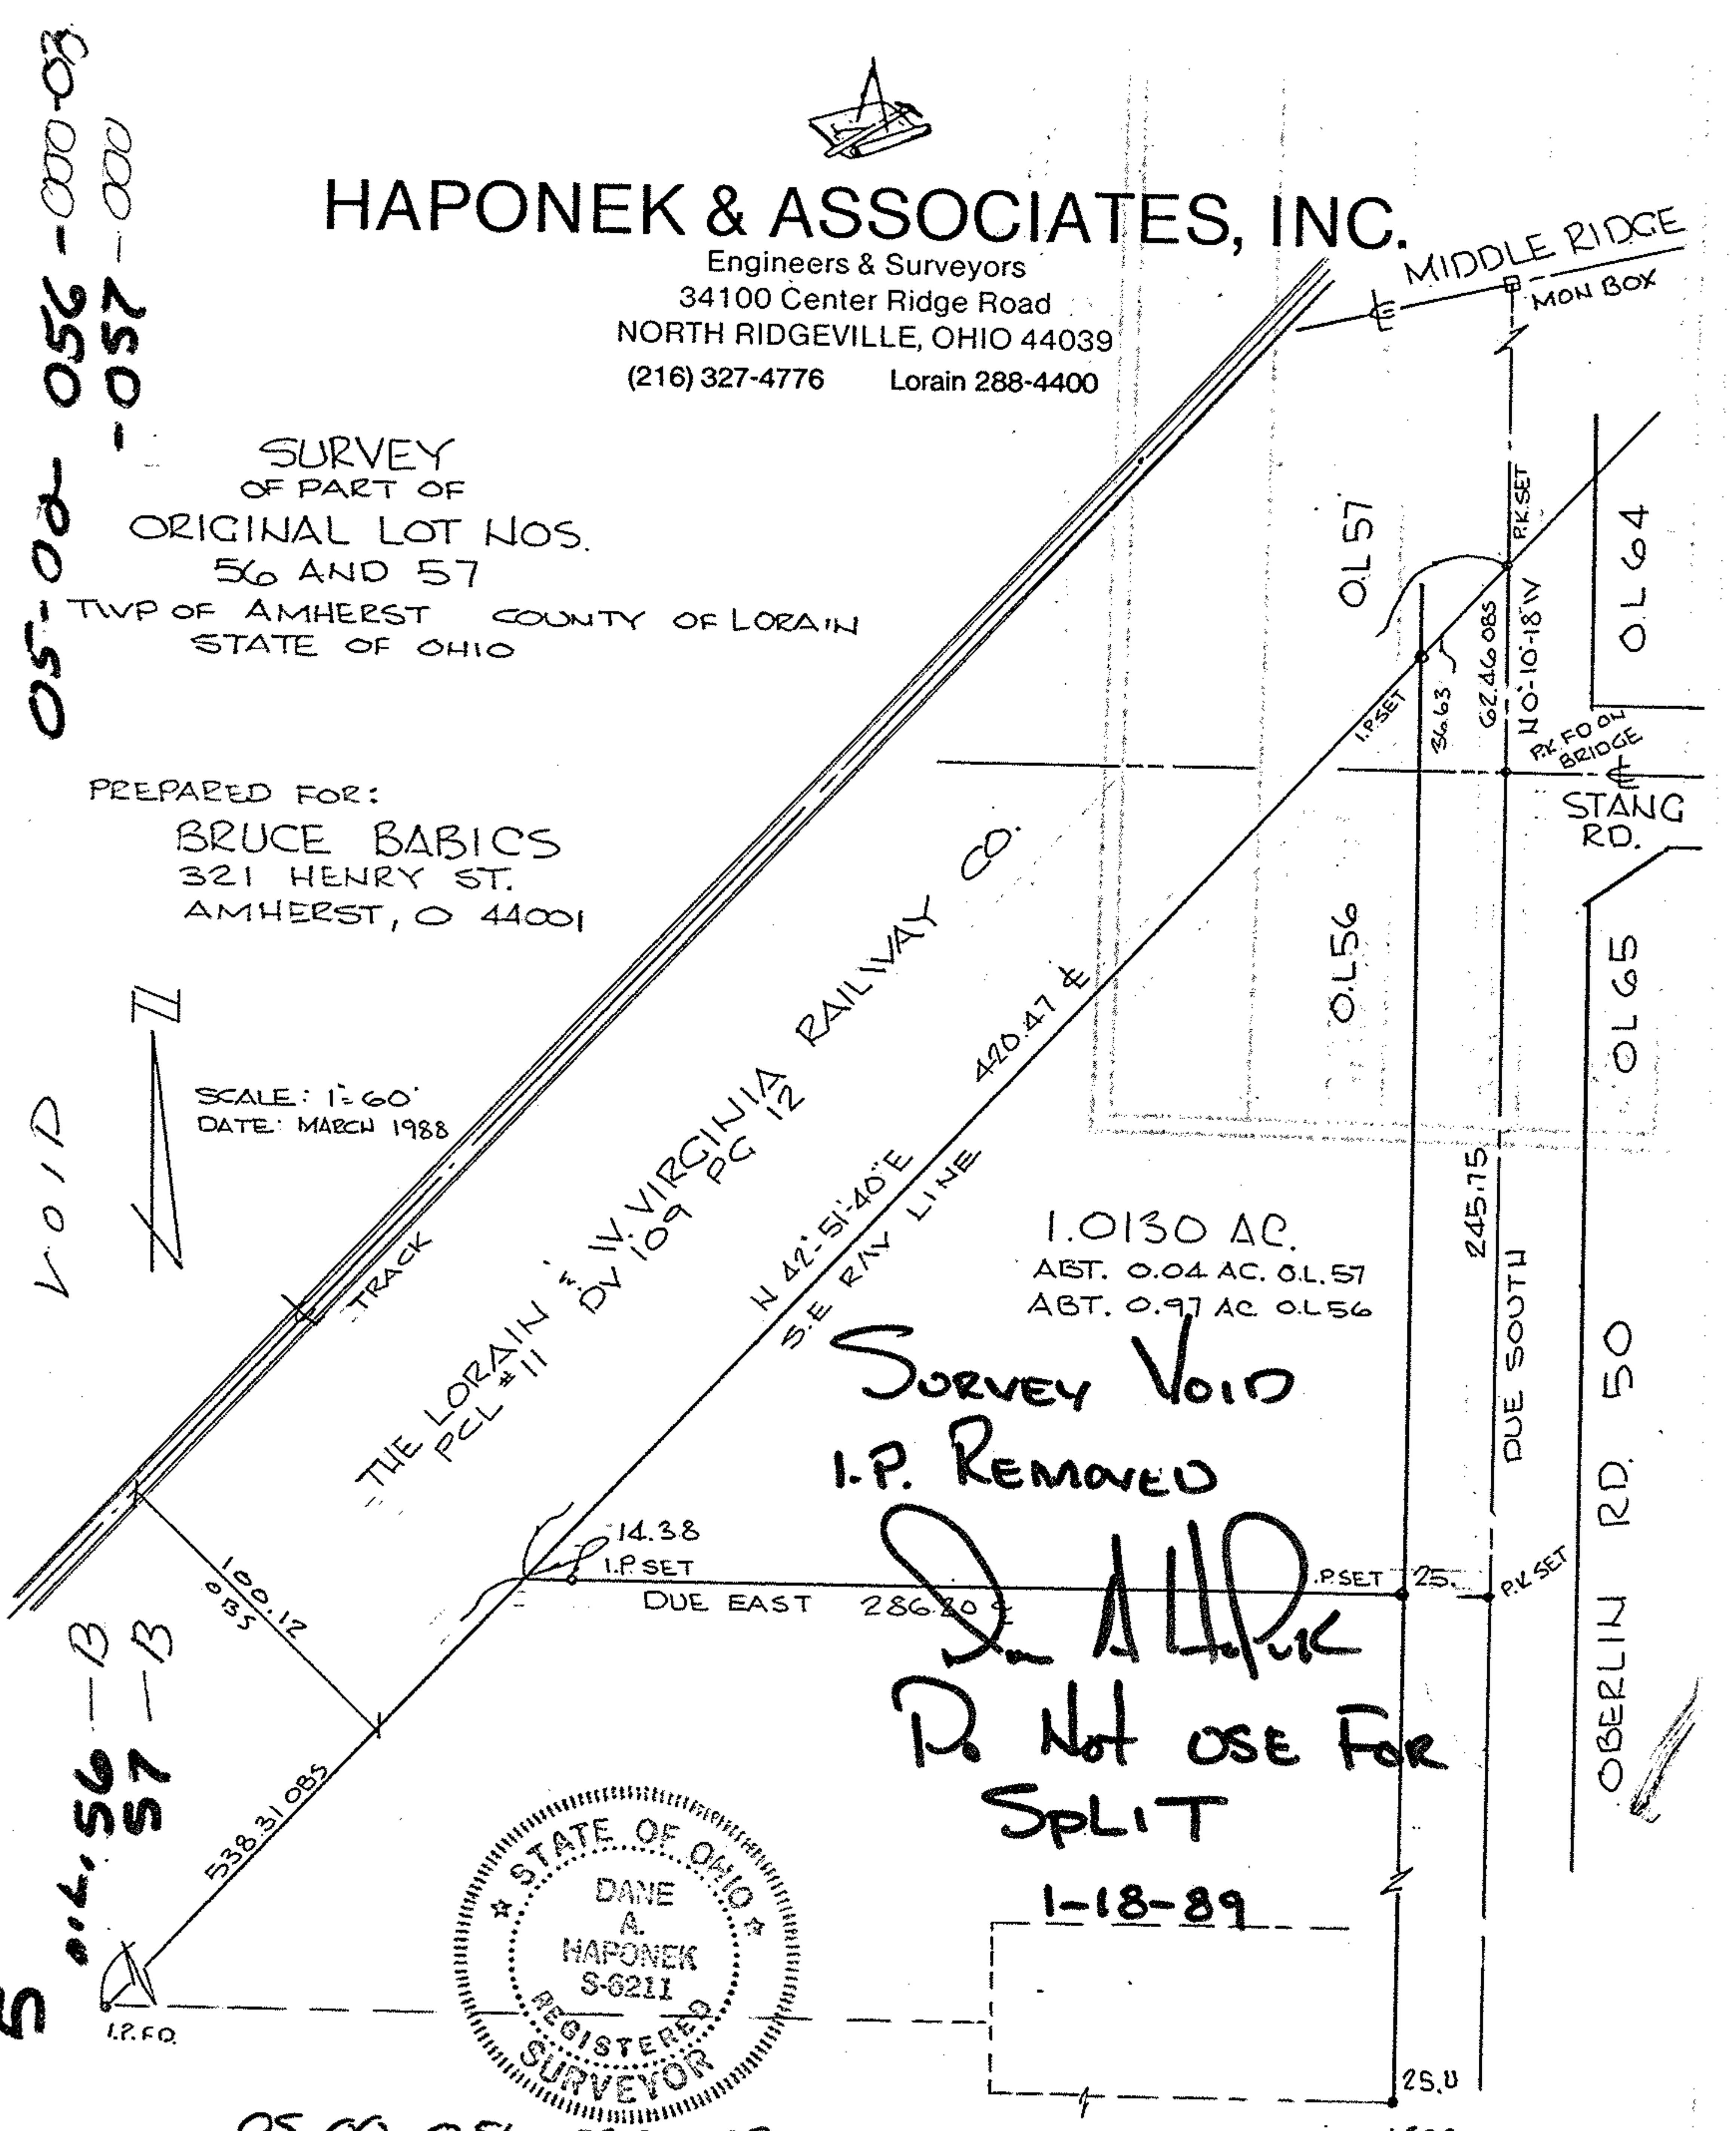

1.0130 AC.  
ABT. 0.04 AC. O.L. 57  
ABT. 0.97 AC. O.L. 56

**SURVEY VOID**  
**I.P. REMOVED**  
**D. A. H. P. K.**  
**Do Not USE For**  
**SPLIT**

1-18-89



05-00-056-000-035