
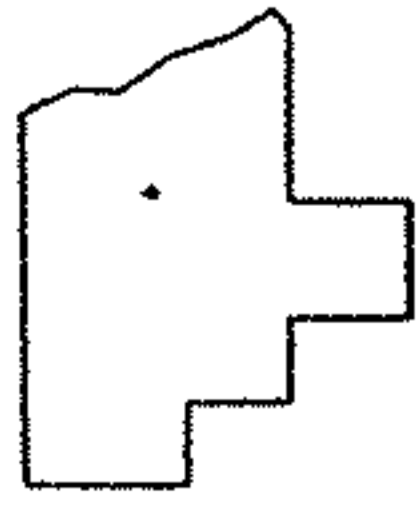
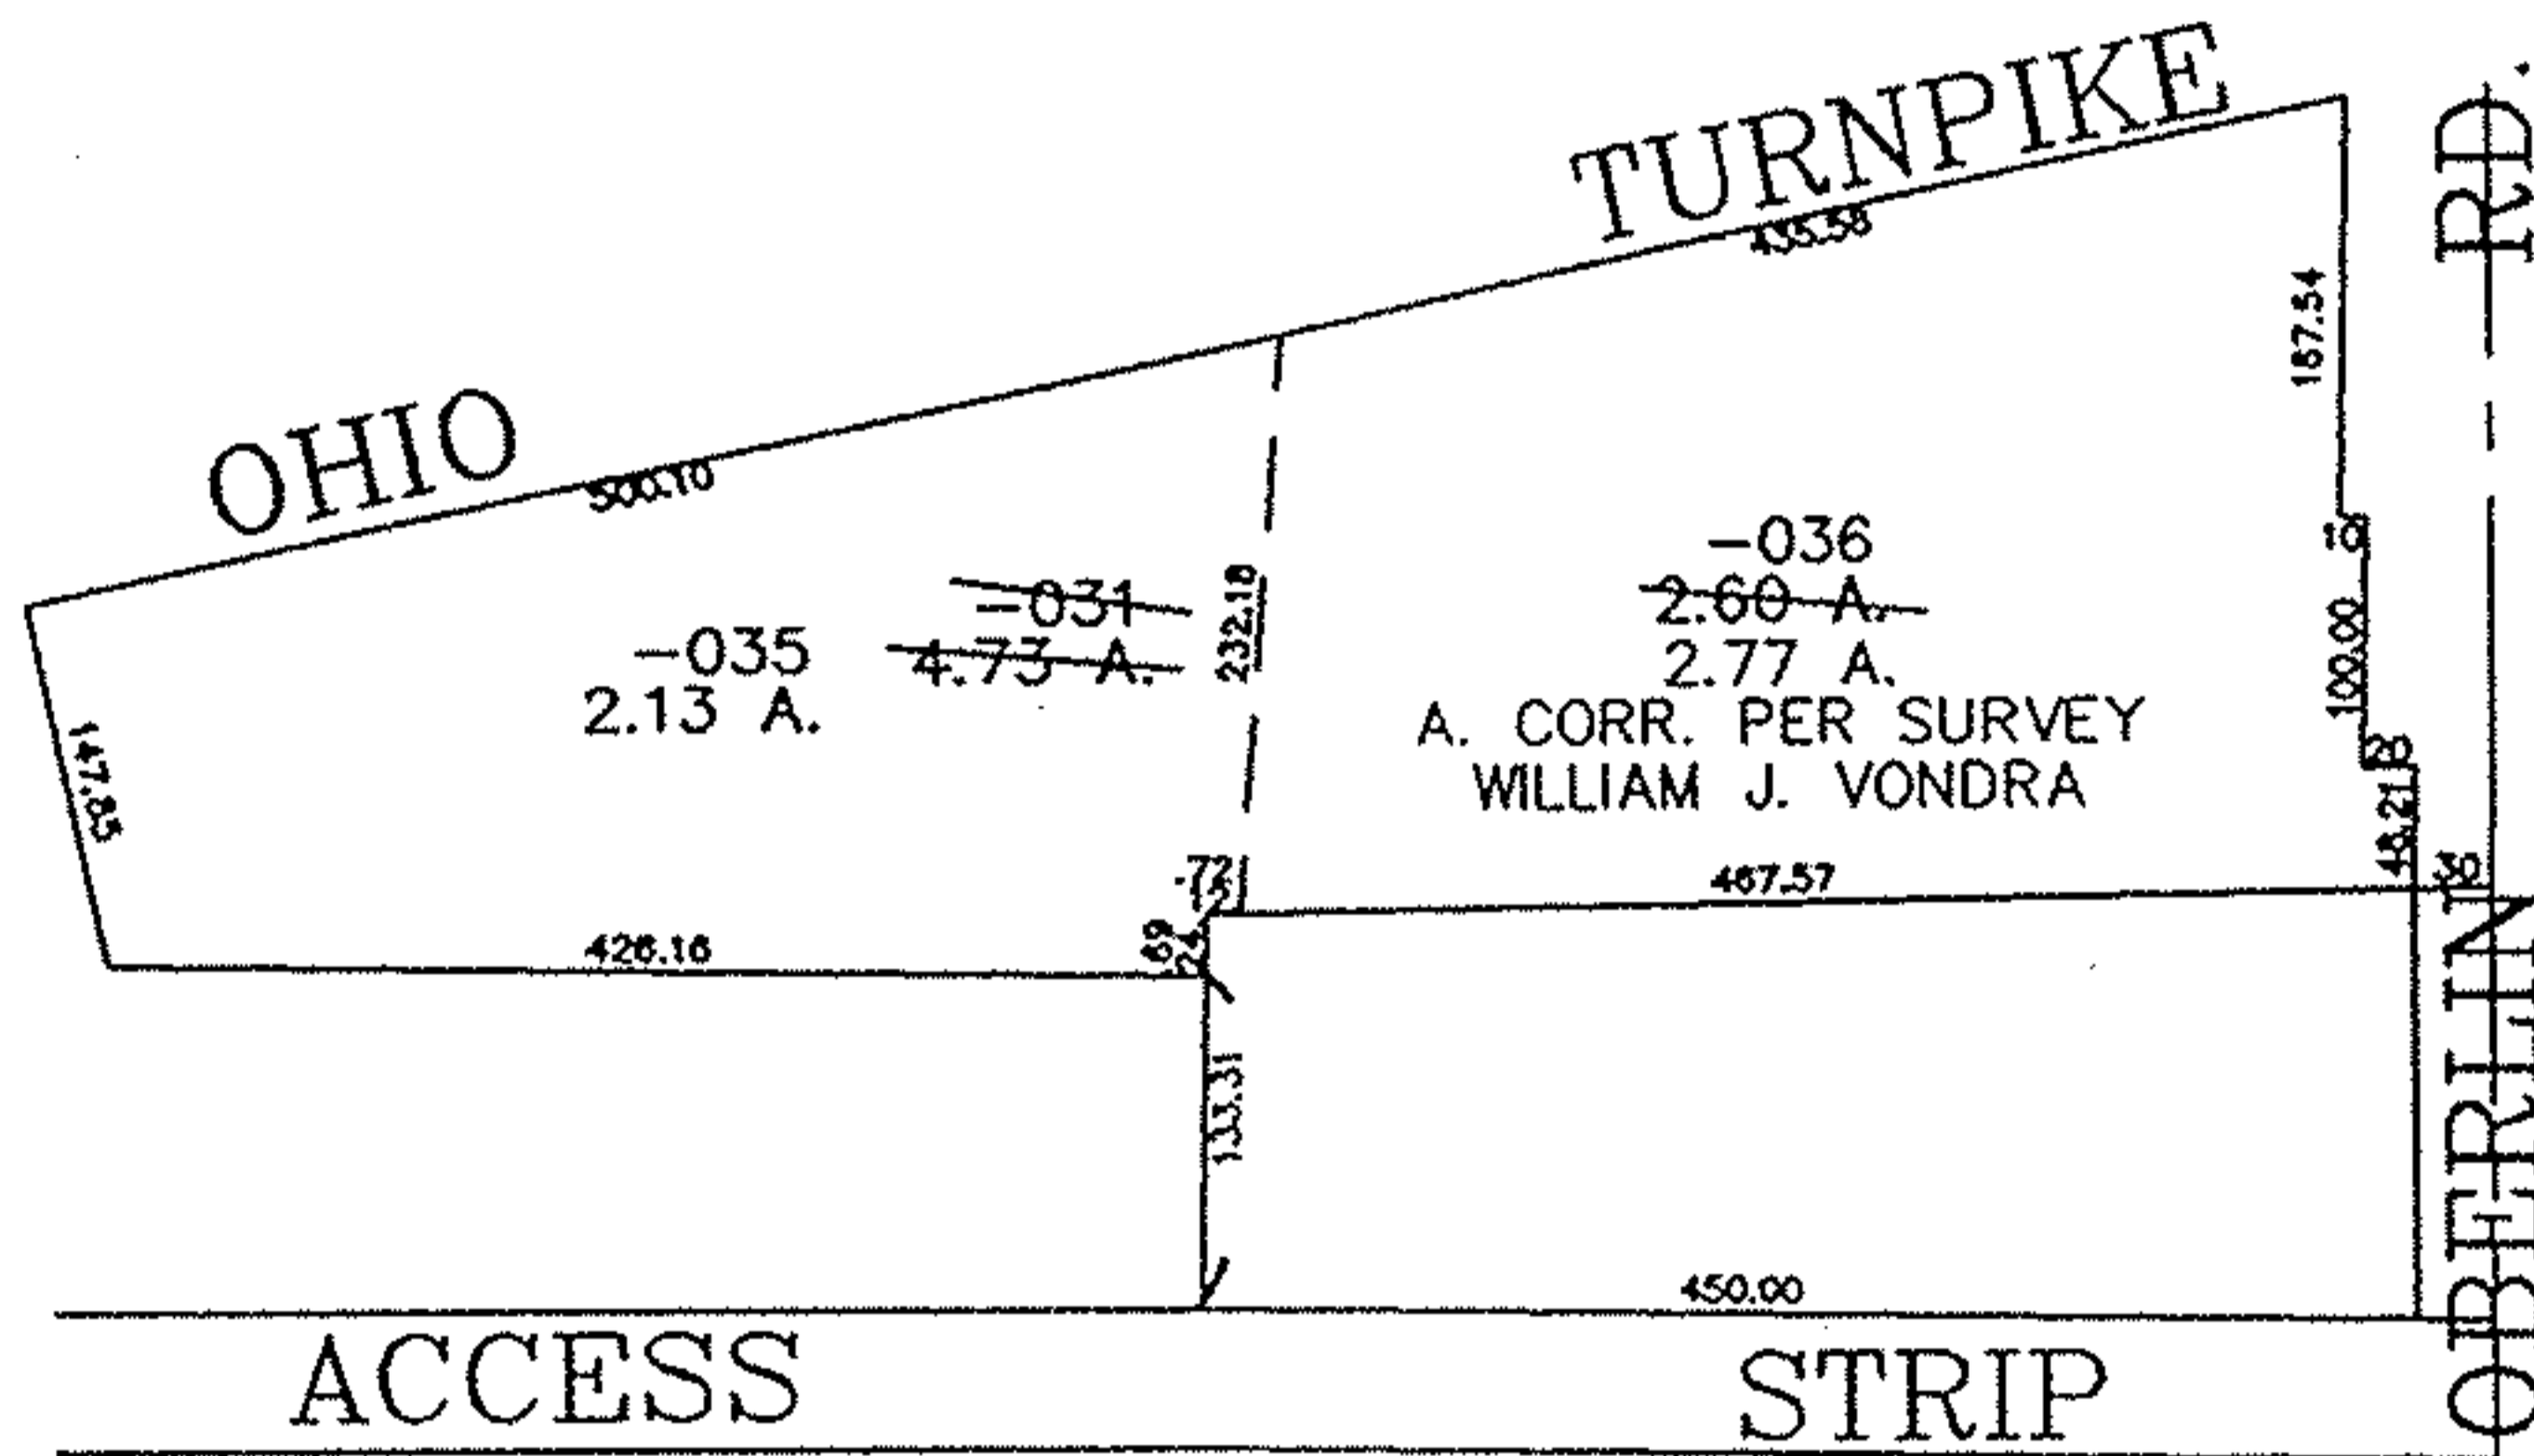


PARENT PARCEL: 05-00-055-000-031

CHILD PARCEL: 05-00-055-000-035, -036

STARTING POINT: CENTERLINE OF OBERLIN RD. & OHIO TURNPIKE ACCESS STRIP

NO. 00742

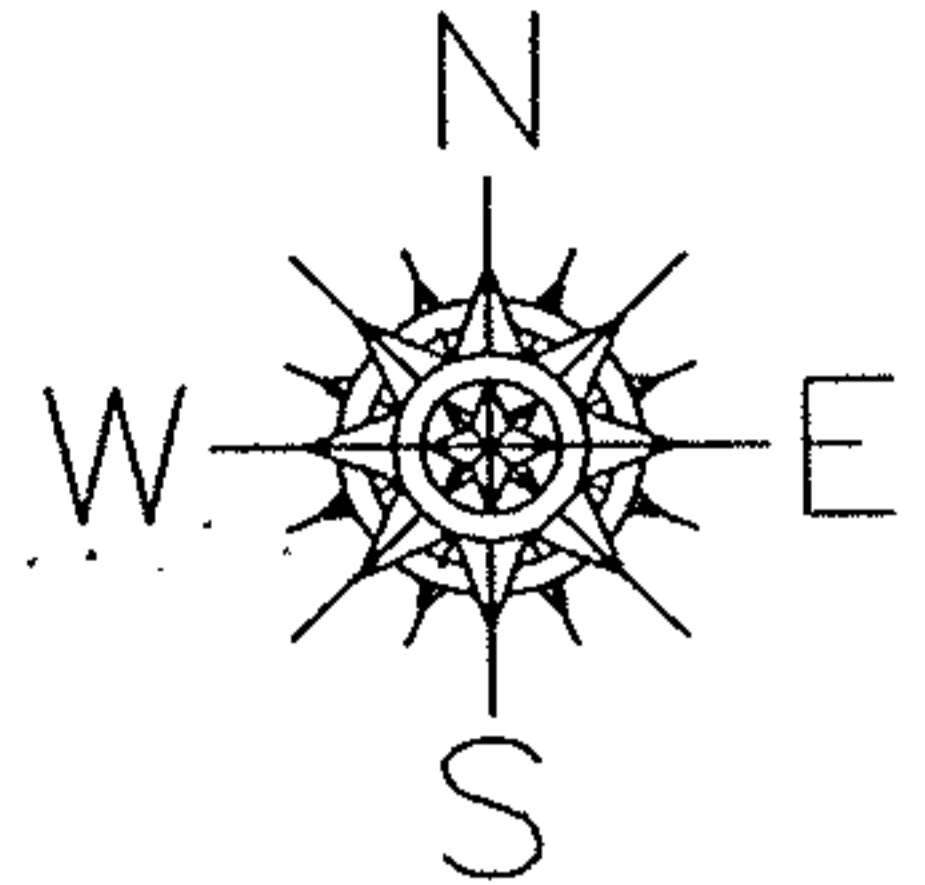

SPLITS/DEEDS PROCESSED

LORAIN COUNTY TAX MAP DEPARTMENT
226 MIDDLE AVE. ELYRIA, OHIO

SURVEYED BY: WILLIAM J. VONDRA

CLOSURE: 0.01 : 10.000

MAP PAGE(S): 5-6

APPROVED BY: JAH DATE: 7-26-01

SCALE: 1" = 200 PRIOR INSTRUMENT: OR 849/591