

James A. Wright
O.R.V. 24, P. 312

LEGEND: Iron Pipes Found ○
Iron Pipes, Rods Set ●

NORTH



SCALE
1" = 100'

I.P. Fd.
1.9'E
1.3'S



#22454

APPROVED
LORAIN CO.
MAP DEPT

DATE 3-11-98


PAGE 5-G

BY K. Colbert

#22454

Charles P. Waryu
CHARLES P. WARYU,
Registered Surveyor No. 5029

05-06-054-000-042,043,044

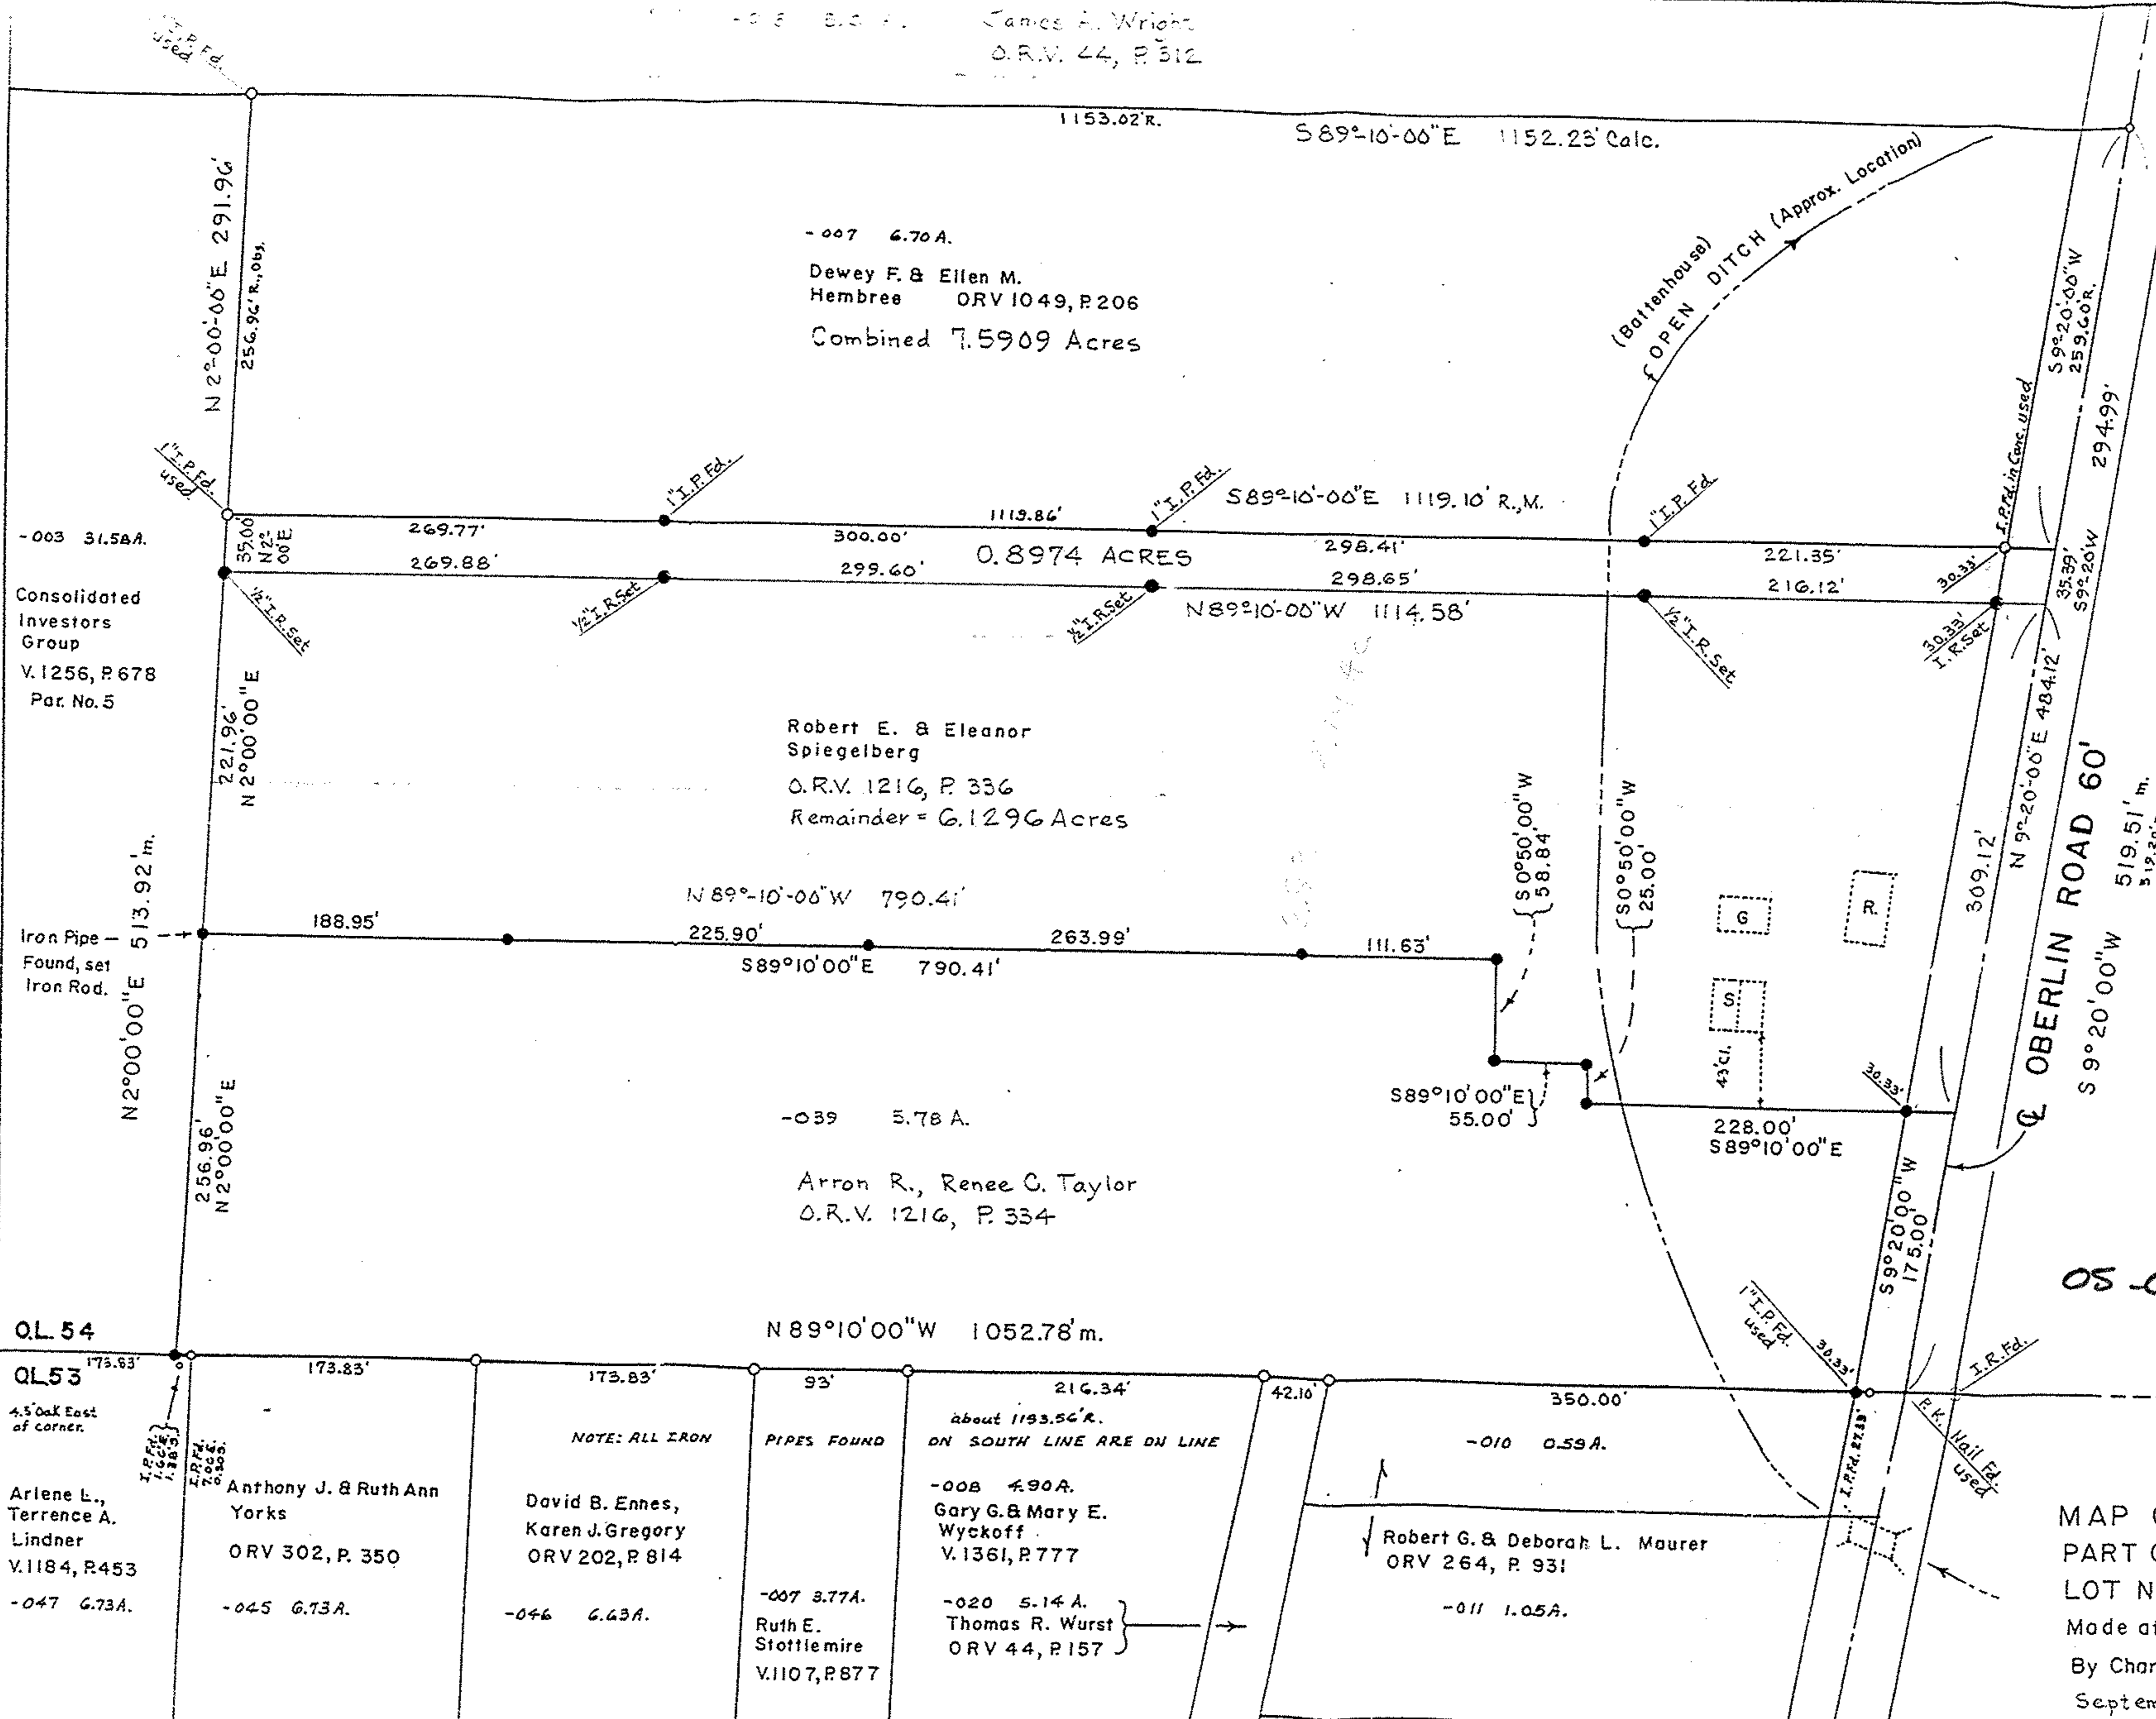

-007 6.70 A.
Dewey F. & Ellen M.
Hembree ORV 1049, P. 206
Combined 7.5909 Acres

-003 31.58 A.
Consolidated
Investors
Group
V. 1256, P. 678
Par. No. 5

Robert E. & Eleanor
Spiegelberg
O.R.V. 1216, P. 336
Remainder = 6.1296 Acres

-039 5.78 A.
Arron R., Renee C. Taylor
O.R.V. 1216, P. 334

OL 54
OL 53
4.5' Oak East
of corner.
Arlene L.,
Terrence A.
Lindner
V. 1184, P. 453
-047 6.73 A.
Anthony J. & Ruth Ann
Yorks
ORV 302, P. 350
-045 6.73 A.

NOTE: ALL IRON
PIPES FOUND
David B. Ennes,
Karen J. Gregory
ORV 202, P. 814
-046 6.43 A.

about 1193.56' R.
ON SOUTH LINE ARE ON LINE
-008 4.90 A.
Gary G. & Mary E.
Wyckoff
V. 1361, P. 777
-020 5.14 A.
Thomas R. Wurst
ORV 44, P. 157
-007 3.77 A.
Ruth E.
Stottlemire
V. 1107, P. 877

-010 0.59 A.
Robert G. & Deborah L. Maurer
ORV 264, P. 931
-011 1.05 A.

MAP OF SURVEY PARCEL SPLIT
PART OF ORIGINAL AMHERST TOWNSHIP
LOT NO. 54, LORAIN COUNTY, OHIO
Made at request of Robert E. Spiegelberg
By Charles P. Waryu, Reg. Surveyor No. 5029
September 1997