

John Hancock & Associates

ENGINEERS • SURVEYORS

416 Columbus Ave • Sandusky, OH 44870 • (419) 625-7838

07-00-018--101-273

#20139

JAYCOX RD.

1" W. LINE LOT NO. 18

570.57

1" IRON PIPE SW COR. LOT 18

60.00

PK NAIL SET

NORTH 178.53

30.00

89°01'30" DEED USED

1" IRON SET

179.04

WEST 241.36

211.36

EAST 240.37

60.00

SOUTH 182.64

N 89°01'30" E 241.39

1.0006 AC.

- 273

GARY R. & KIMBERLY GRAHAM
O.R. 538, PG 57

CHAS. & JUDITH SALTER
D.V. 1062, PG. 648

SURVEY


for

BRUCE HONDA

1.0006 AC OUT OF LANDS OF MAYER
IN ORIG. RIDGEVILLE TWP LOT 18
CITY OF NORTH RIDGEVILLE, LORAIN COUNTY, OHIO

BEARINGS ARE BASED ON CENTERLINE
OF JAYCOX RD OF TRUE NORTH.

THIS MAP PREPARED
FROM A FIELD SURVEY
CONDUCTED SEPTEMBER 1992

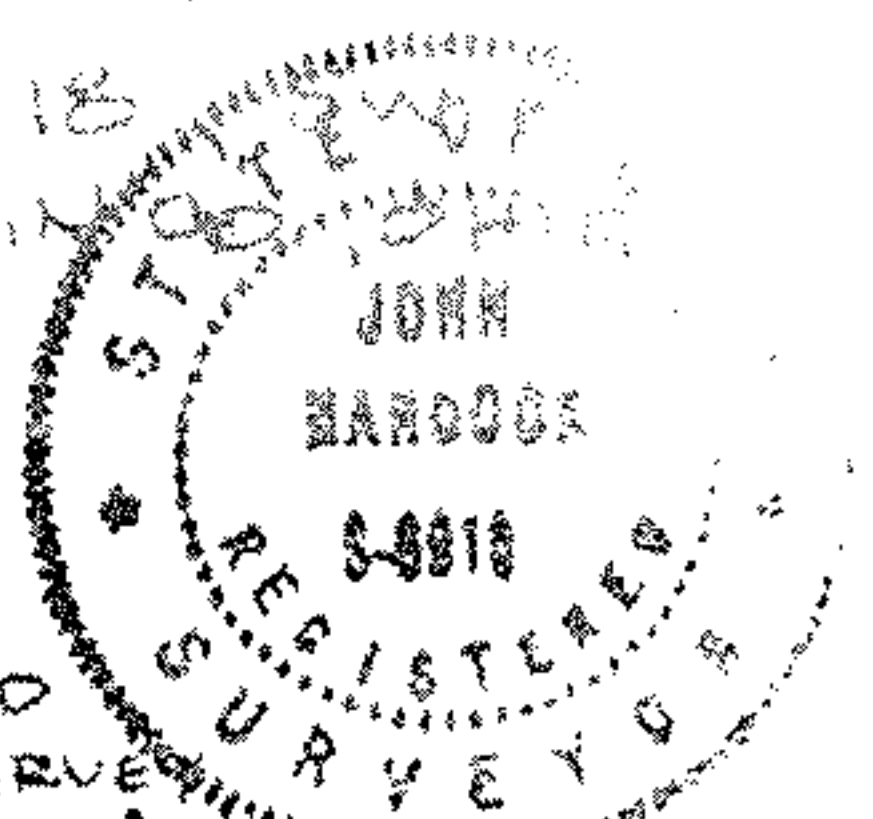

SCALE: 1 INCH = 50 FT.

DATE: 9.15.92
JOB NO: 44389
REVISED:

URV'D: JH	DRAWN: JH	CHECKED: JH
--------------	--------------	----------------

John Hancock
JOHN HANCOCK
REGISTERED SURVEYOR