


5-00-097-B

# 16966

05-00-097-103

05-00-097-103, 094, 093

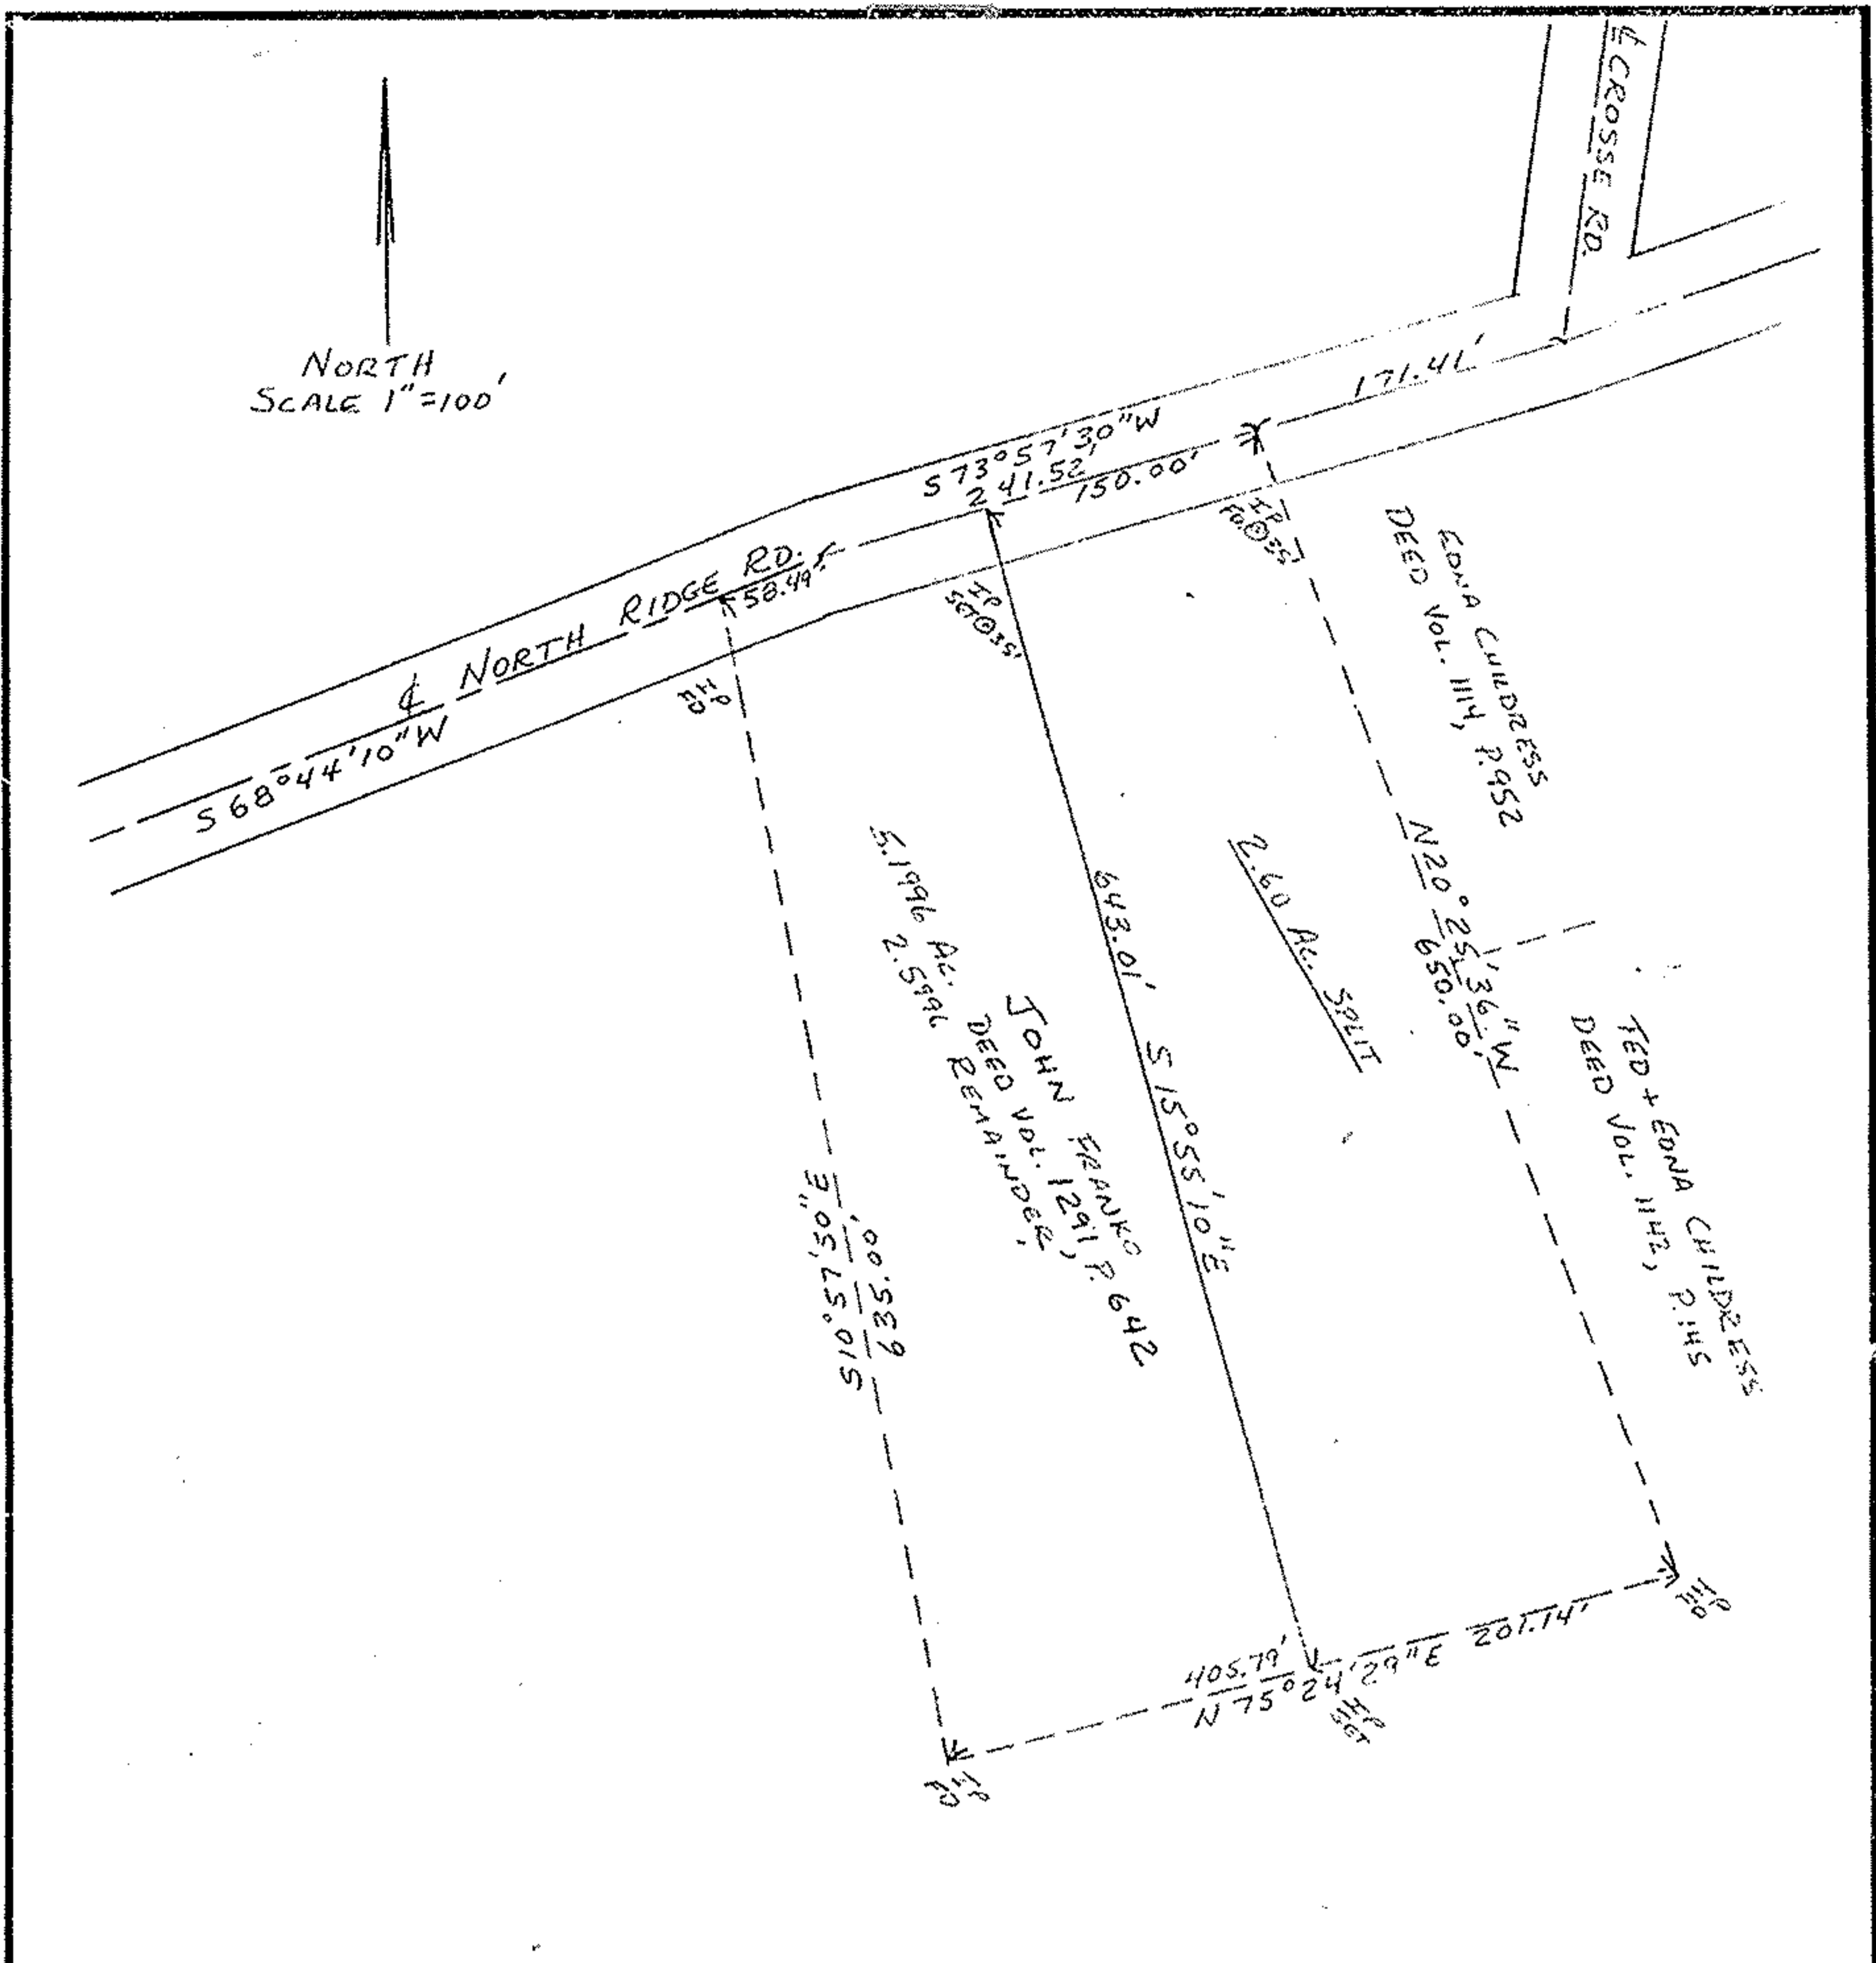


SURVEY OF 2.60 ACRE SPLIT FOR JOHN FRANKO  
AMHERST TOWNSHIP - D. L. 97 - LORAIN COUNTY

SCALE: 1"=100'  
DATE: 7/21/86

APPROVED BY: \_\_\_\_\_  
DRAWN BY: JRH

JOHN R. HAMILTON - REG. SURV. # 6861

DRAWING NUMBER

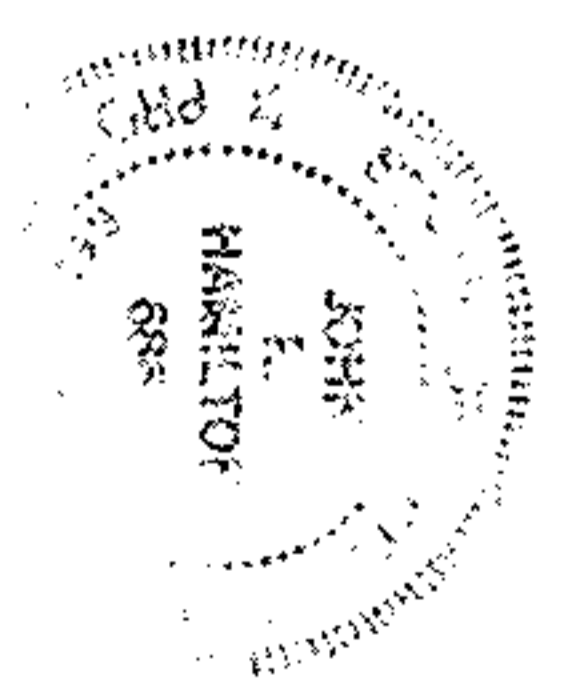

# 16966

APPROVED  
LORAIN CO.  
MAP DEPT.

DATE 9-2-86

PAGE 5-00-097 B

BY *J. Sobert*

VOID AFTER 16966