


11843

REVISED & RECEIVED 7-21-78

Map of Part of O.L. 97 Amherst Twp. Now City of Amherst Lorain Co. Ohio
Scale 1" = 100' May 29, 1978
By Arnold F. Koepf Registered Surveyor No. 4306

102

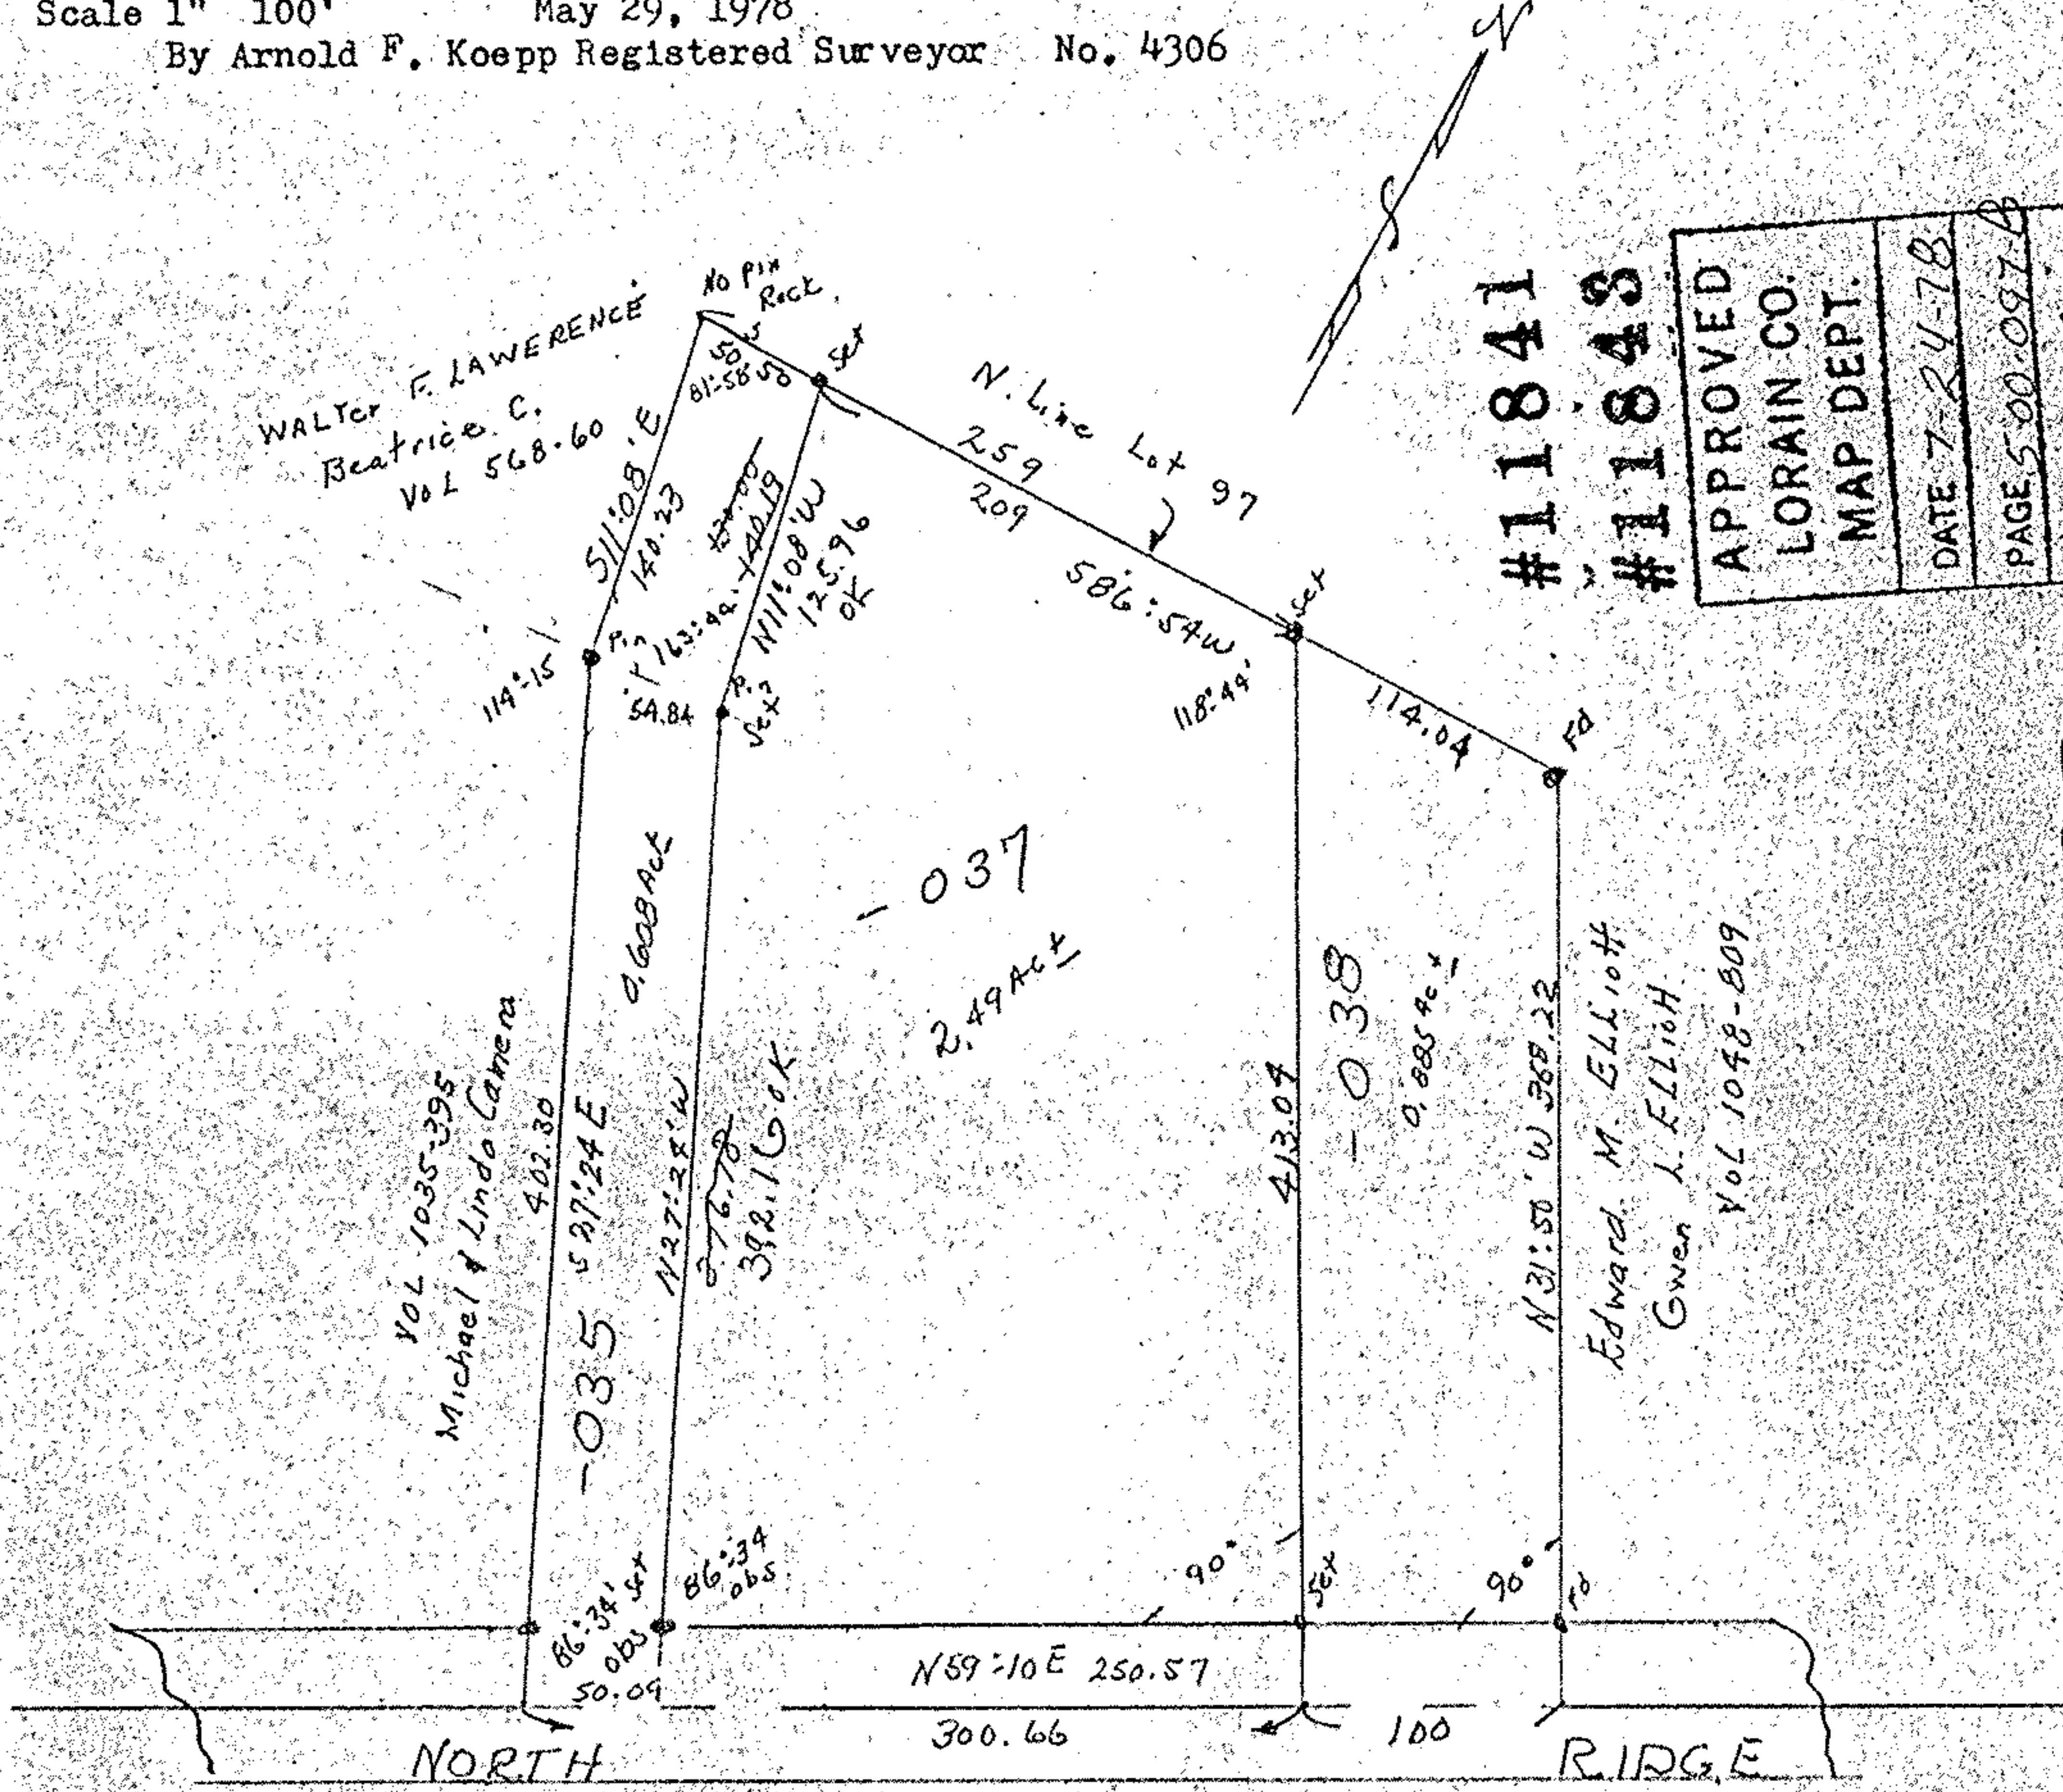

#11841
#11843

APPROVED
LORAIN CO.
MAP DEPT.
DATE 7-24-78
PAGE 500-097-B
BY T. McLaw
VOID AFTER 11843

Vol 1035-395
Michael & Linda Camera

WALTER F. LAWRENCE
Beatrice C.
Vol 568-60

Edward M. ELLIOTT
Gwen L. ELLIOTT
Vol 1048-809

05-00-097 102-038
037