

5-00-097-A

#14087


05-00-097-101-01

APPROVED  
LORAIN CO.  
MAP DEPT.  
DATE 3-26-81  
PAGE 5-00-097-A  
BY T. M. McNair  
VOID AFTER

NORTH  
SCALE: 1" = 50'

-025

1.440 ACRES

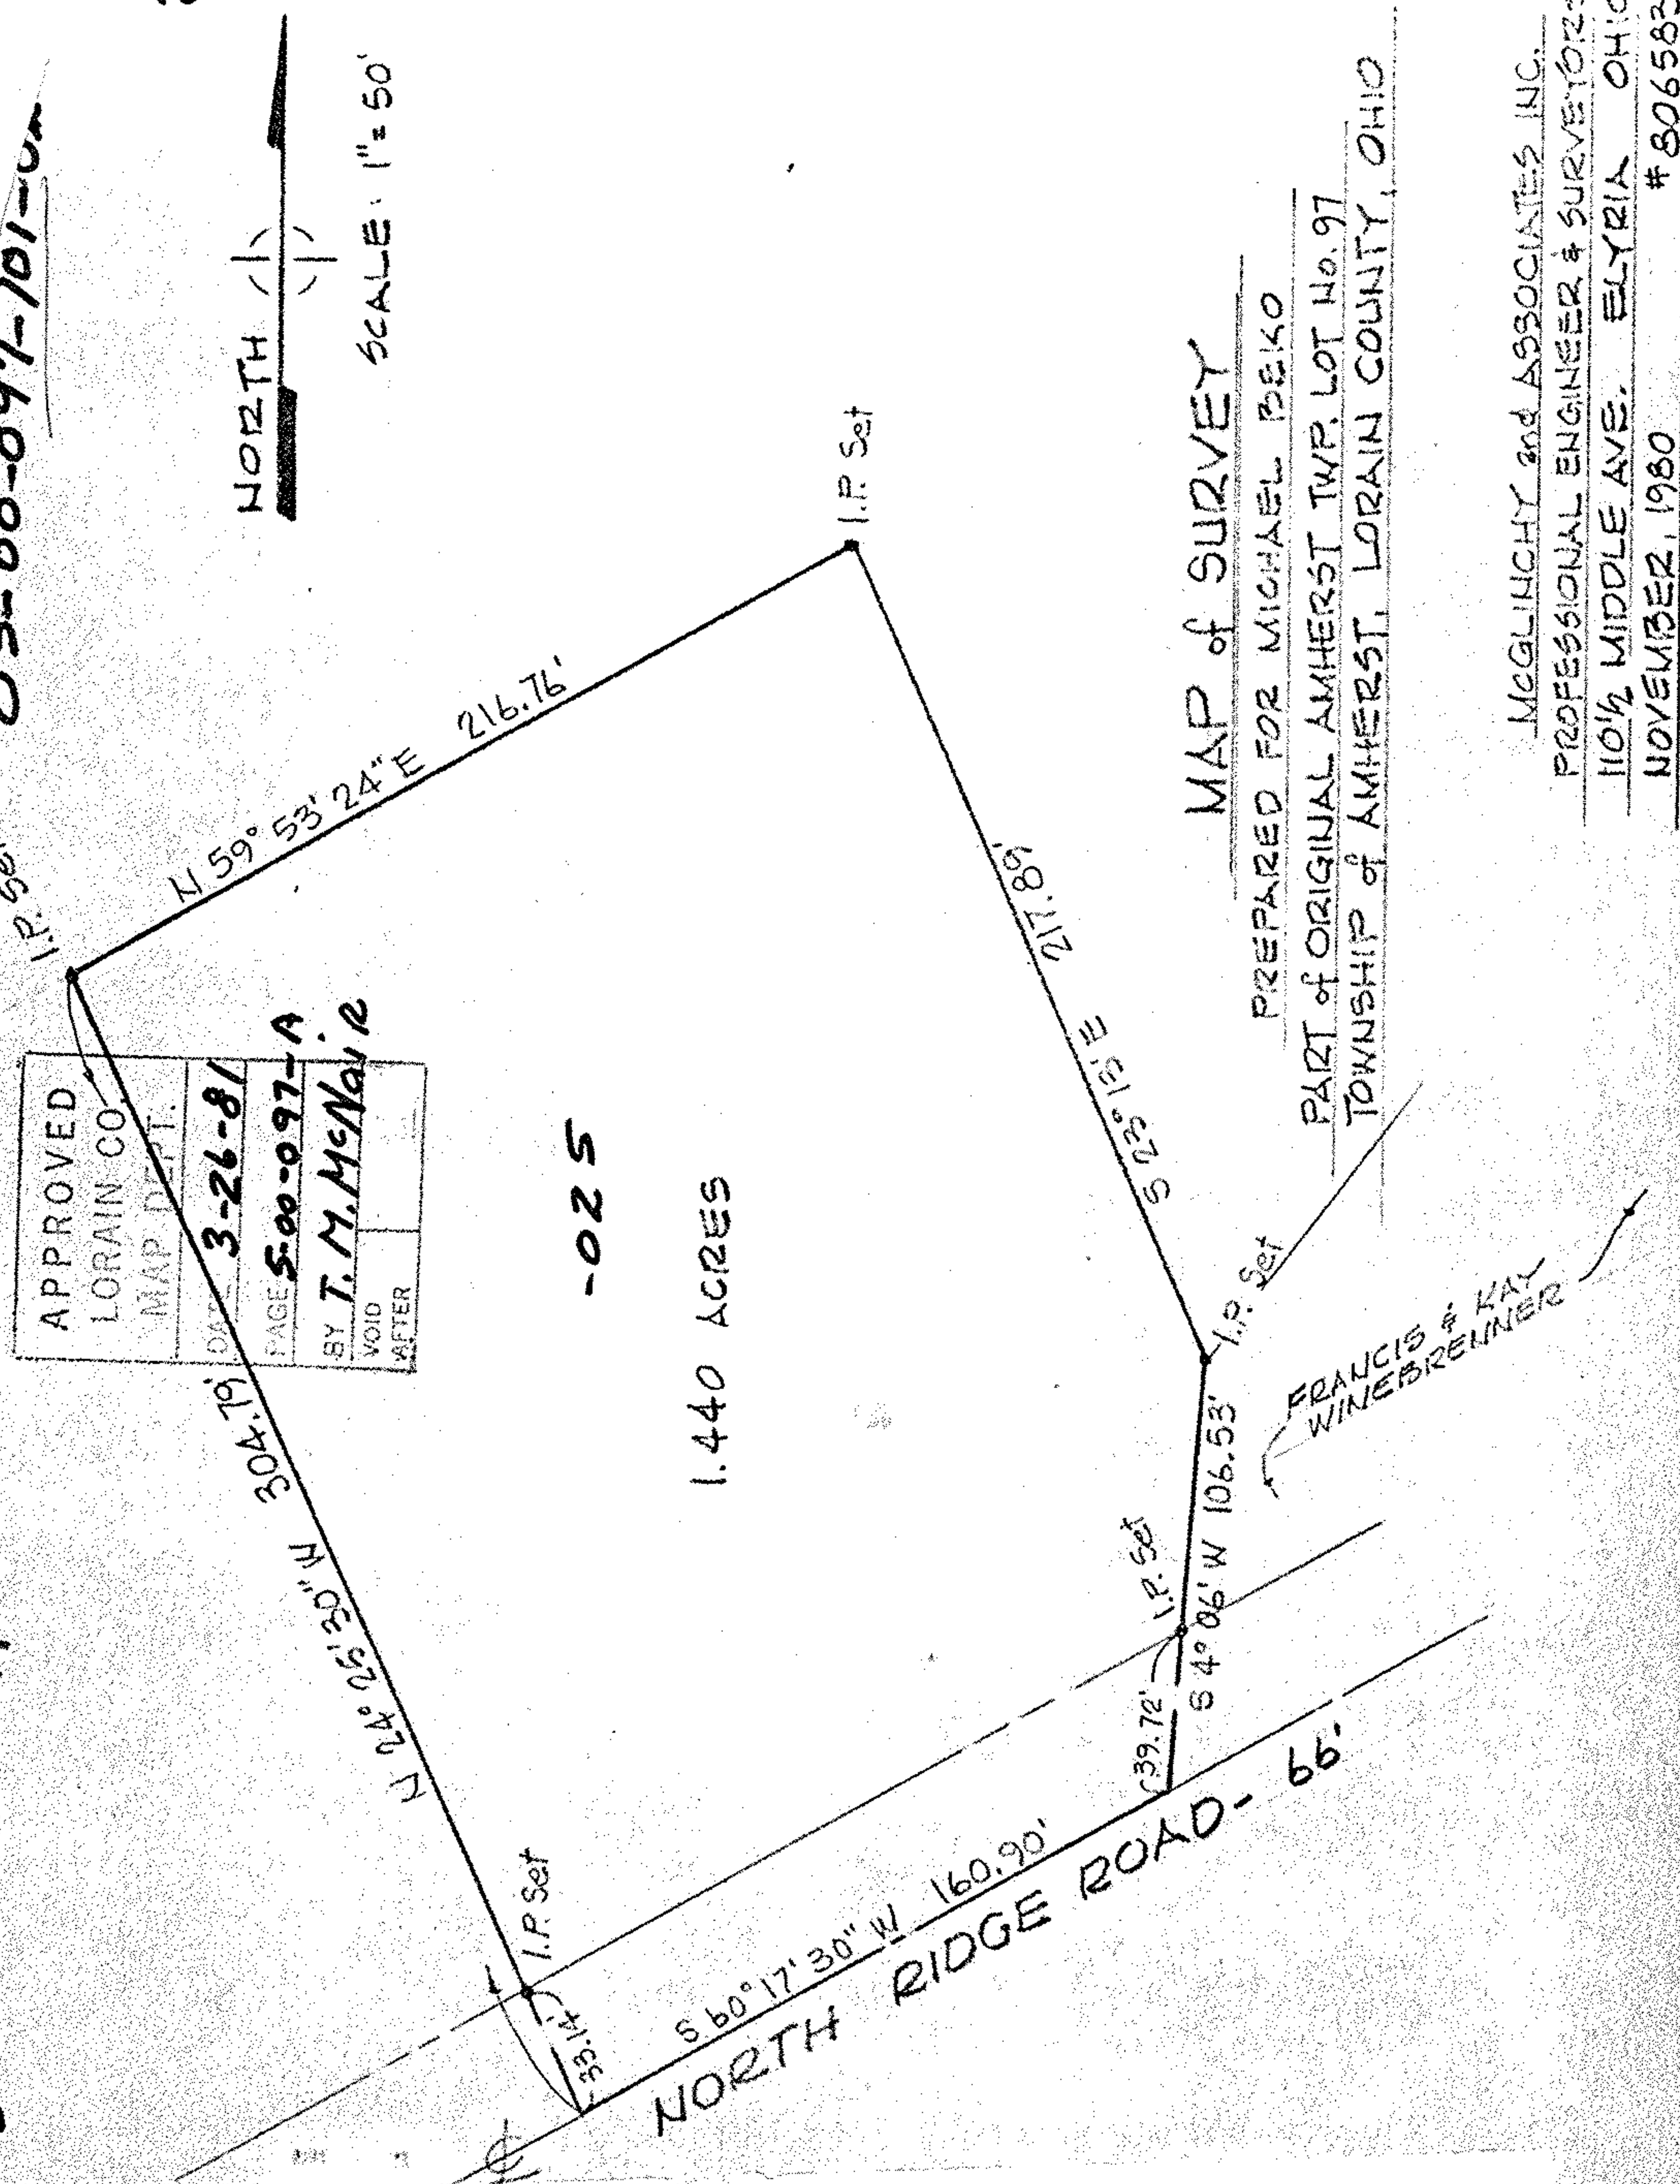


MAP of SURVEY

PREPARED FOR MICHAEL PEIKO  
PART OF ORIGINAL AMHERST TWP. LOT No. 97  
TOWNSHIP of AMHERST, LORAIN COUNTY, OHIO

McGLINCHY and ASSOCIATES INC.  
PROFESSIONAL ENGINEER & SURVEYOR  
110 1/2 MIDDLE AVE., ELYRIA, OHIO  
NOVEMBER, 1980 # 806582

FRANCIS & KAY  
WINEBRENNER

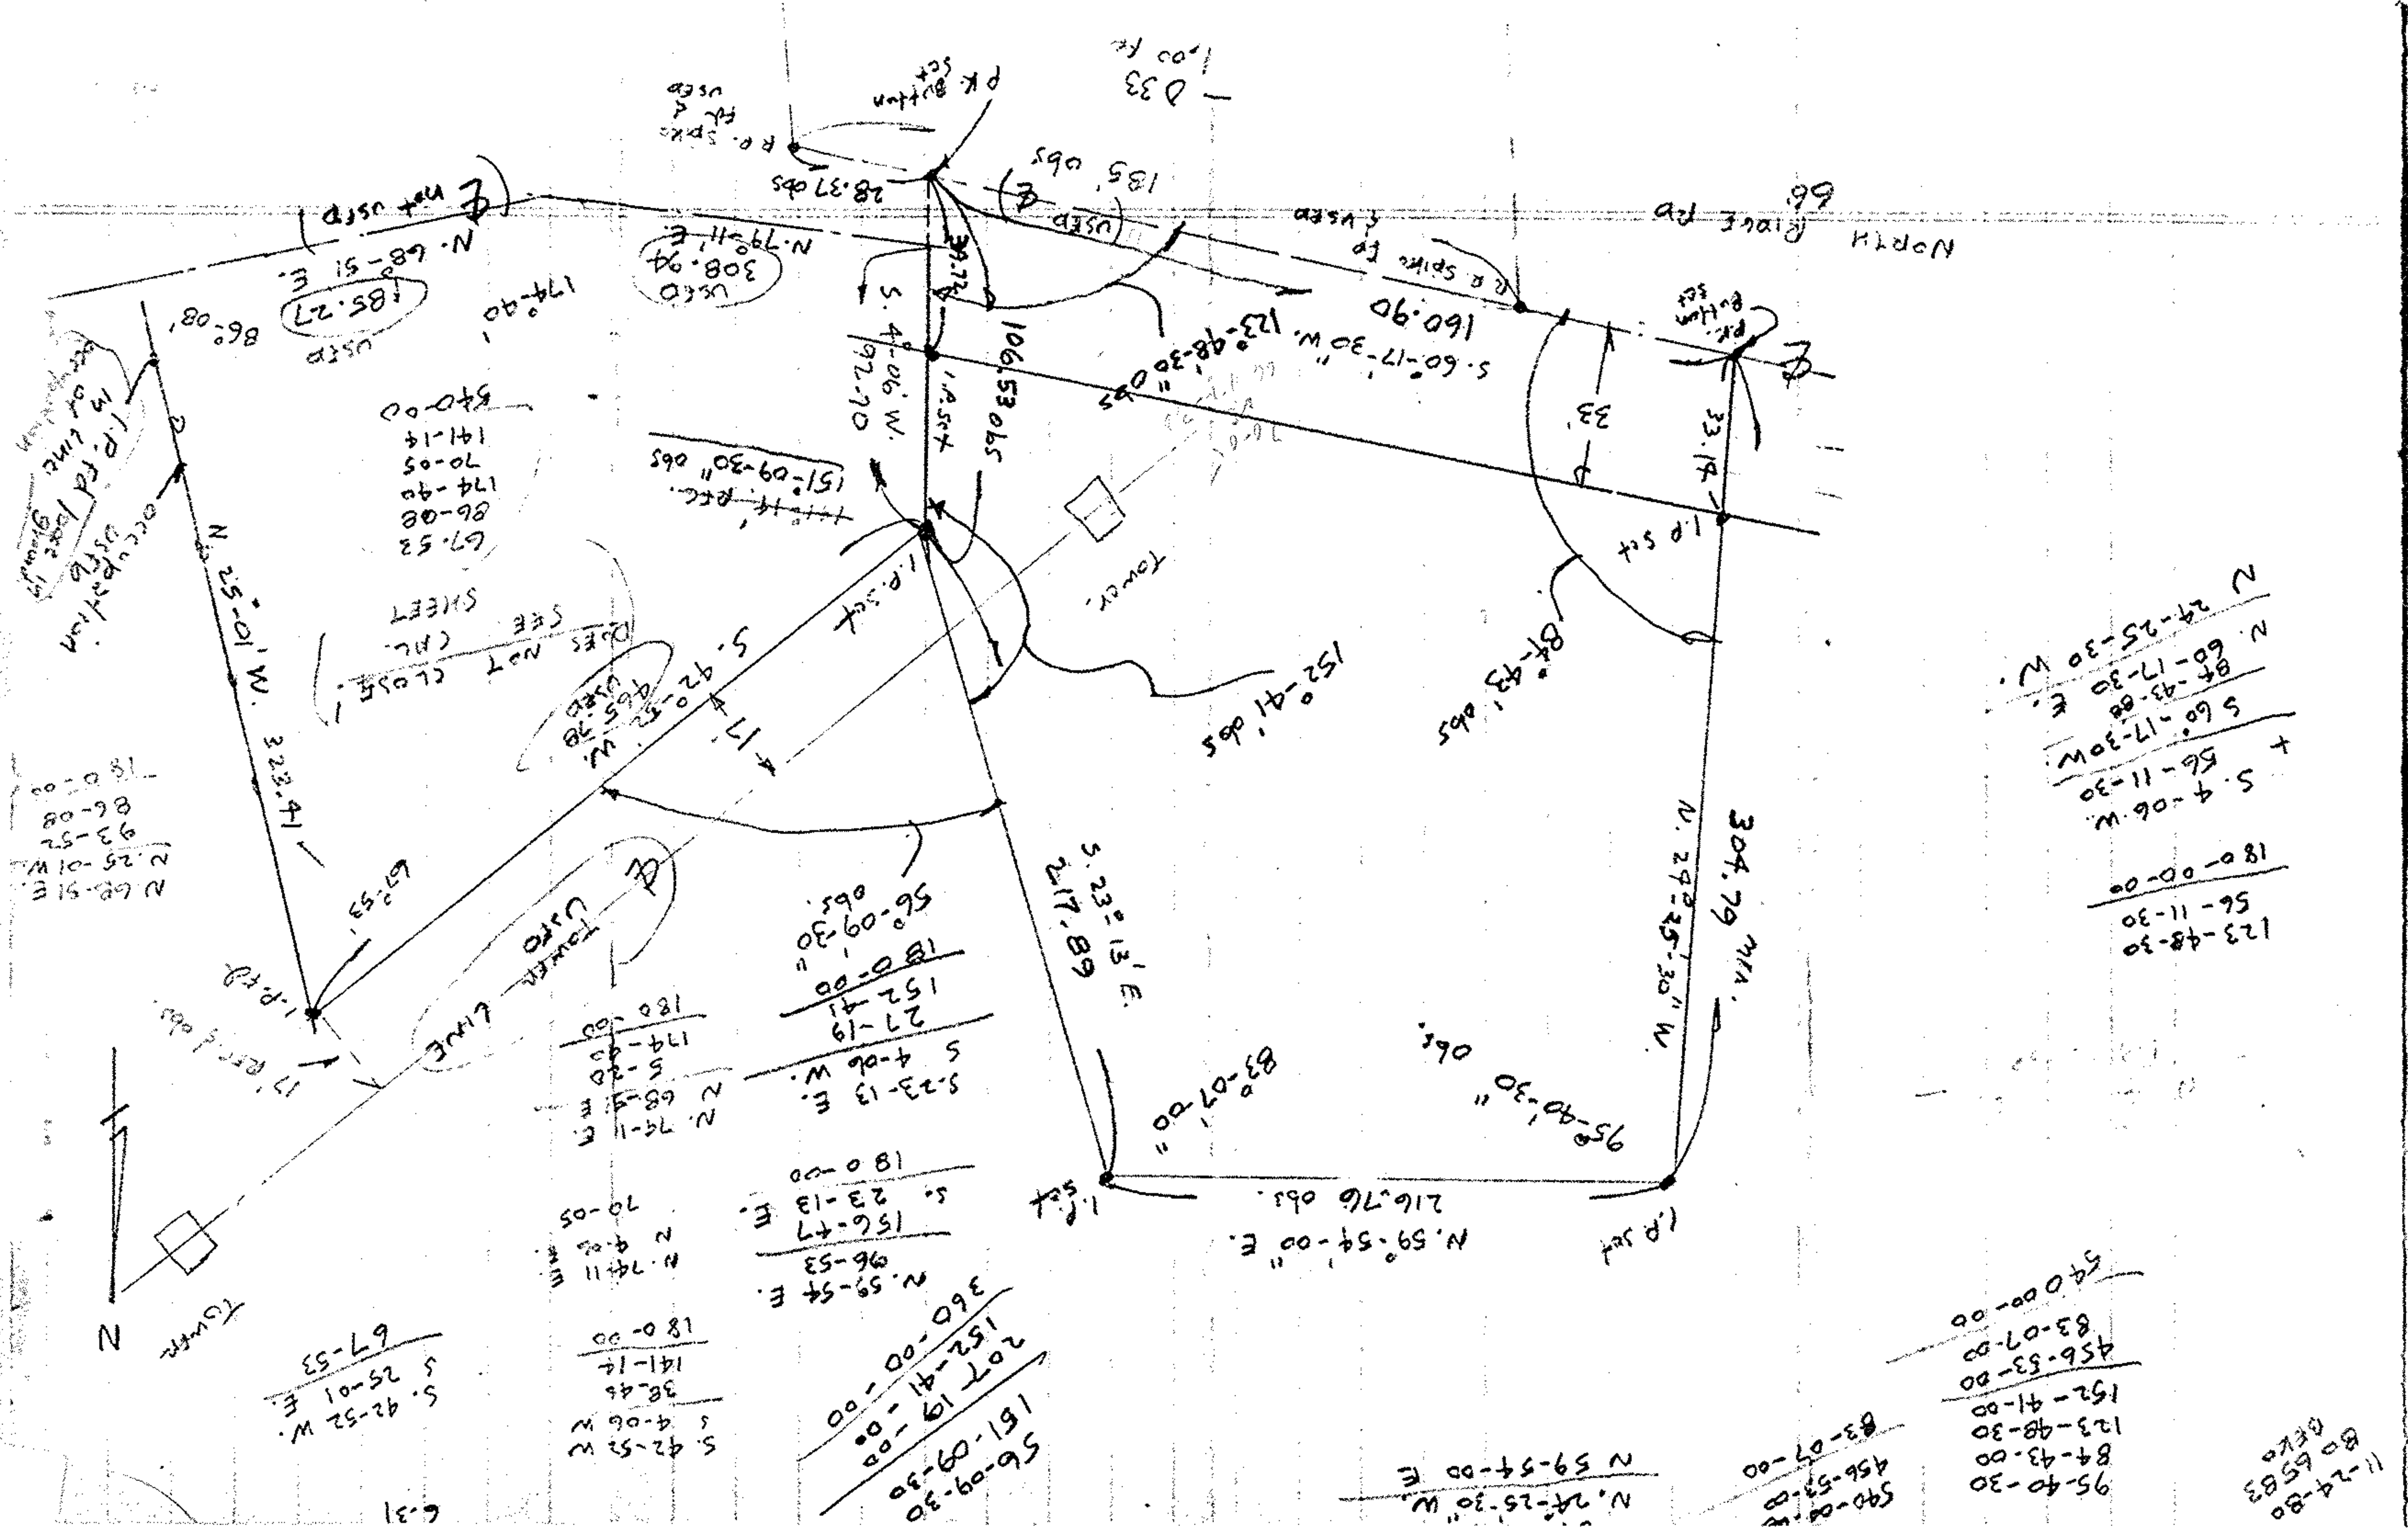

123-48-30  
56-11-30  
180-00-00  
5-4-06 W  
56-11-30  
56-17-30 E  
84-43-88  
N 60-17-30 W  
N 24-25-30 W

540-00-00  
456-53-00  
83-07-00  
152-41-00  
123-48-30  
84-43-00  
95-40-30  
456-53-00  
83-07-00

11-24-80  
806582  
0220

6-31  
5-42-52 W  
5-25-01 E  
67-53

180-00  
141-14  
38-46  
5-4-06 W  
5-42-52 W

56-09-30  
151-09-30  
207-19-00  
152-41-00  
360-00-00

180-00  
174-41  
5-20  
N 74-11 E  
70-05

N 59-54 E  
96-53  
156-47 E  
5-23-13 E  
180-00

180-00  
152-41  
27-19  
5-4-06 W  
5-23-13 E

56-09-30  
180-00  
152-41  
27-19  
5-4-06 W

2  
66-51  
93-19  
86-08  
12

174-40  
86-08  
174-40  
70-05  
141-14  
54-00

185-27  
N 68-51 E  
174-40  
174-40  
174-40  
86-08  
67-53

174-40  
174-40  
174-40  
86-08  
67-53

