

LEGEND:

- Iron pipe found ○
- Iron pipe set ●


0 50 100 200
FEET

NORTH



SCALE
1" = 100'

RICE ROAD 60'

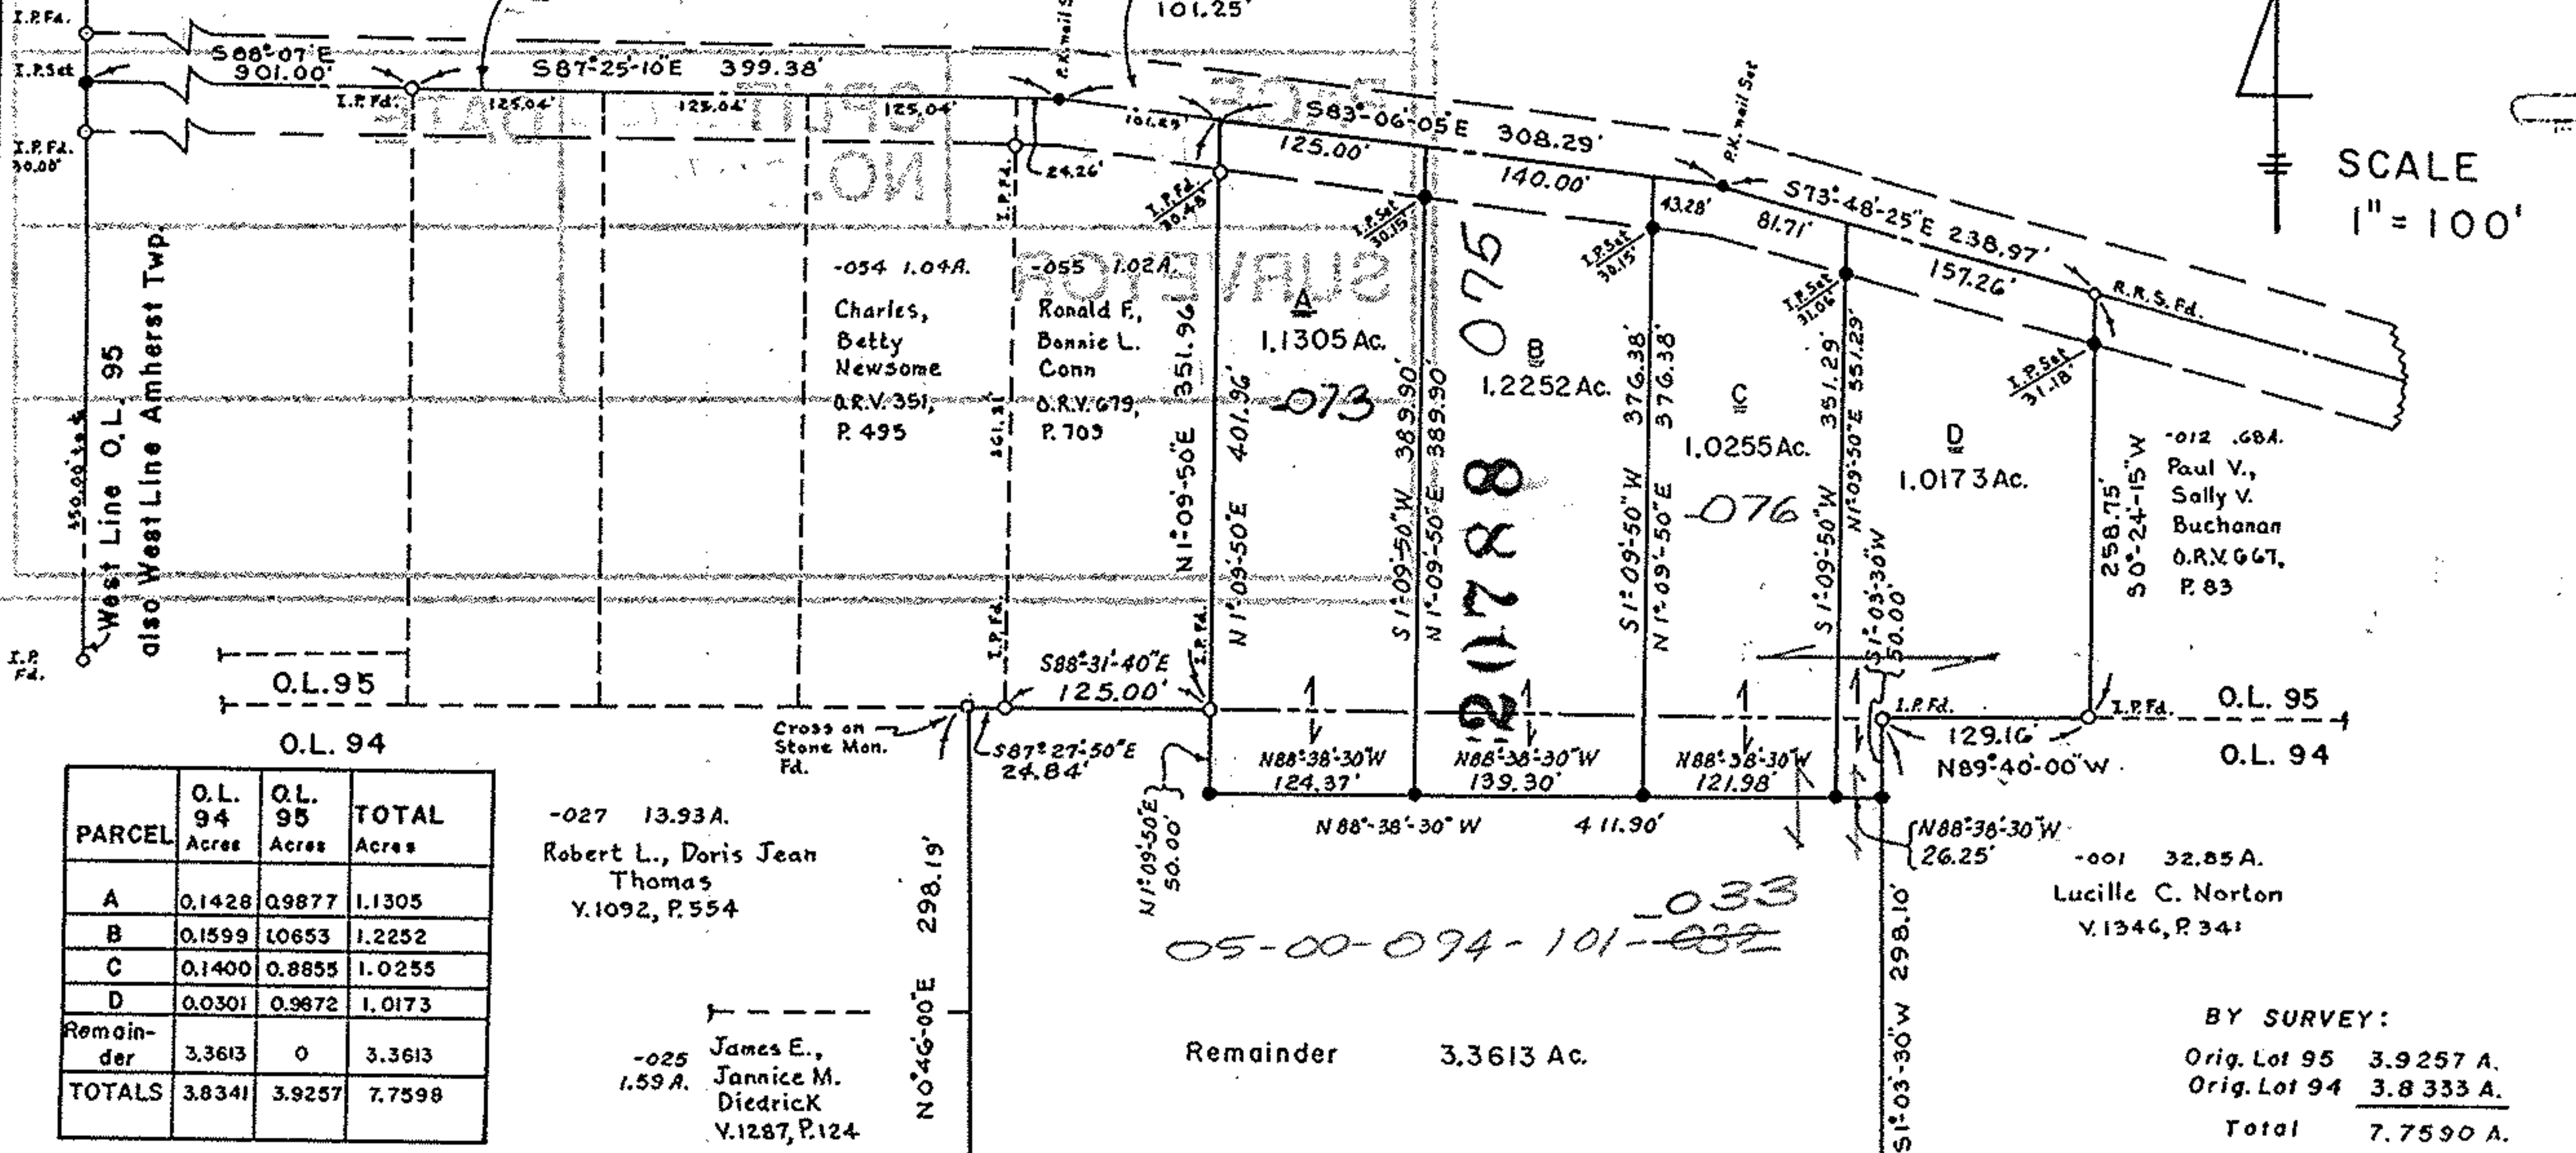

PARCEL	O.L. 94 Acres	O.L. 95 Acres	TOTAL Acres
A	0.1428	0.9877	1.1305
B	0.1599	1.0653	1.2252
C	0.1400	0.8855	1.0255
D	0.0301	0.9672	1.0173
Remainder	3.3613	0	3.3613
TOTALS	3.8341	3.9257	7.7598

-027 13.93A.
Robert L., Doris Jean Thomas
Y.1092, P.554

-025 1.59A.
James E., Jannice M. Diedrick
V.1287, P.124

Remainder 3.3613 Ac.

-001 32.85A.
Lucille C. Norton
V.1346, P.341

BY SURVEY:
Orig. Lot 95 3.9257 A.
Orig. Lot 94 3.8333 A.
Total 7.7590 A.

DEED REFERENCE
O.R.V. 808, P.1
JAMES S. & VERONICA J. KAROLAK

MAP OF SURVEY MADE, PART OF ORIG. AMHERST TWP, LOT NO. 94, 95, AMHERST TWP, LORAIN CO., OHIO.
Made at request of James S. Karolak
By Charles P. Waryu, Reg. Surveyor No. 5029
January, 1994

-026 1.26A. Bobby D., Treasa M. Osborne O.R.V. 507, P.611
-005 1.16A. Claude D., Virginia H. Osborne V.962, P.791
-007 1.09A. Wilbert E., Francis E. Martin V.968, P.350
-009 1.02A. Ronald E., Cherryll L. Poyle O.R.V. 483, P.908
-031 2.00A. Charles K. Dlugosz O.R.V. 562, P.294

20761
Charles P. Waryu
REGISTERED SURVEYOR No. 5029
20788

05-00-095-000-
05-00-094-101-

APPROVED
LORAIN CO.
MAP DEPT.

DATE 3-15-94
5-00-094-A
PAGE 5-00-095-A
BY CAROLYN FRANCIS
VOID # 20761

APPROVED
LORAIN CO.
MAP DEPT.

DATE 4-1-94
5-00-094-A
PAGE 5-00-095-A
BY CAROLYN FRANCIS
VOID # 20788