


7M. 5-20-094-C


SPLIT 05-00-094-105-015 6.92 A.
COMB -014 & SPLIT OF -015

NORTH

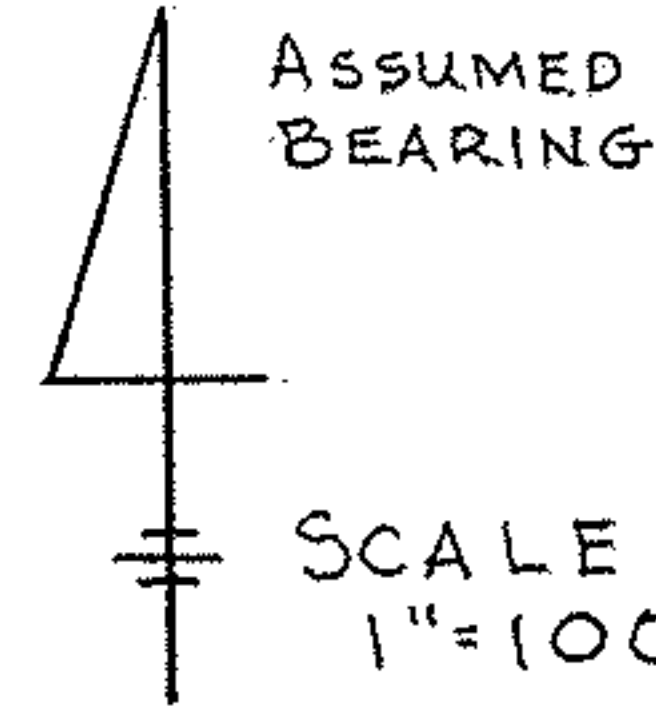

05-00-094-105-033, 034

PROPOSED SPLIT
25'x85' = 0.0485 A.

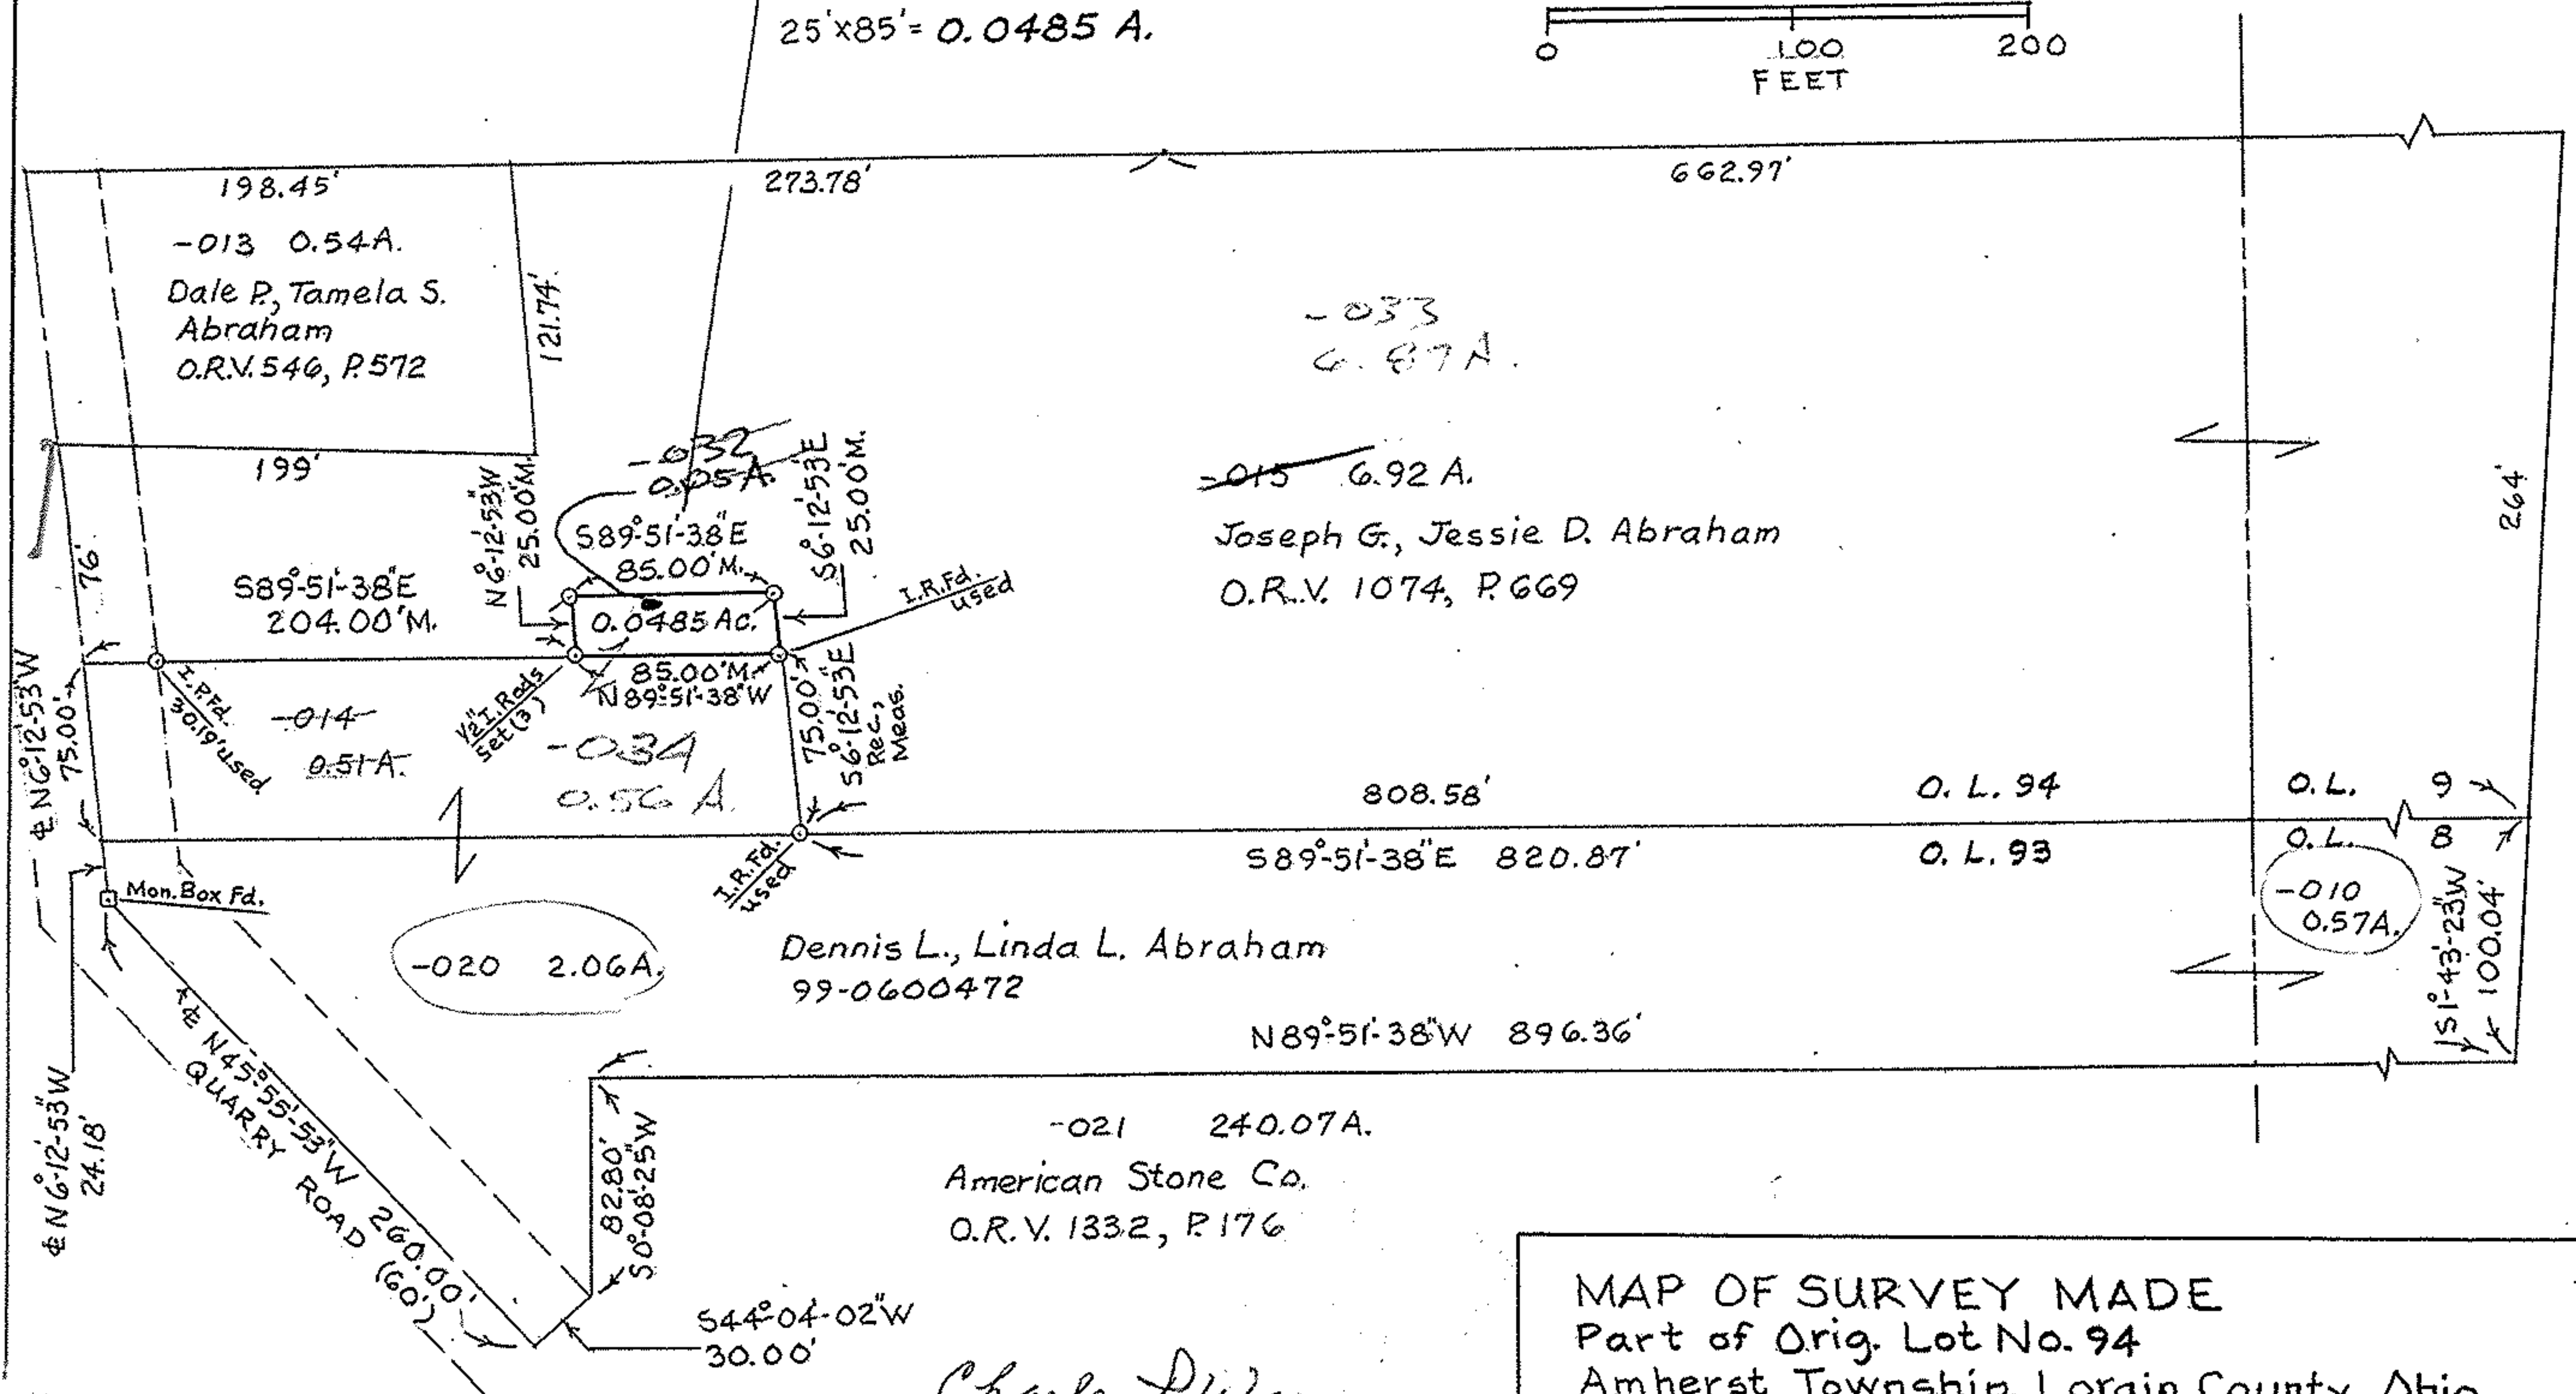

MAP OF SURVEY MADE
Part of Orig. Lot No. 94
Amherst Township, Lorain County, Ohio
For Dennis Abraham
September 2001

Charles P. Waryu
CHARLES P. WARYU
Registered Surveyor No. 5029