



KLEINODER-SCHMIDT and ASSOCIATES

ENGINEERS — SURVEYORS — CONSULTANTS IN LAND PLANNING
OHIO


ELYRIA - NORWALK - MEDINA

SURVEY

Sublot(s) _____
Subd'n _____

Township AMHERST Tract _____
Orig. Lot(s) 80 Sec. _____
County of LORAIN State of Ohio
Corporation _____

05-00-080-101-
COOPER FOSTER PARK ROAD 60' R/W

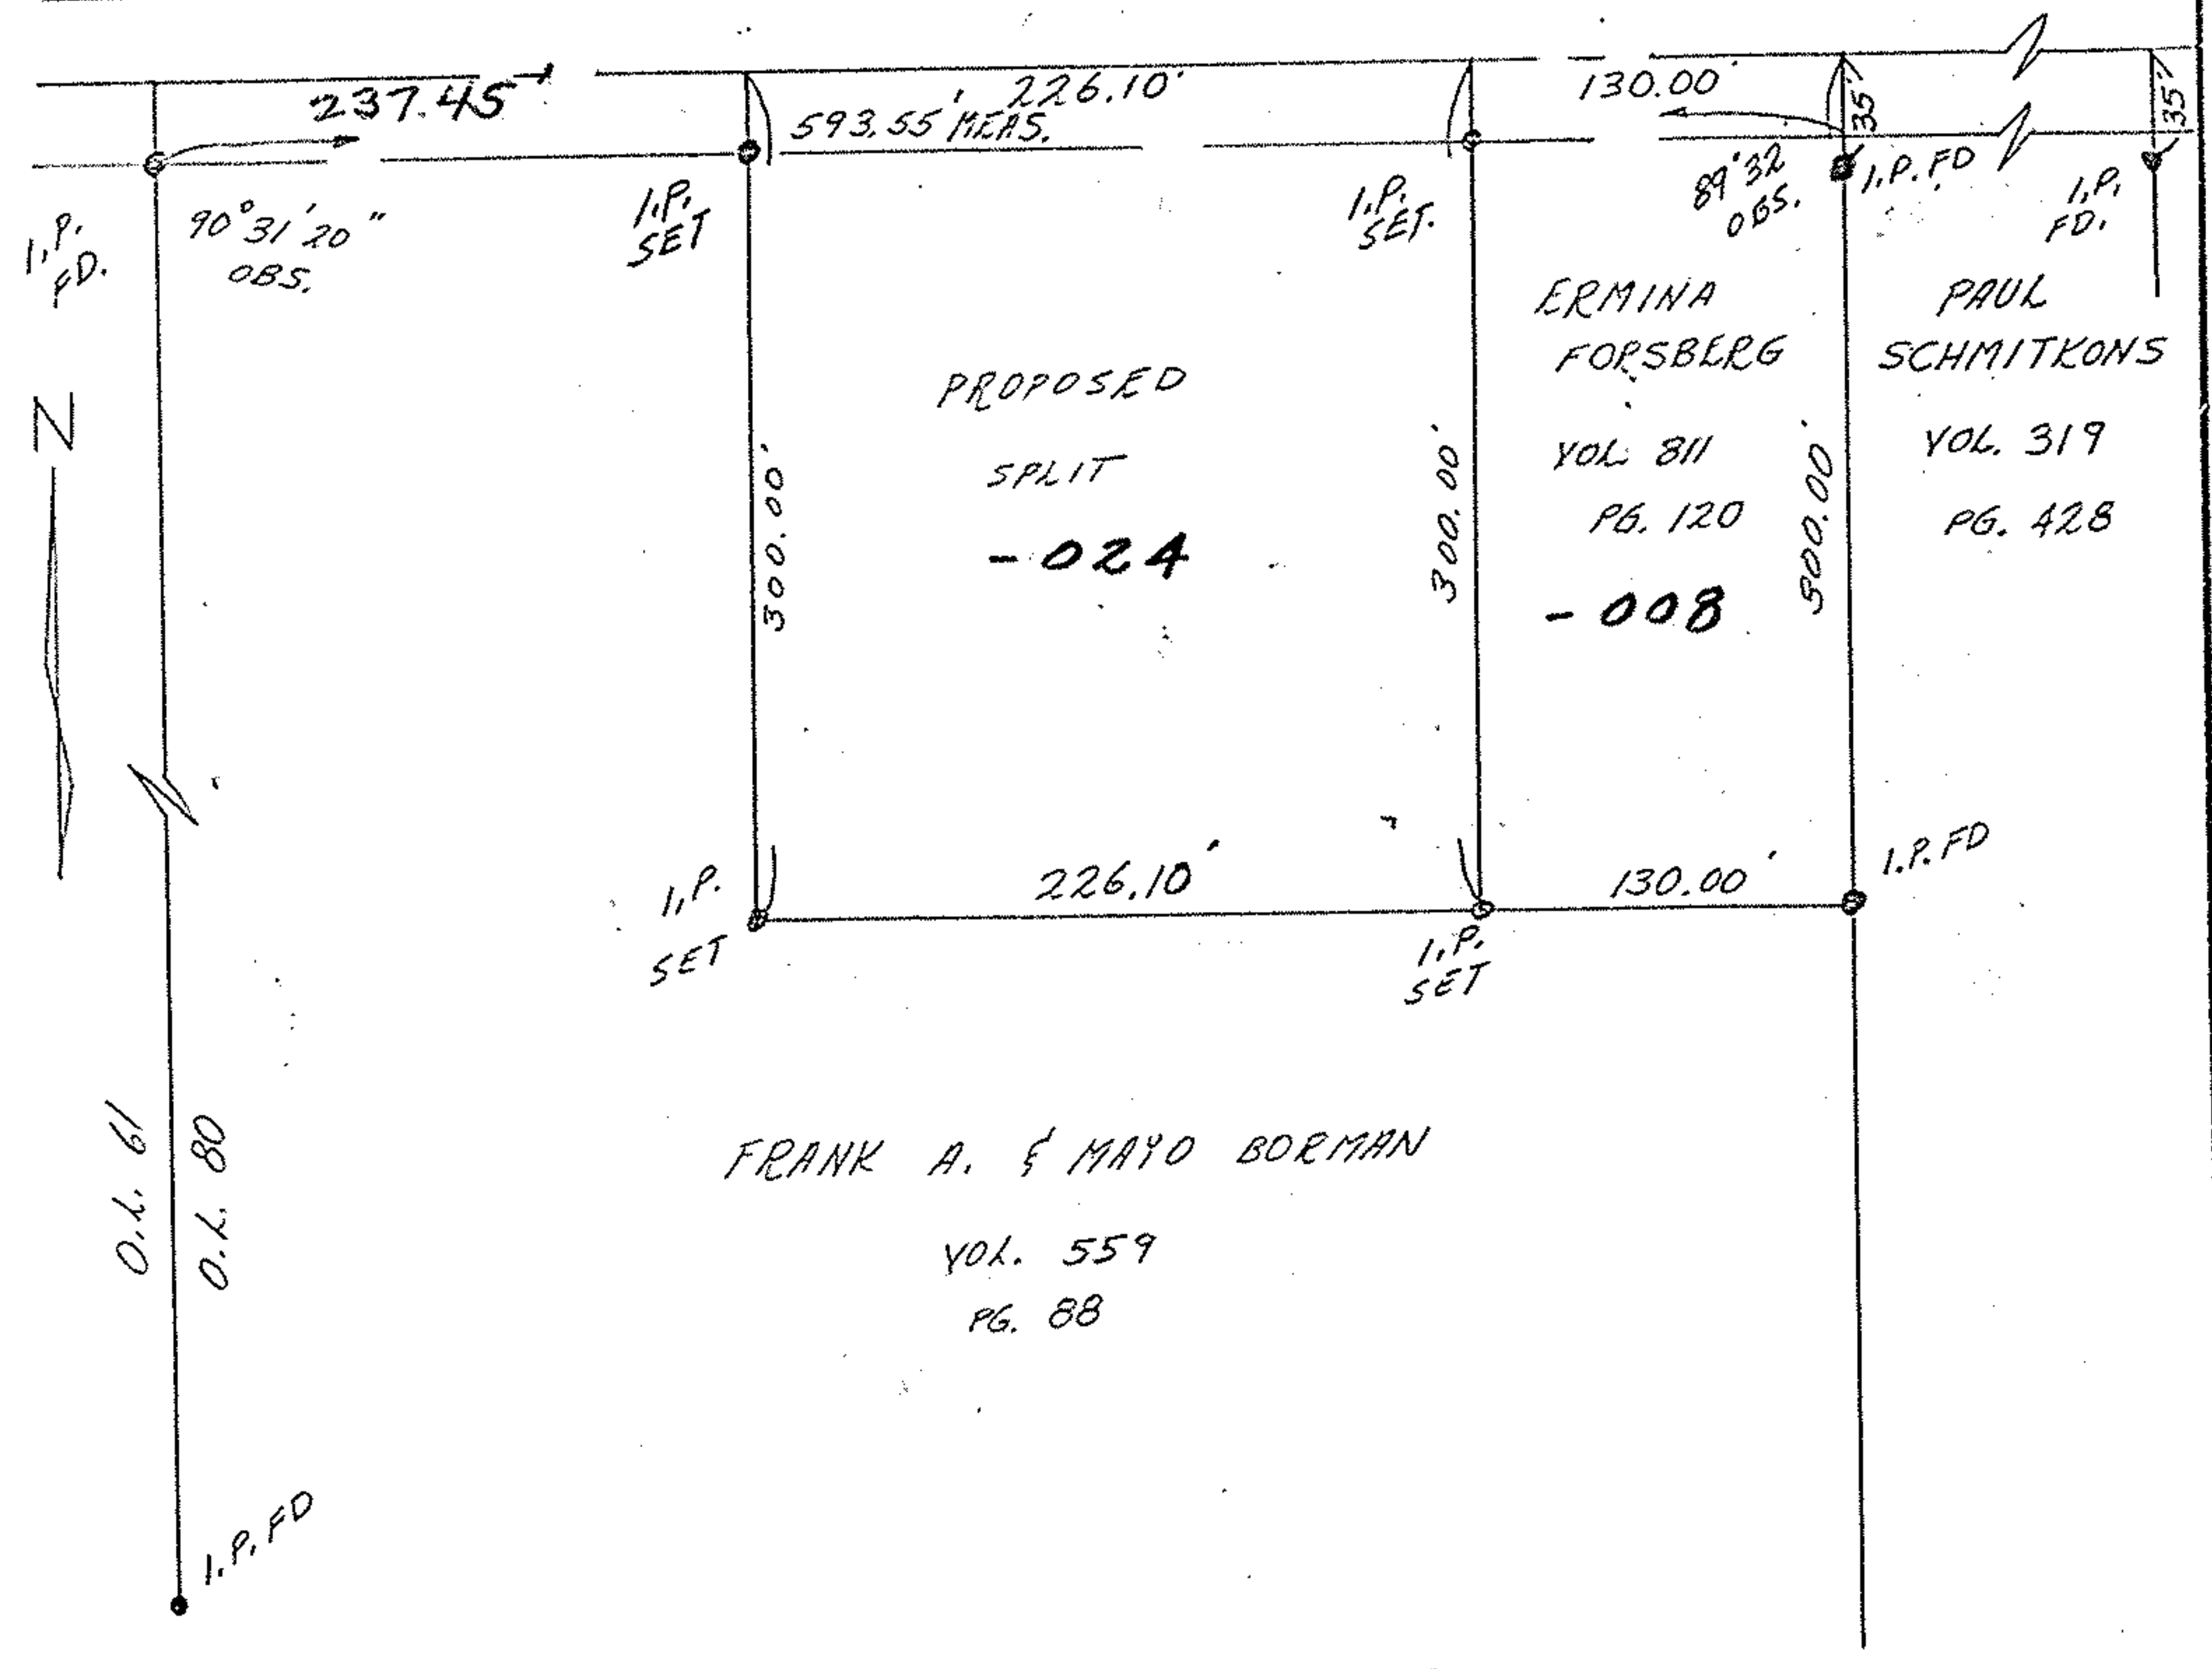

FRANK A. & MAYO BORMAN
VOL. 559
PG. 88

05-00-080-101-024,008
page 5-00-080-1A

Prepared for: FRANK A. BORMAN 591.36

Scale: 1"=100' Date: 7/6/76 Dr. by: KPC Job No: 76-20