


NOTES: ○ indicates iron pin set June of 1975 unless otherwise designated.
 ● indicates iron pin set on May 10-1977.

1.P.Fd. Rusted off

O.L. 64

25'

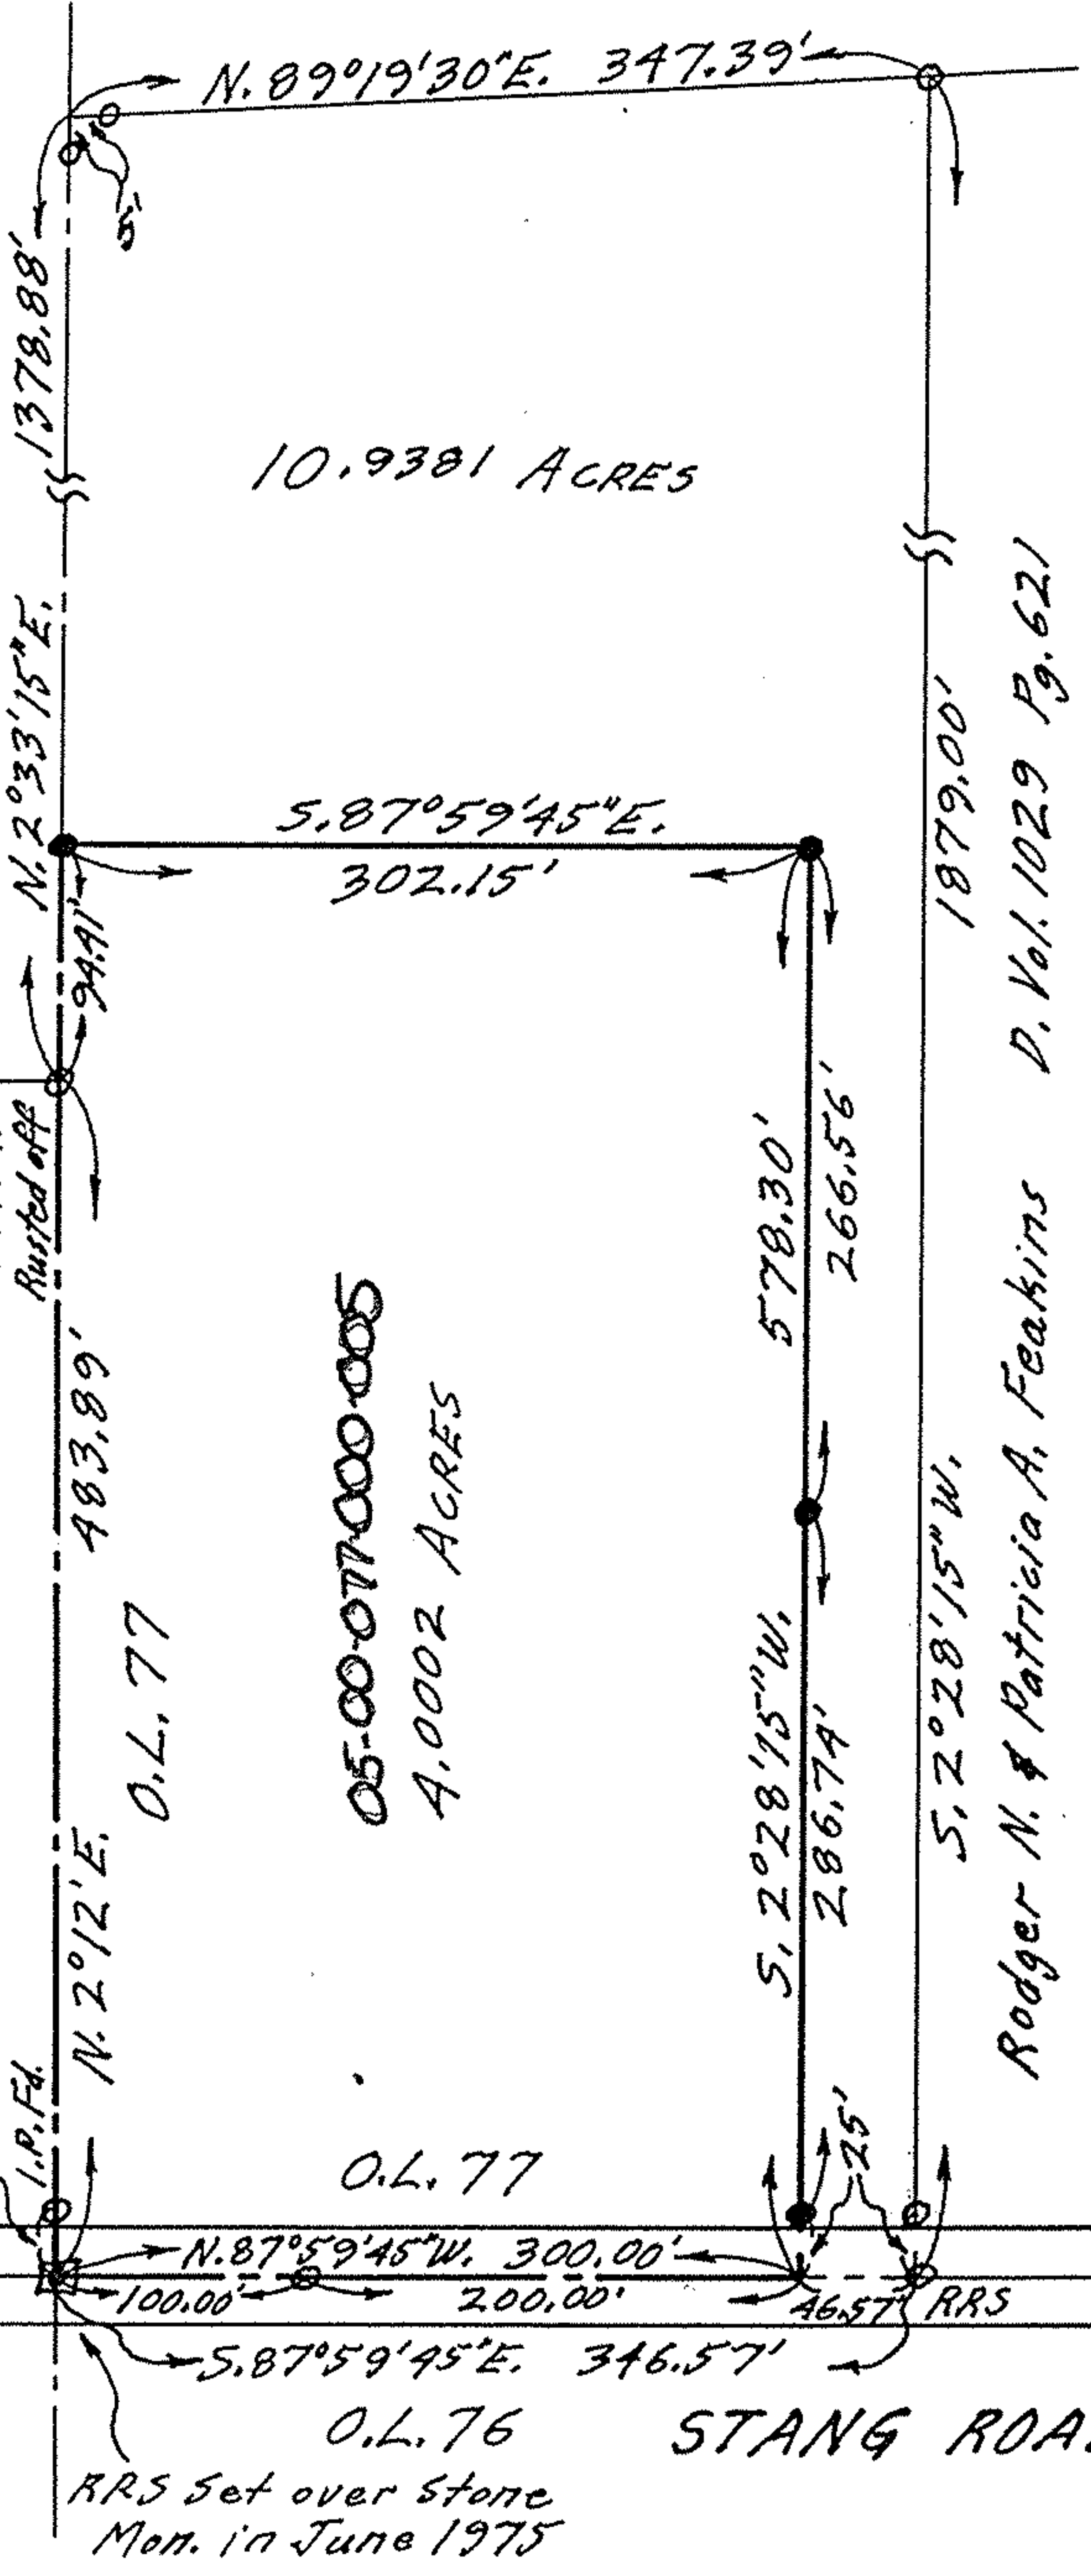

10.9381 ACRES

05-00-077-000-005
 4.0002 ACRES

O.L. 77

O.L. 76 STANG ROAD 40'
 RRS set over stone Mon. in June 1975

Rodger N. & Patricia A. Feakins D. Vol. 1029 Pg. 621

PLAT OF SURVEY FOR
 VICTOR A. & VICTORIA M. KEIFFER



ORIGINAL LOT 77 - AMHERST TWP.
 LORAIN COUNTY - OHIO

AMHERST TWP.

SCALE: 1"=100' MAY 10-1977

1.P.Fd. in Mon. Box & Twp. Line
 WEST RIDGE ROAD 60'

Gary E. Penfound

Reg. Surveyor No. 4957

ELYRIA TWP.