


04-00-007-104-001

Belmar Beach Assn.

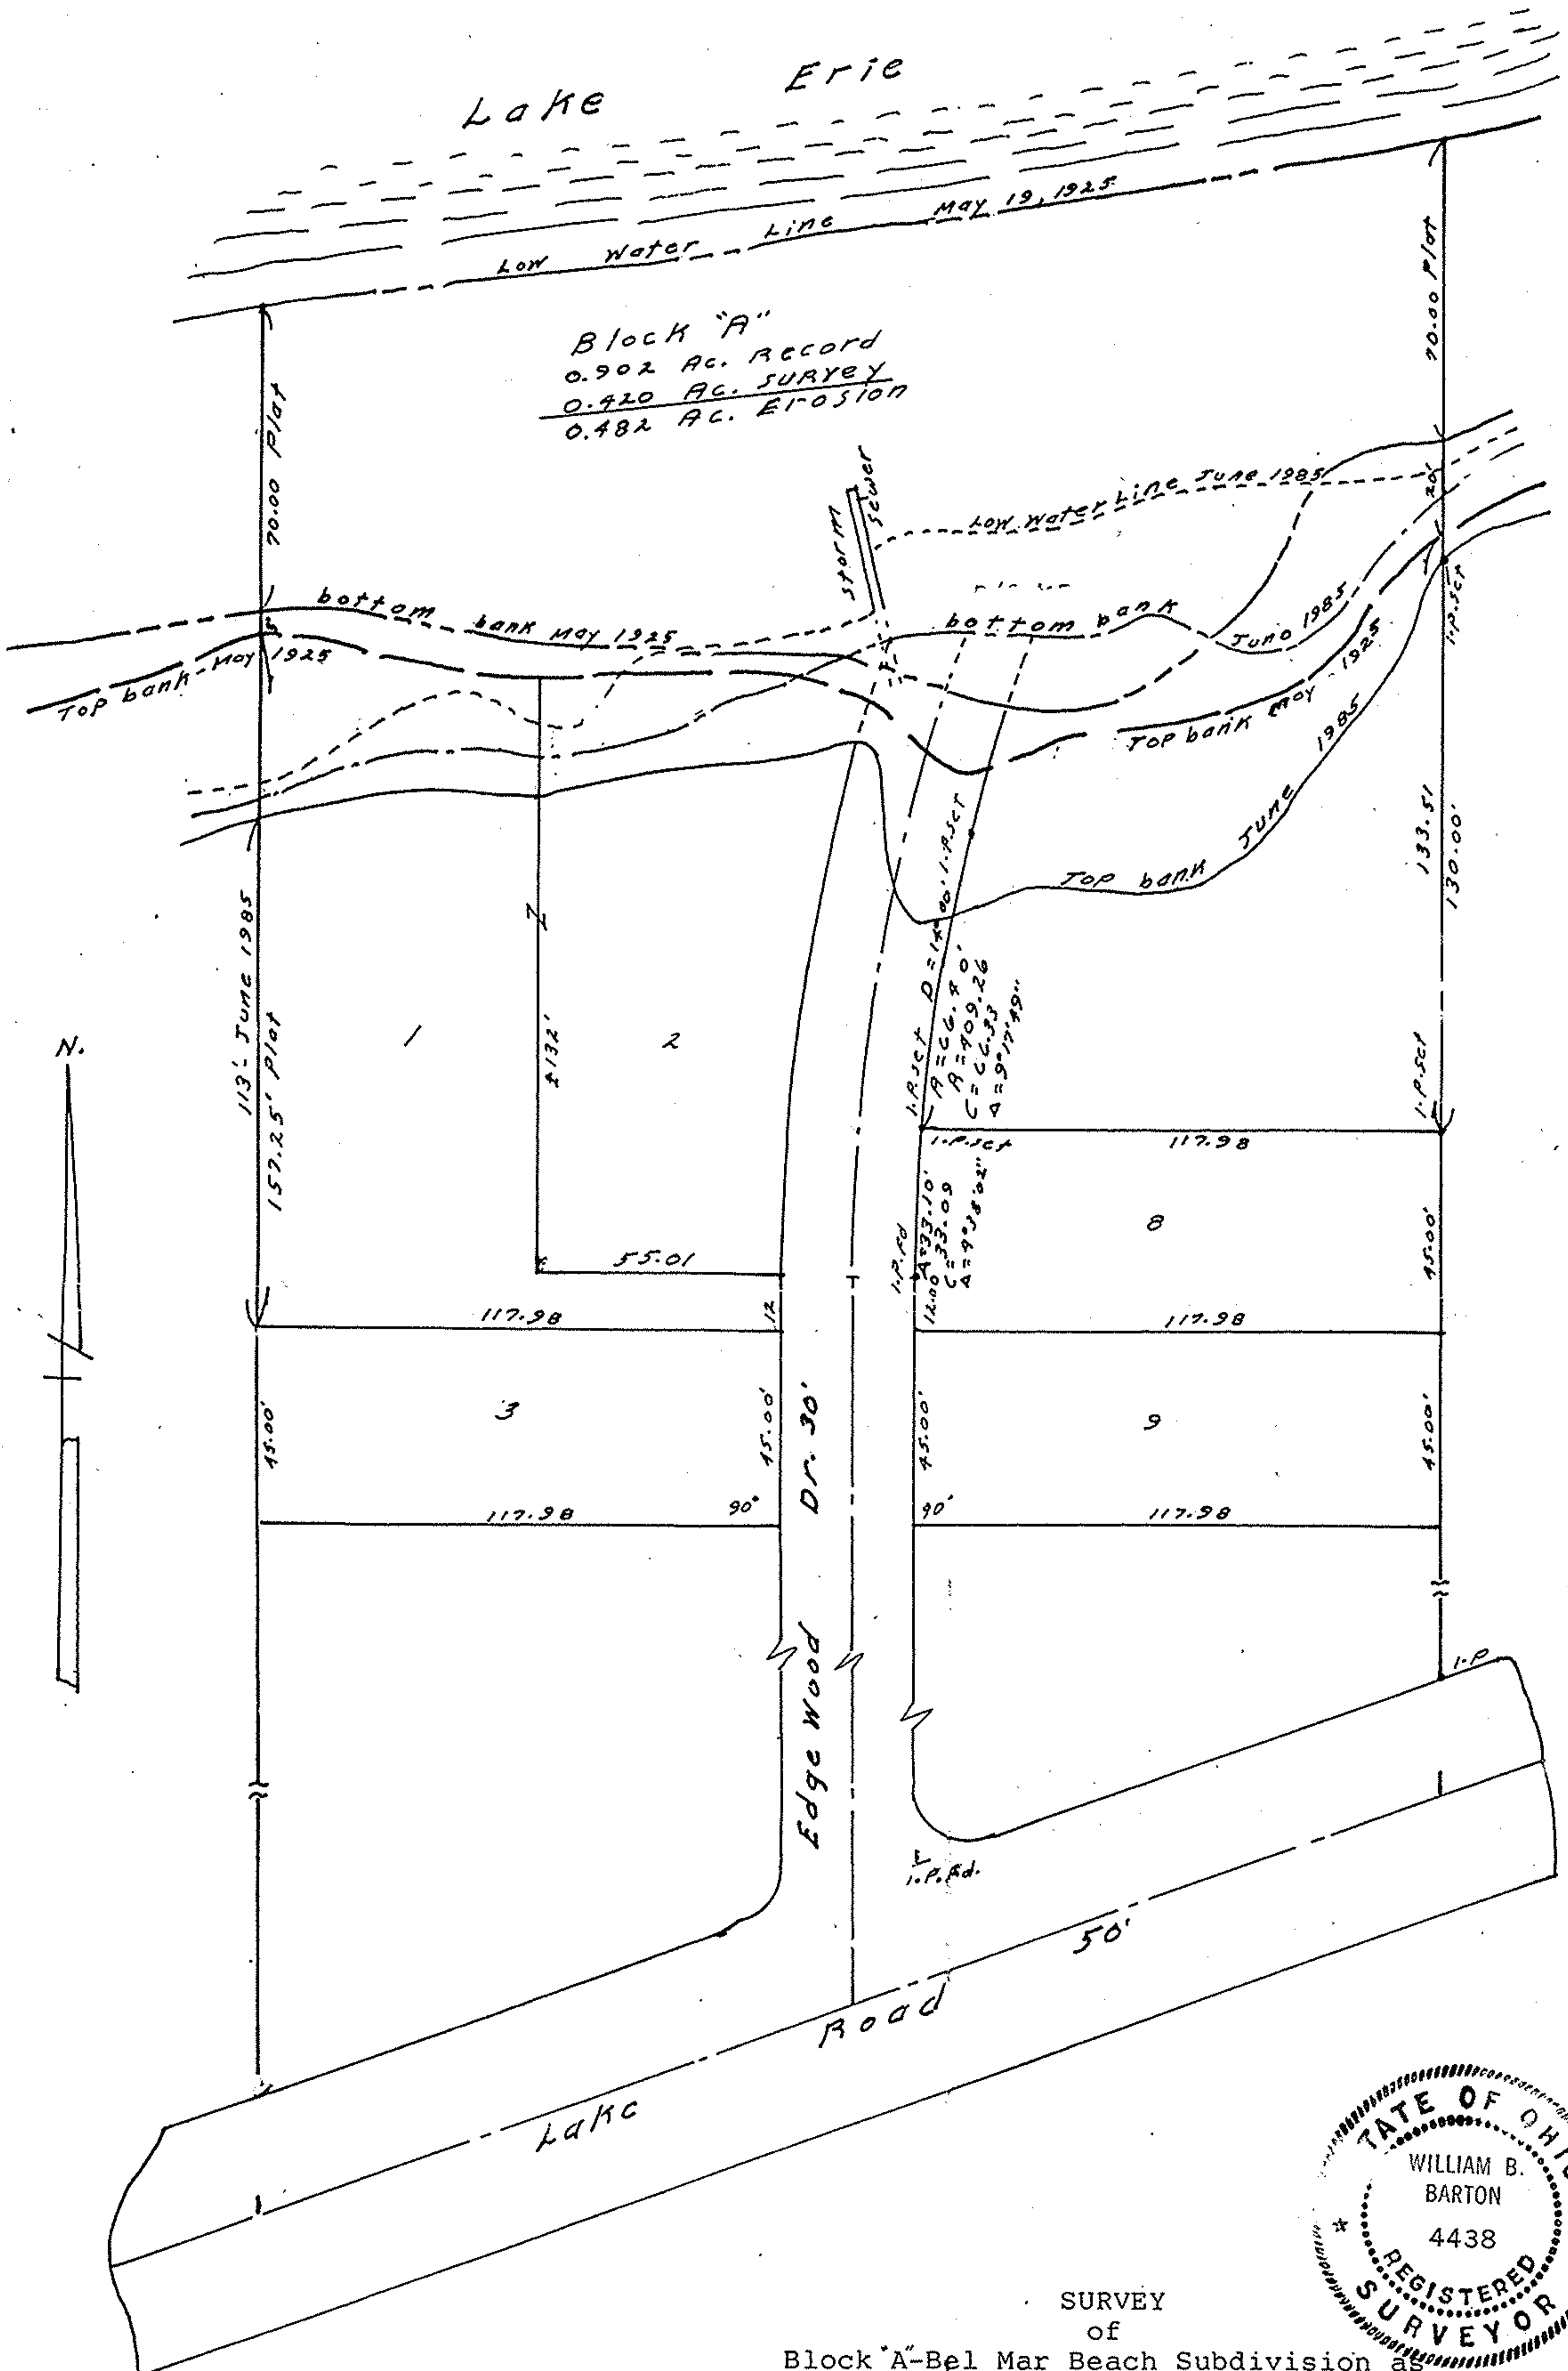

I hereby certify that the above plat is a true and correct survey made by me June 14, 1985.

William B. Barton
William B. Barton
Reg. Surveyor No. 4438
188 Parkwood Ave.
Avon Lake, Ohio 44012

SURVEY
of
Block "A"-Bel Mar Beach Subdivision as
recorded May 19, 1925 in Lorain Co.
Record of Plats, Volume 12, page 1,
and being part of Section No. 7, Avon
Twp., now city of Avon Lake, Lorain
Co., Ohio. Scale 1"=40' June 14, 1985.

