
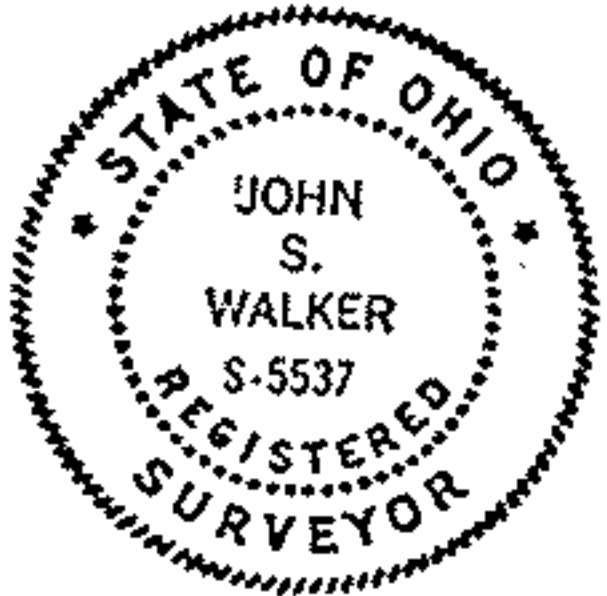


4 W-11-2

WALKER & ASSOCIATES • PROFESSIONAL LAND SURVEYORS

11600 Kader Drive, Parma, Ohio 44130 845-0597

NAME Donald Zadorozny
 DATE Oct. 1982 CITY Avon COUNTY Lorain
 SCALE 1"=40' ORIG. LOT 11 V. 1032 P. 747
 SUBDIVISION _____

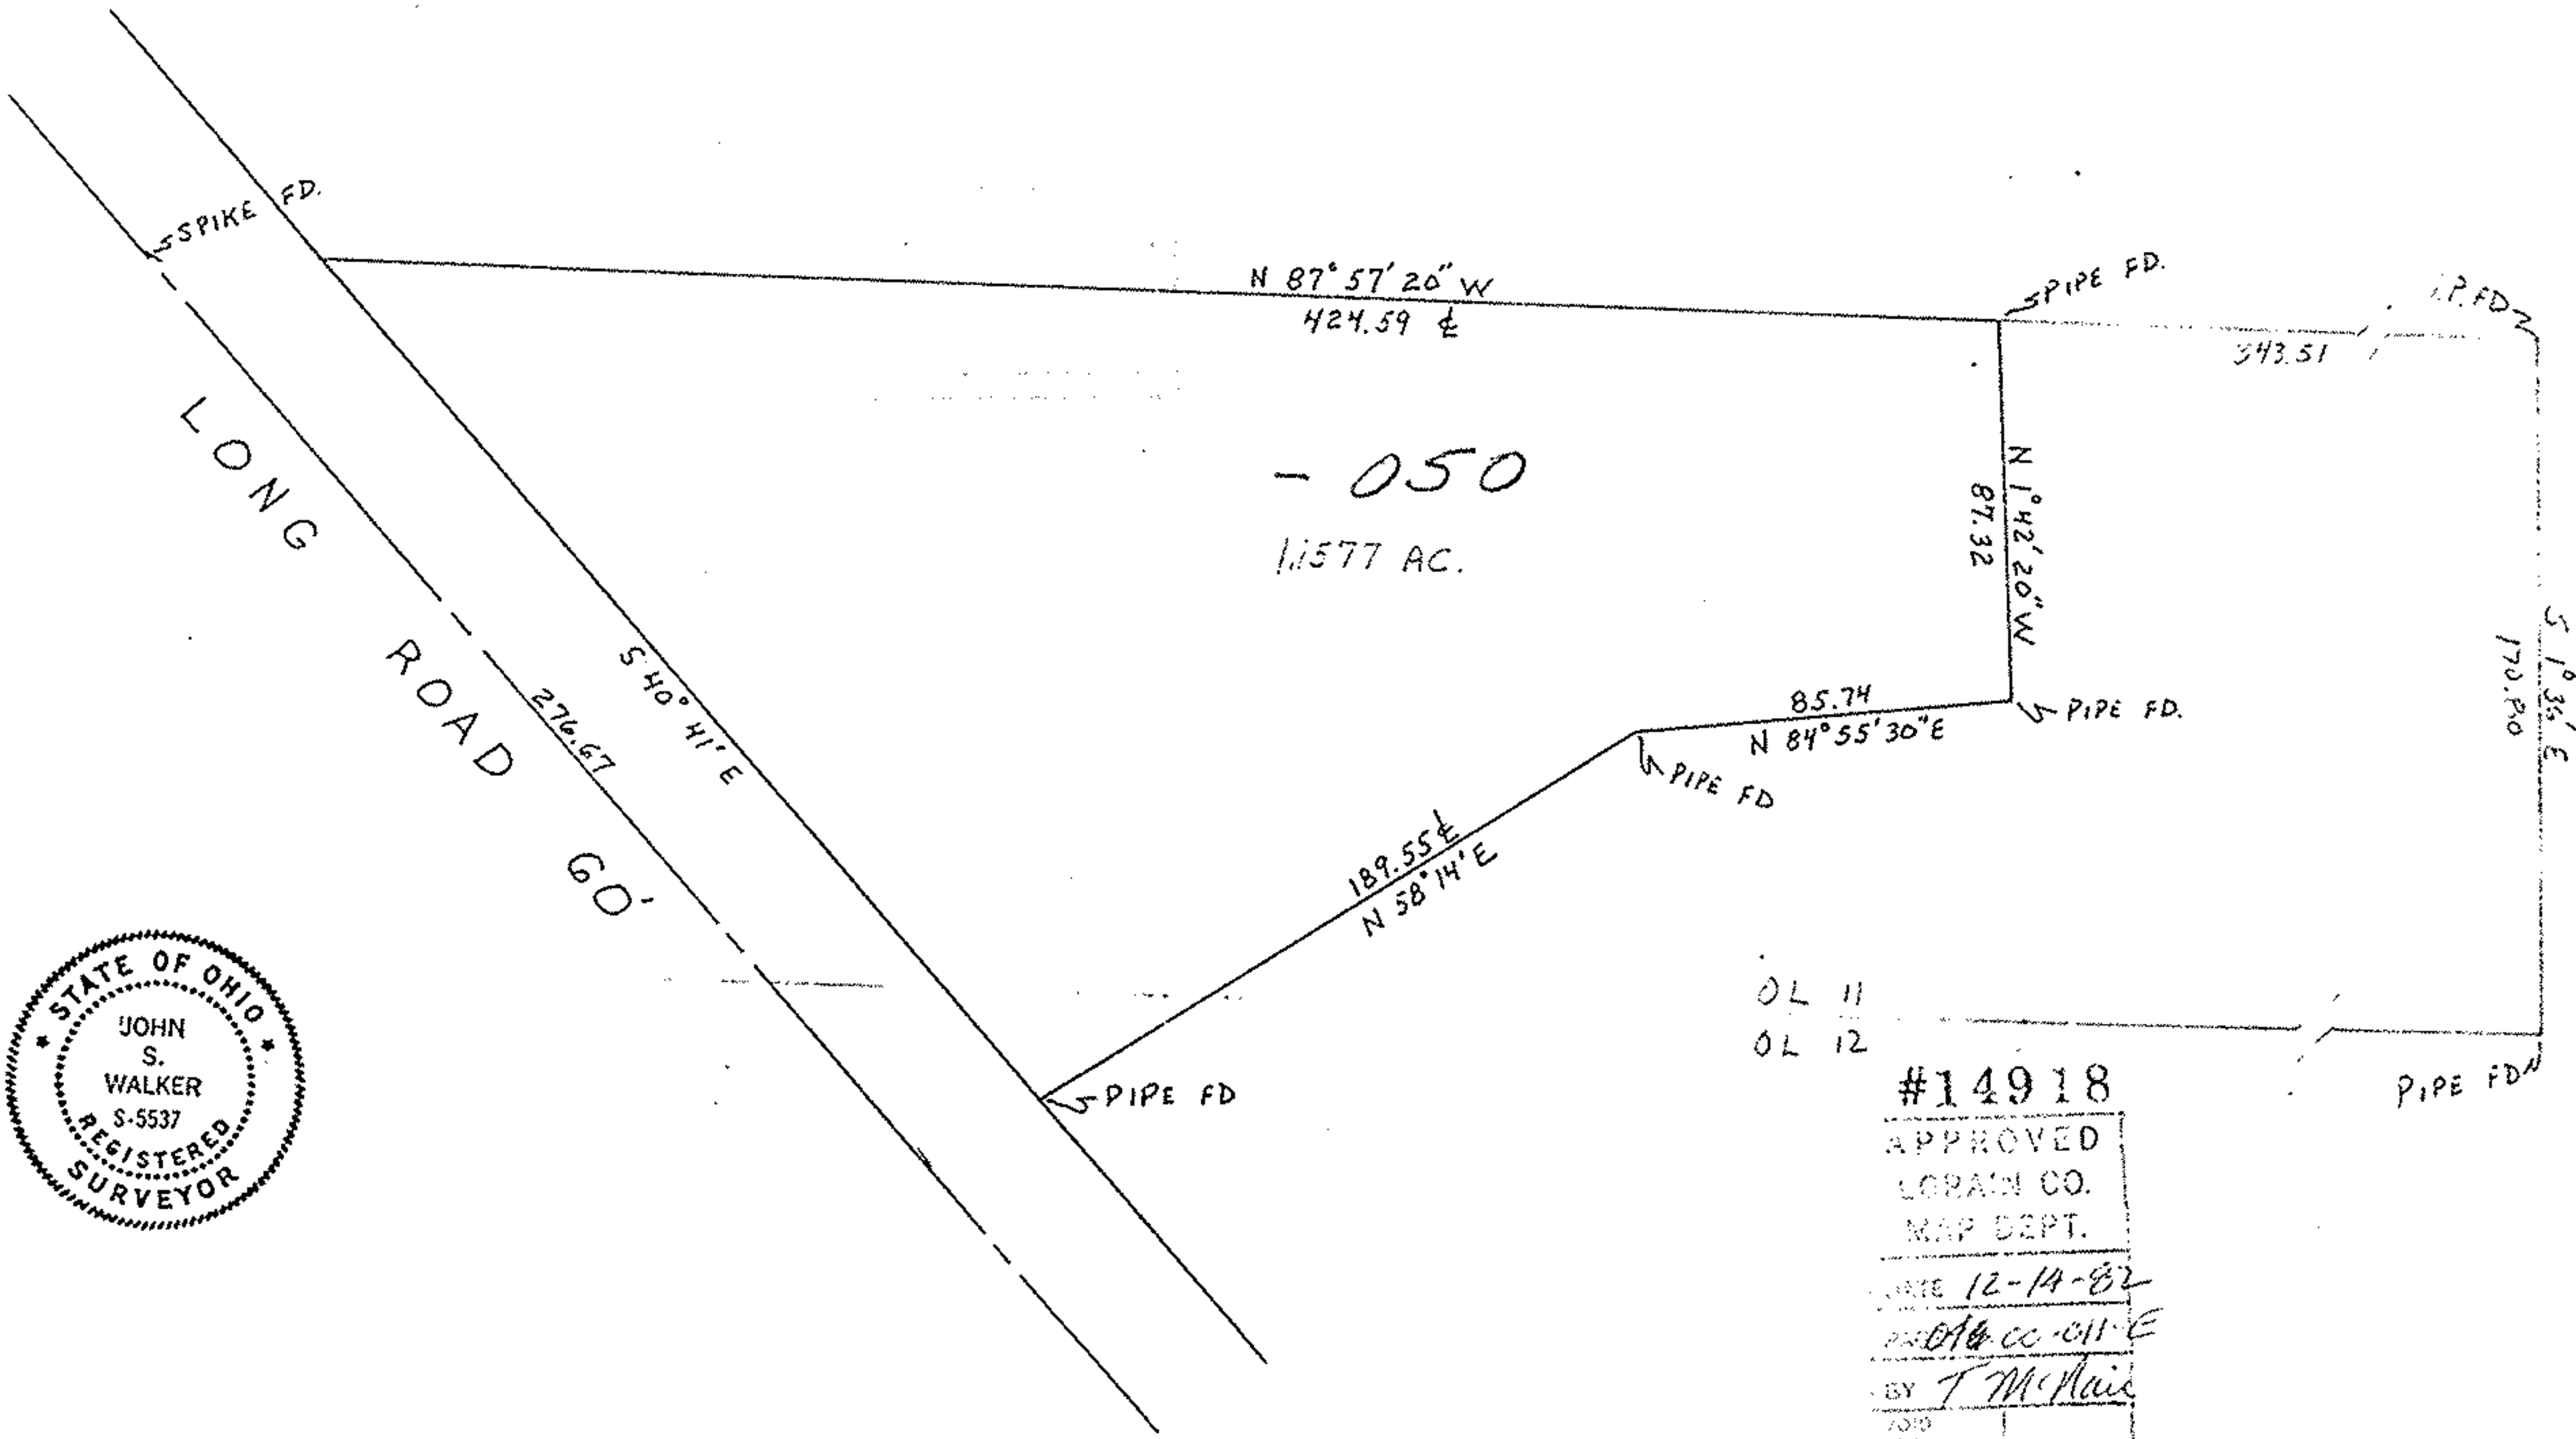

OL 11
OL 12

#14918
 APPROVED
 LORAIN CO.
 MAP DEPT.
 DATE 12-14-82
 BY T. McHale