

DEED OF LAND FOR ROSS JOHNSON  
CITY OF AVON - LORAIN COUNTY - OHIO

PART OF ORIGINAL AVON TOWNSHIP SECTION NO. 13

SCALE: 1" = 40'  
MAY 1979

IRON PIN MONUMENTS WERE FOUND OR  
SET AS SHOWN. DISTANCES ARE GIVEN IN  
FEET AND DECIMAL PARTS THEREOF.  
ALL OF WHICH WE CERTIFY TO BE CORRECT.

#12746

APPROVED
LOCAL
MAY 1979
DATE 5-30-79
4-00-013-E
Carlton F
v.J. AFTER 12746



*Vincent C. McGraw*  
PROFESSIONAL ENGINEER

GEORGE S. ZOLD VOL. 1080 PAGE 200

NORTH 68°-37'-00" WEST 2681.54 DEED # 12746

I.P. FIND  
CHK'D


IRON PINS FOUND &  
CHECKED ALONG THIS LINE

04-00-013-000-114

4-00-013-E, F.

BERTRUDE A. JOHNSON

VOL 853 PAGE 509

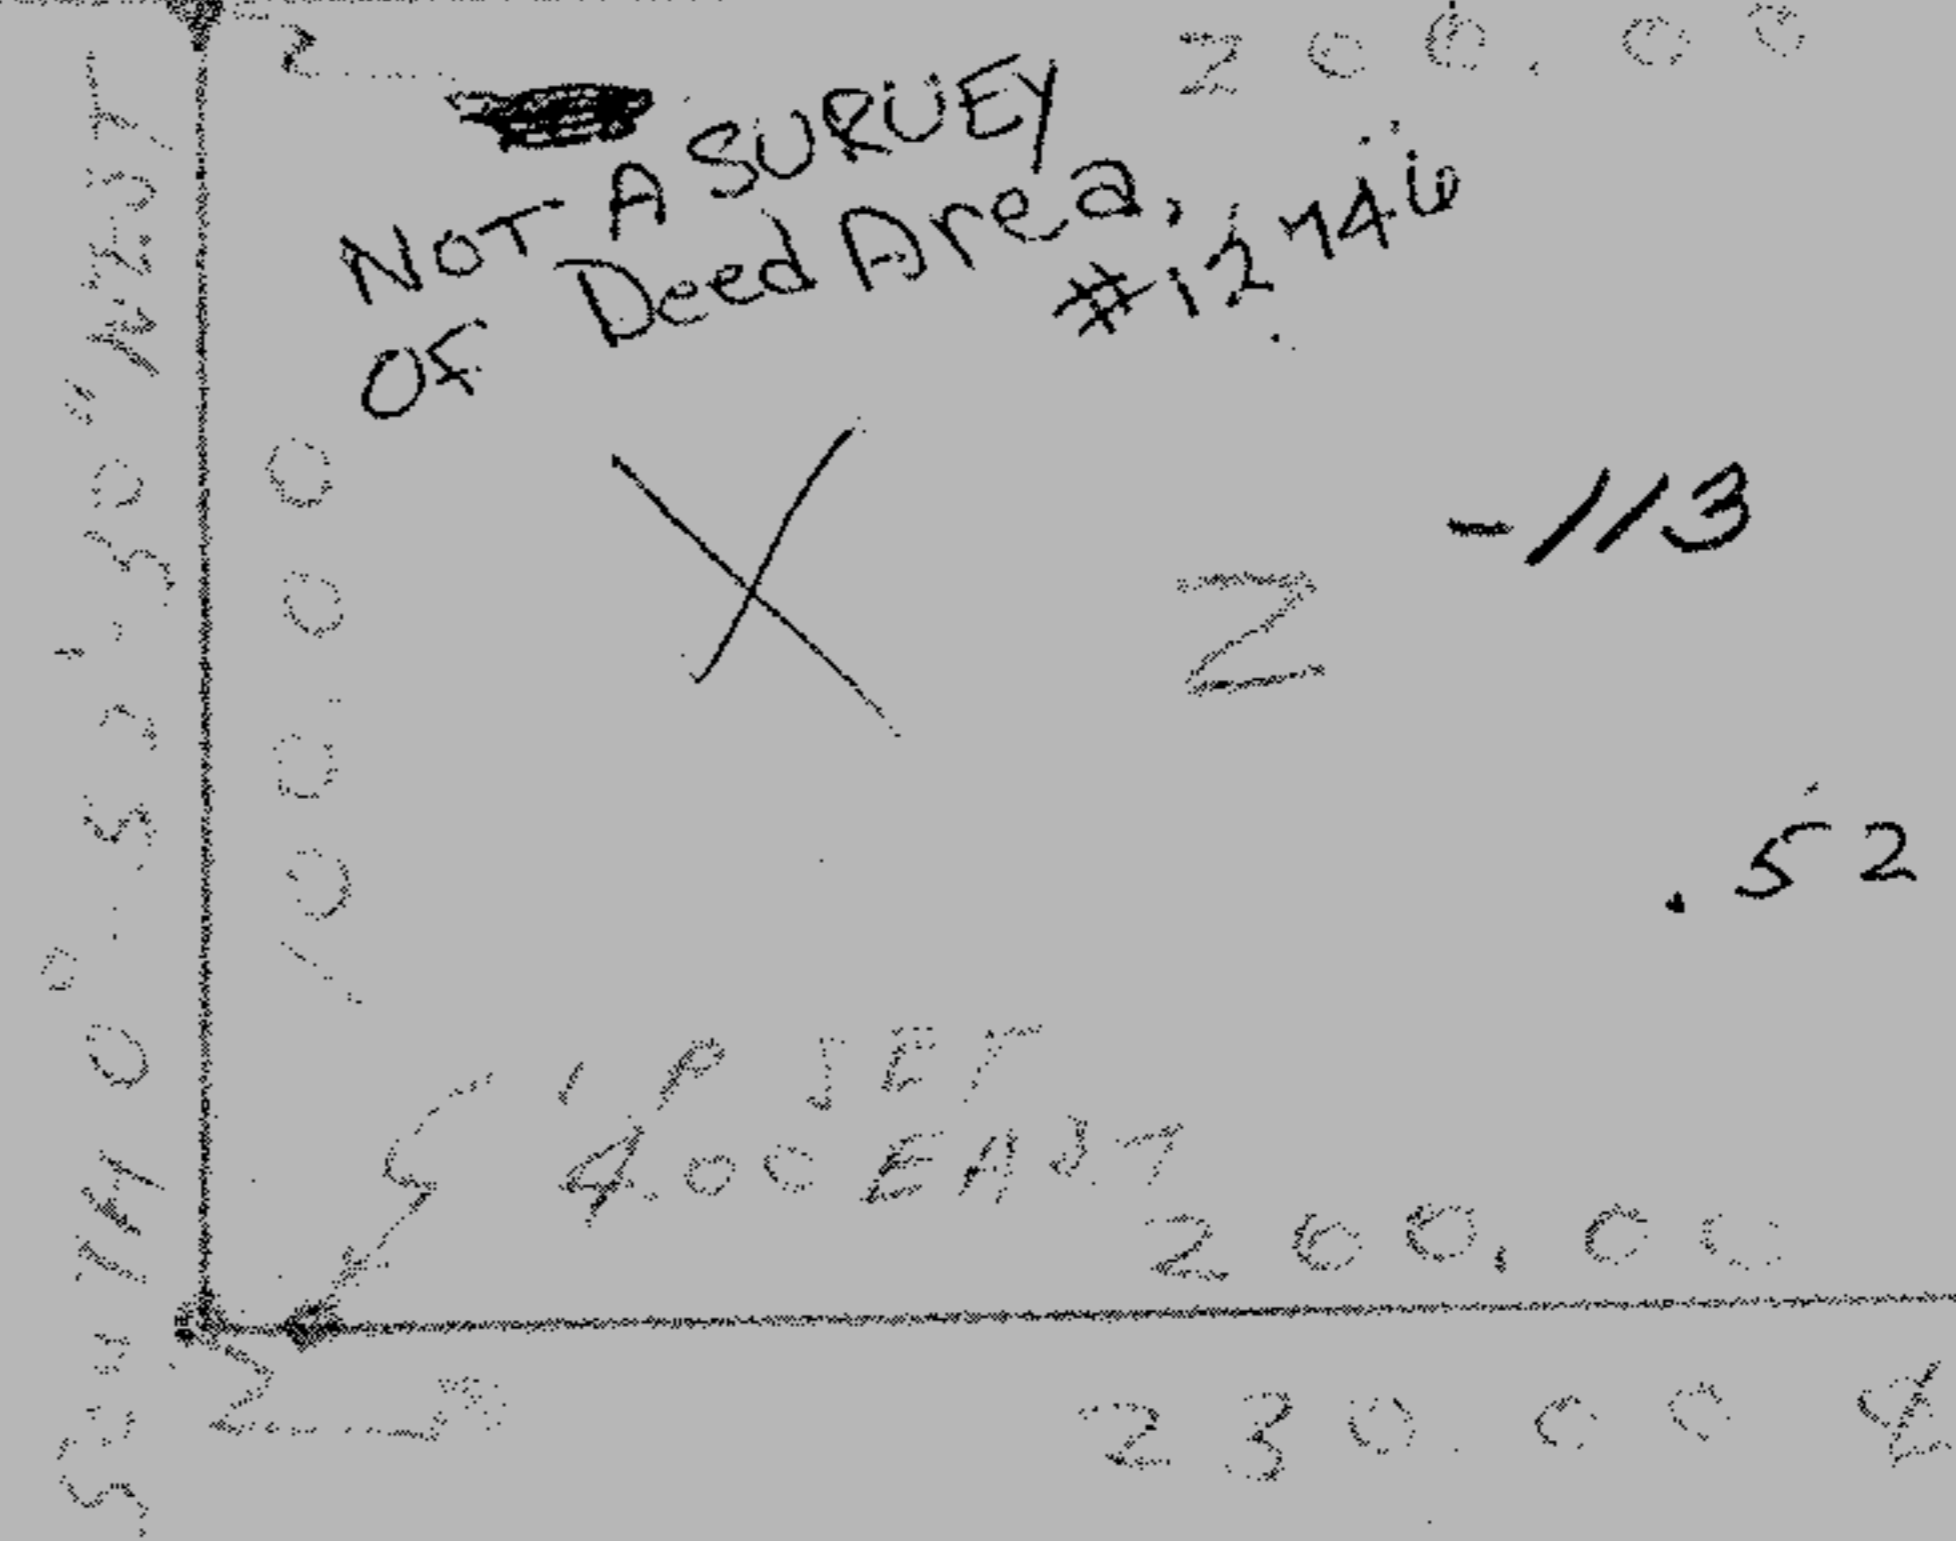

.5280 AC.

HOUSE NO.  
4416

206.25 DEED

206.25 DEED  
SOUTH 0°-32'-30" WEST  
CENTER ROAD

To Change Measurements of  
Frontage from 21360 to 206.25