



SUBLOT \_\_\_\_\_  
SUBDIVISION \_\_\_\_\_  
OTHER PART OF ORIGINAL SECTION 22, AVON TOWNSHIP, CITY OF AVON, COUNTY OF LORAIN, STATE OF OHIO

4-00-022-E #16772 04-00-022-03

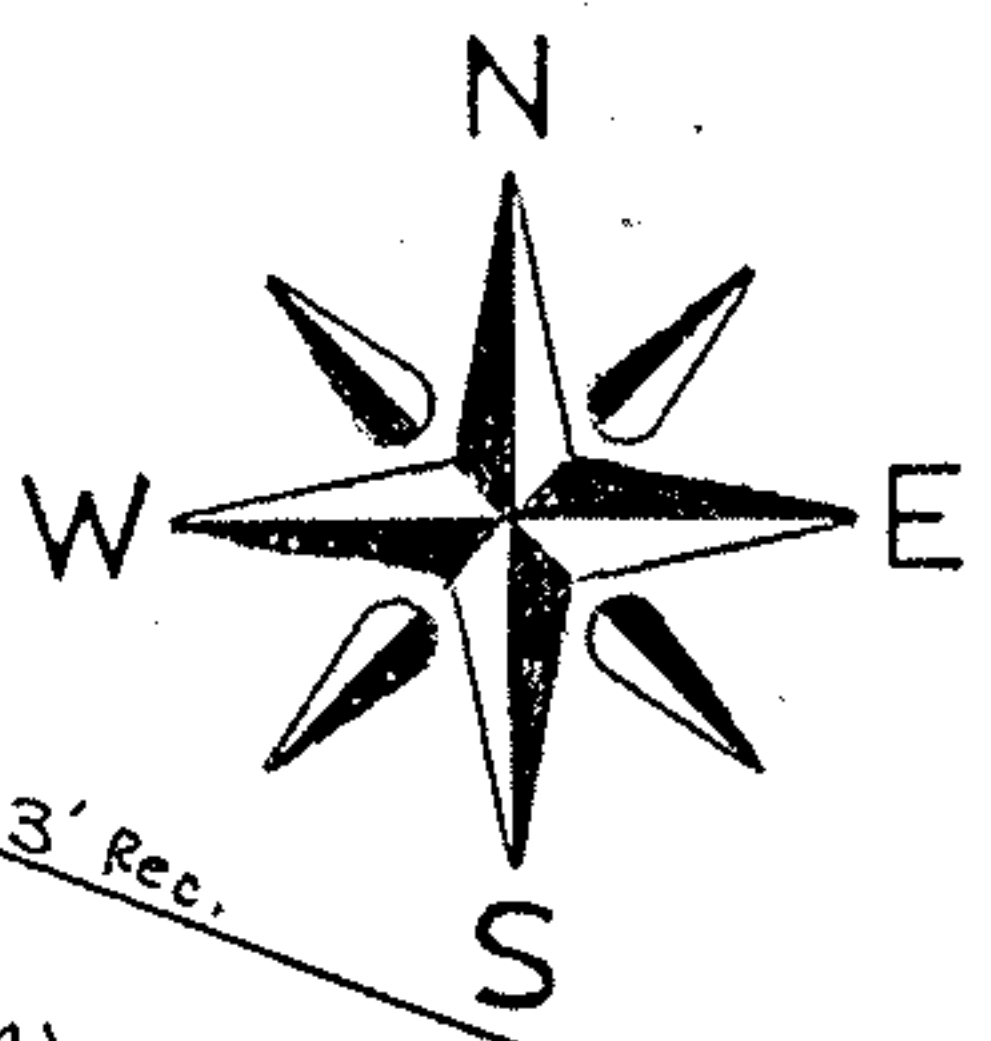

#16772  
APPROVED  
LORAIN CO.  
MAP DEPT.  
DATE 6-6-86  
PAGE 4-00-022  
BY T. McMain  
VOID AFTER

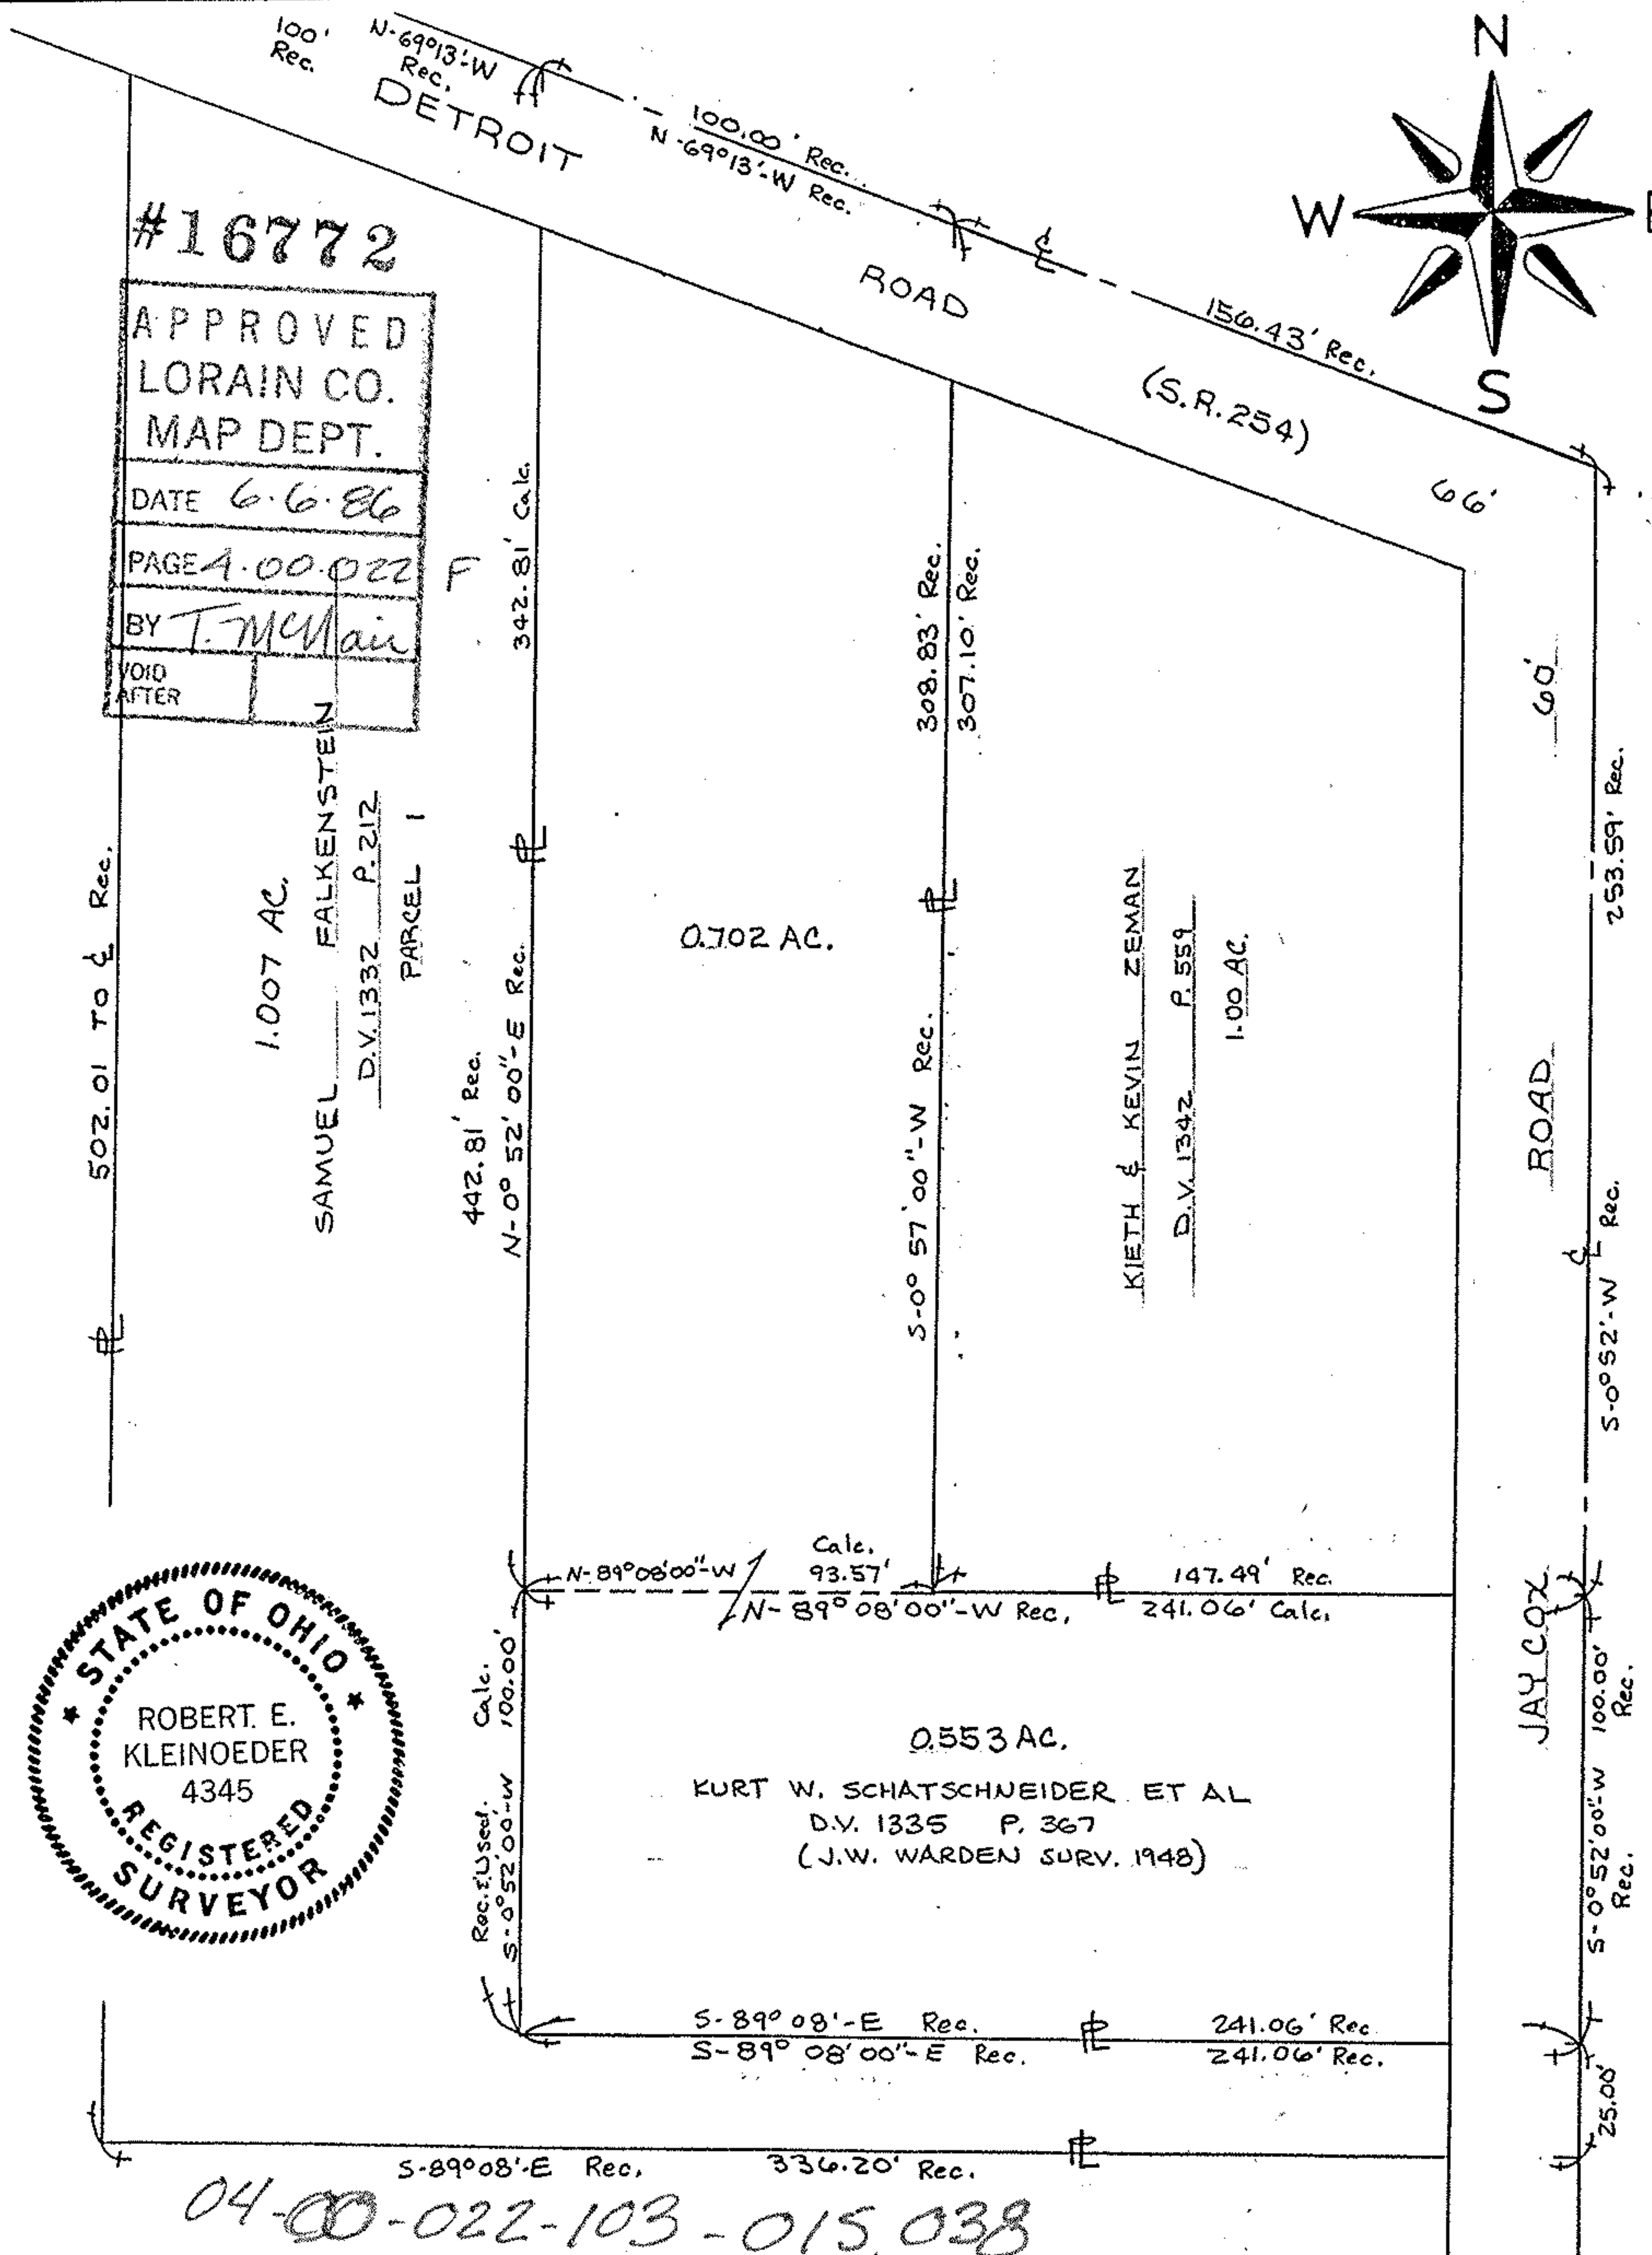

04-00-022-103-015,038

Robert E. Kleinoeder