



500 W. MAIN

05-00-091-102

#16465

05-00-091-102-010,011

5-00-091-B

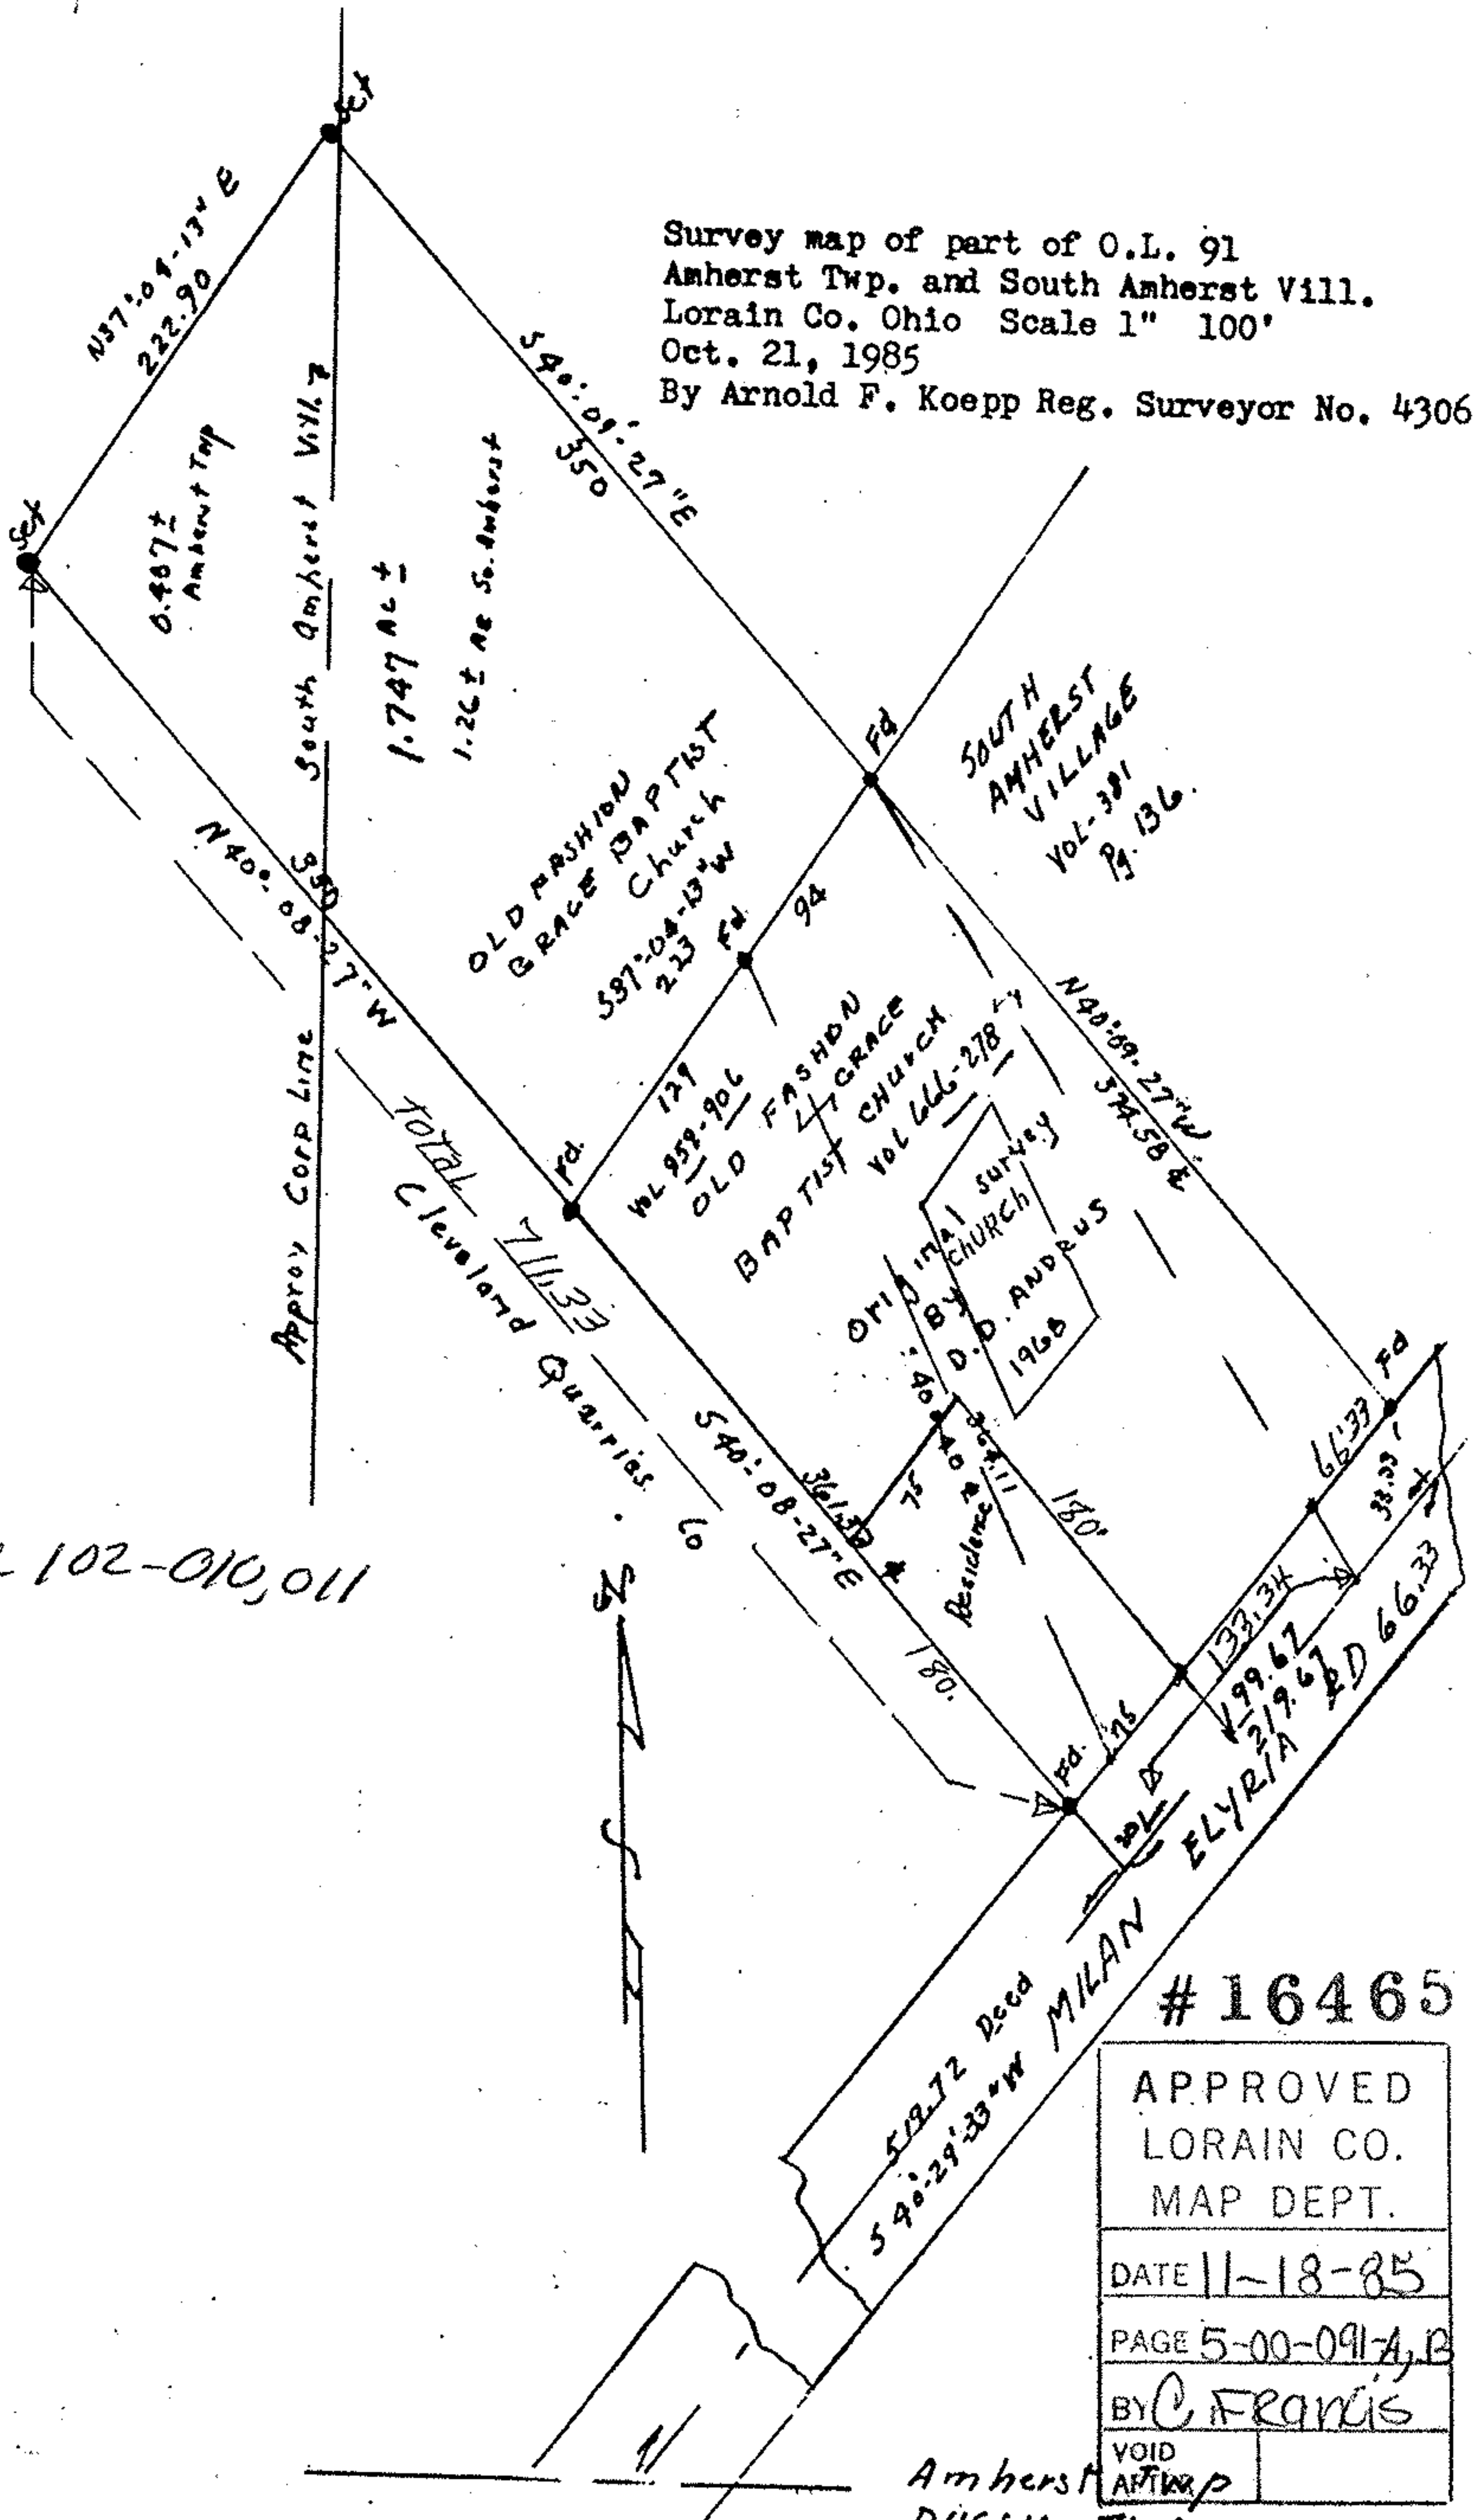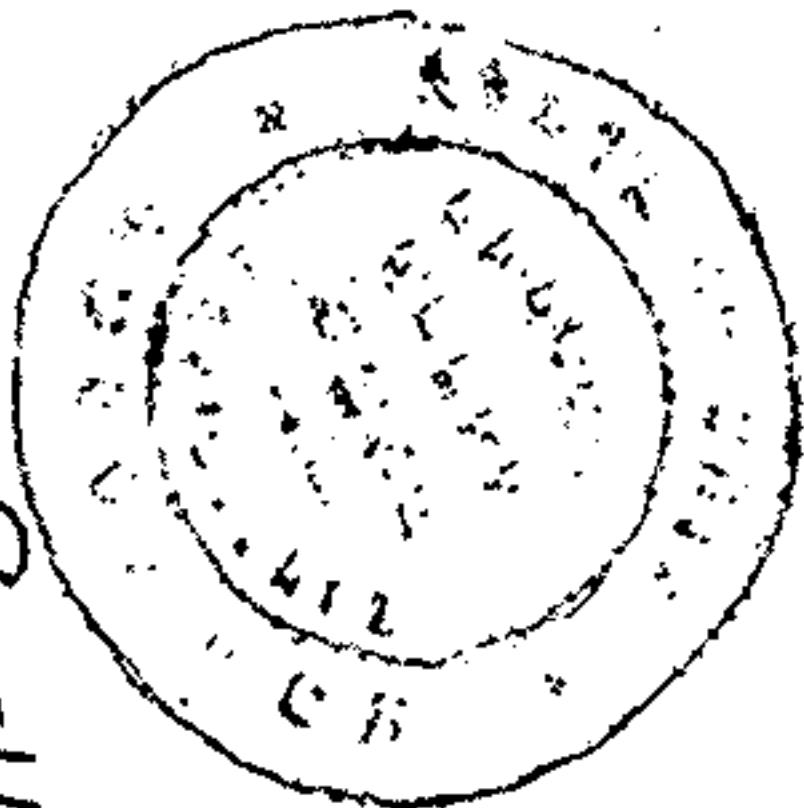

Survey map of part of O.L. 91  
 Amherst Twp. and South Amherst Vill.  
 Lorain Co. Ohio Scale 1" 100'  
 Oct. 21, 1985  
 By Arnold F. Koepf Reg. Surveyor No. 4306

APPROVED LORAIN CO. MAP DEPT.	
DATE 11-18-85	
PAGE 5-00-091-A, B	
BY C. FRANCIS	
VOID	AMFKP

#16465

Amherst