



500 W. MAIN

05-00-091-102

#16465

05-00-091-102-010,011

5-00-091-B

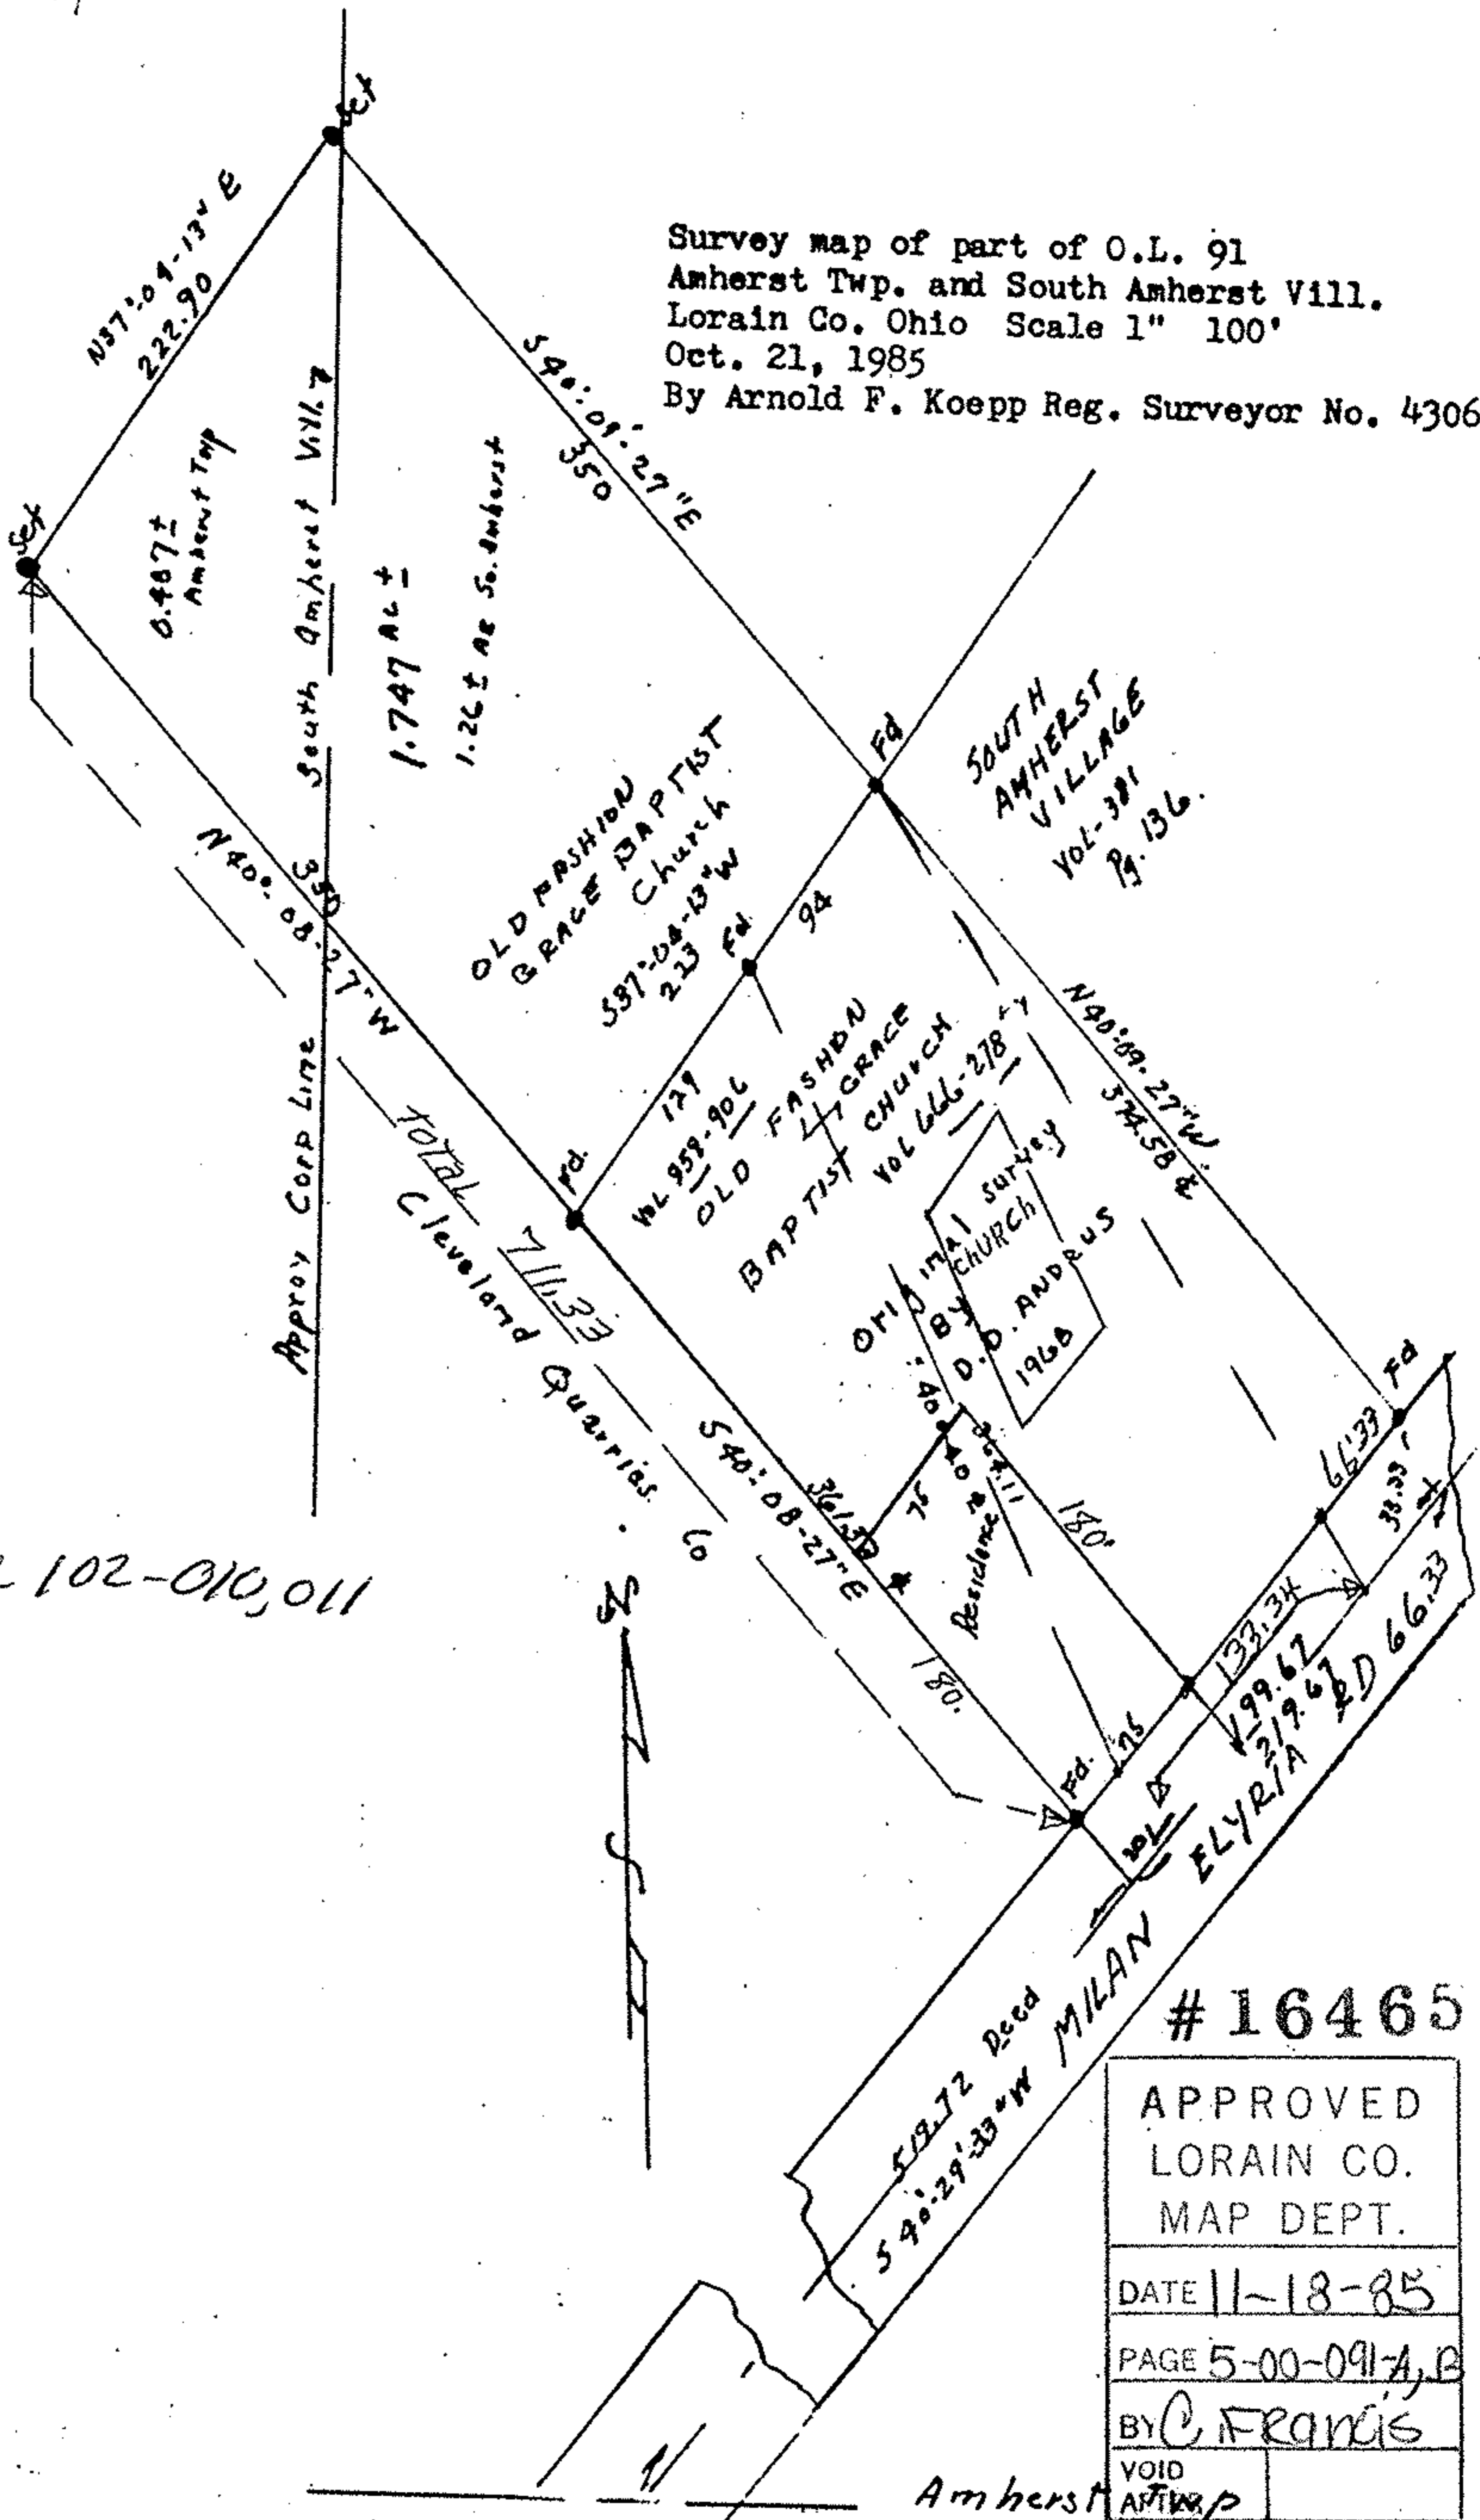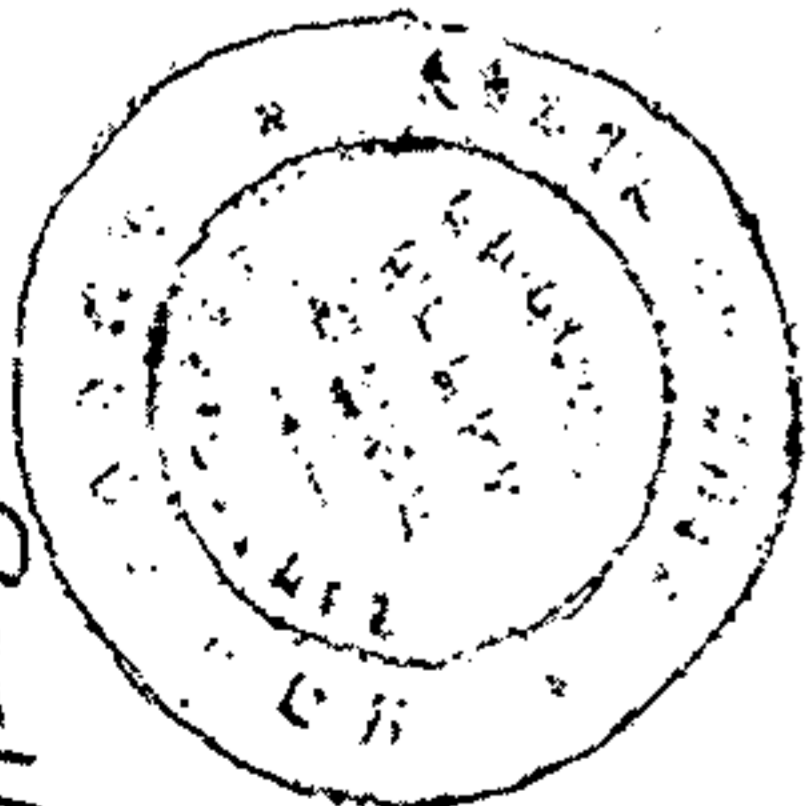

Survey map of part of O.L. 91
 Amherst Twp. and South Amherst Vill.
 Lorain Co. Ohio Scale 1" 100'
 Oct. 21, 1985
 By Arnold F. Koepp Reg. Surveyor No. 4306

16465

APPROVED LORAIN CO. MAP DEPT.
DATE 11-18-85
PAGE 5-00-091-A, B
BY C. FRANCIS
VOID AFTER

Amherst
Disc...