



LAUNDON . SIMON . CAHL & ASSOC. INC.  
 CONSULTING ENGINEERS & SURVEYORS  
 219 COURT ST. ELYRIA, OHIO 44035


SURVEY FOR:  
**PIZZA HUT**  
 % YOST CONST. CO.

Orig. Lot 1	City of	Date SEPT. 191 Scale 1" = 100'
Orig. Sec	Village of SHEFFIELD	Dwn. by R.G.S. Chkd. by R.C.
Tract	County of LORAIN	Job No. 91-3000 F.B. 221/67
Township of SHEFFIELD	State of OHIO	Printed

03-00-001-000

19769

3-00-001-A

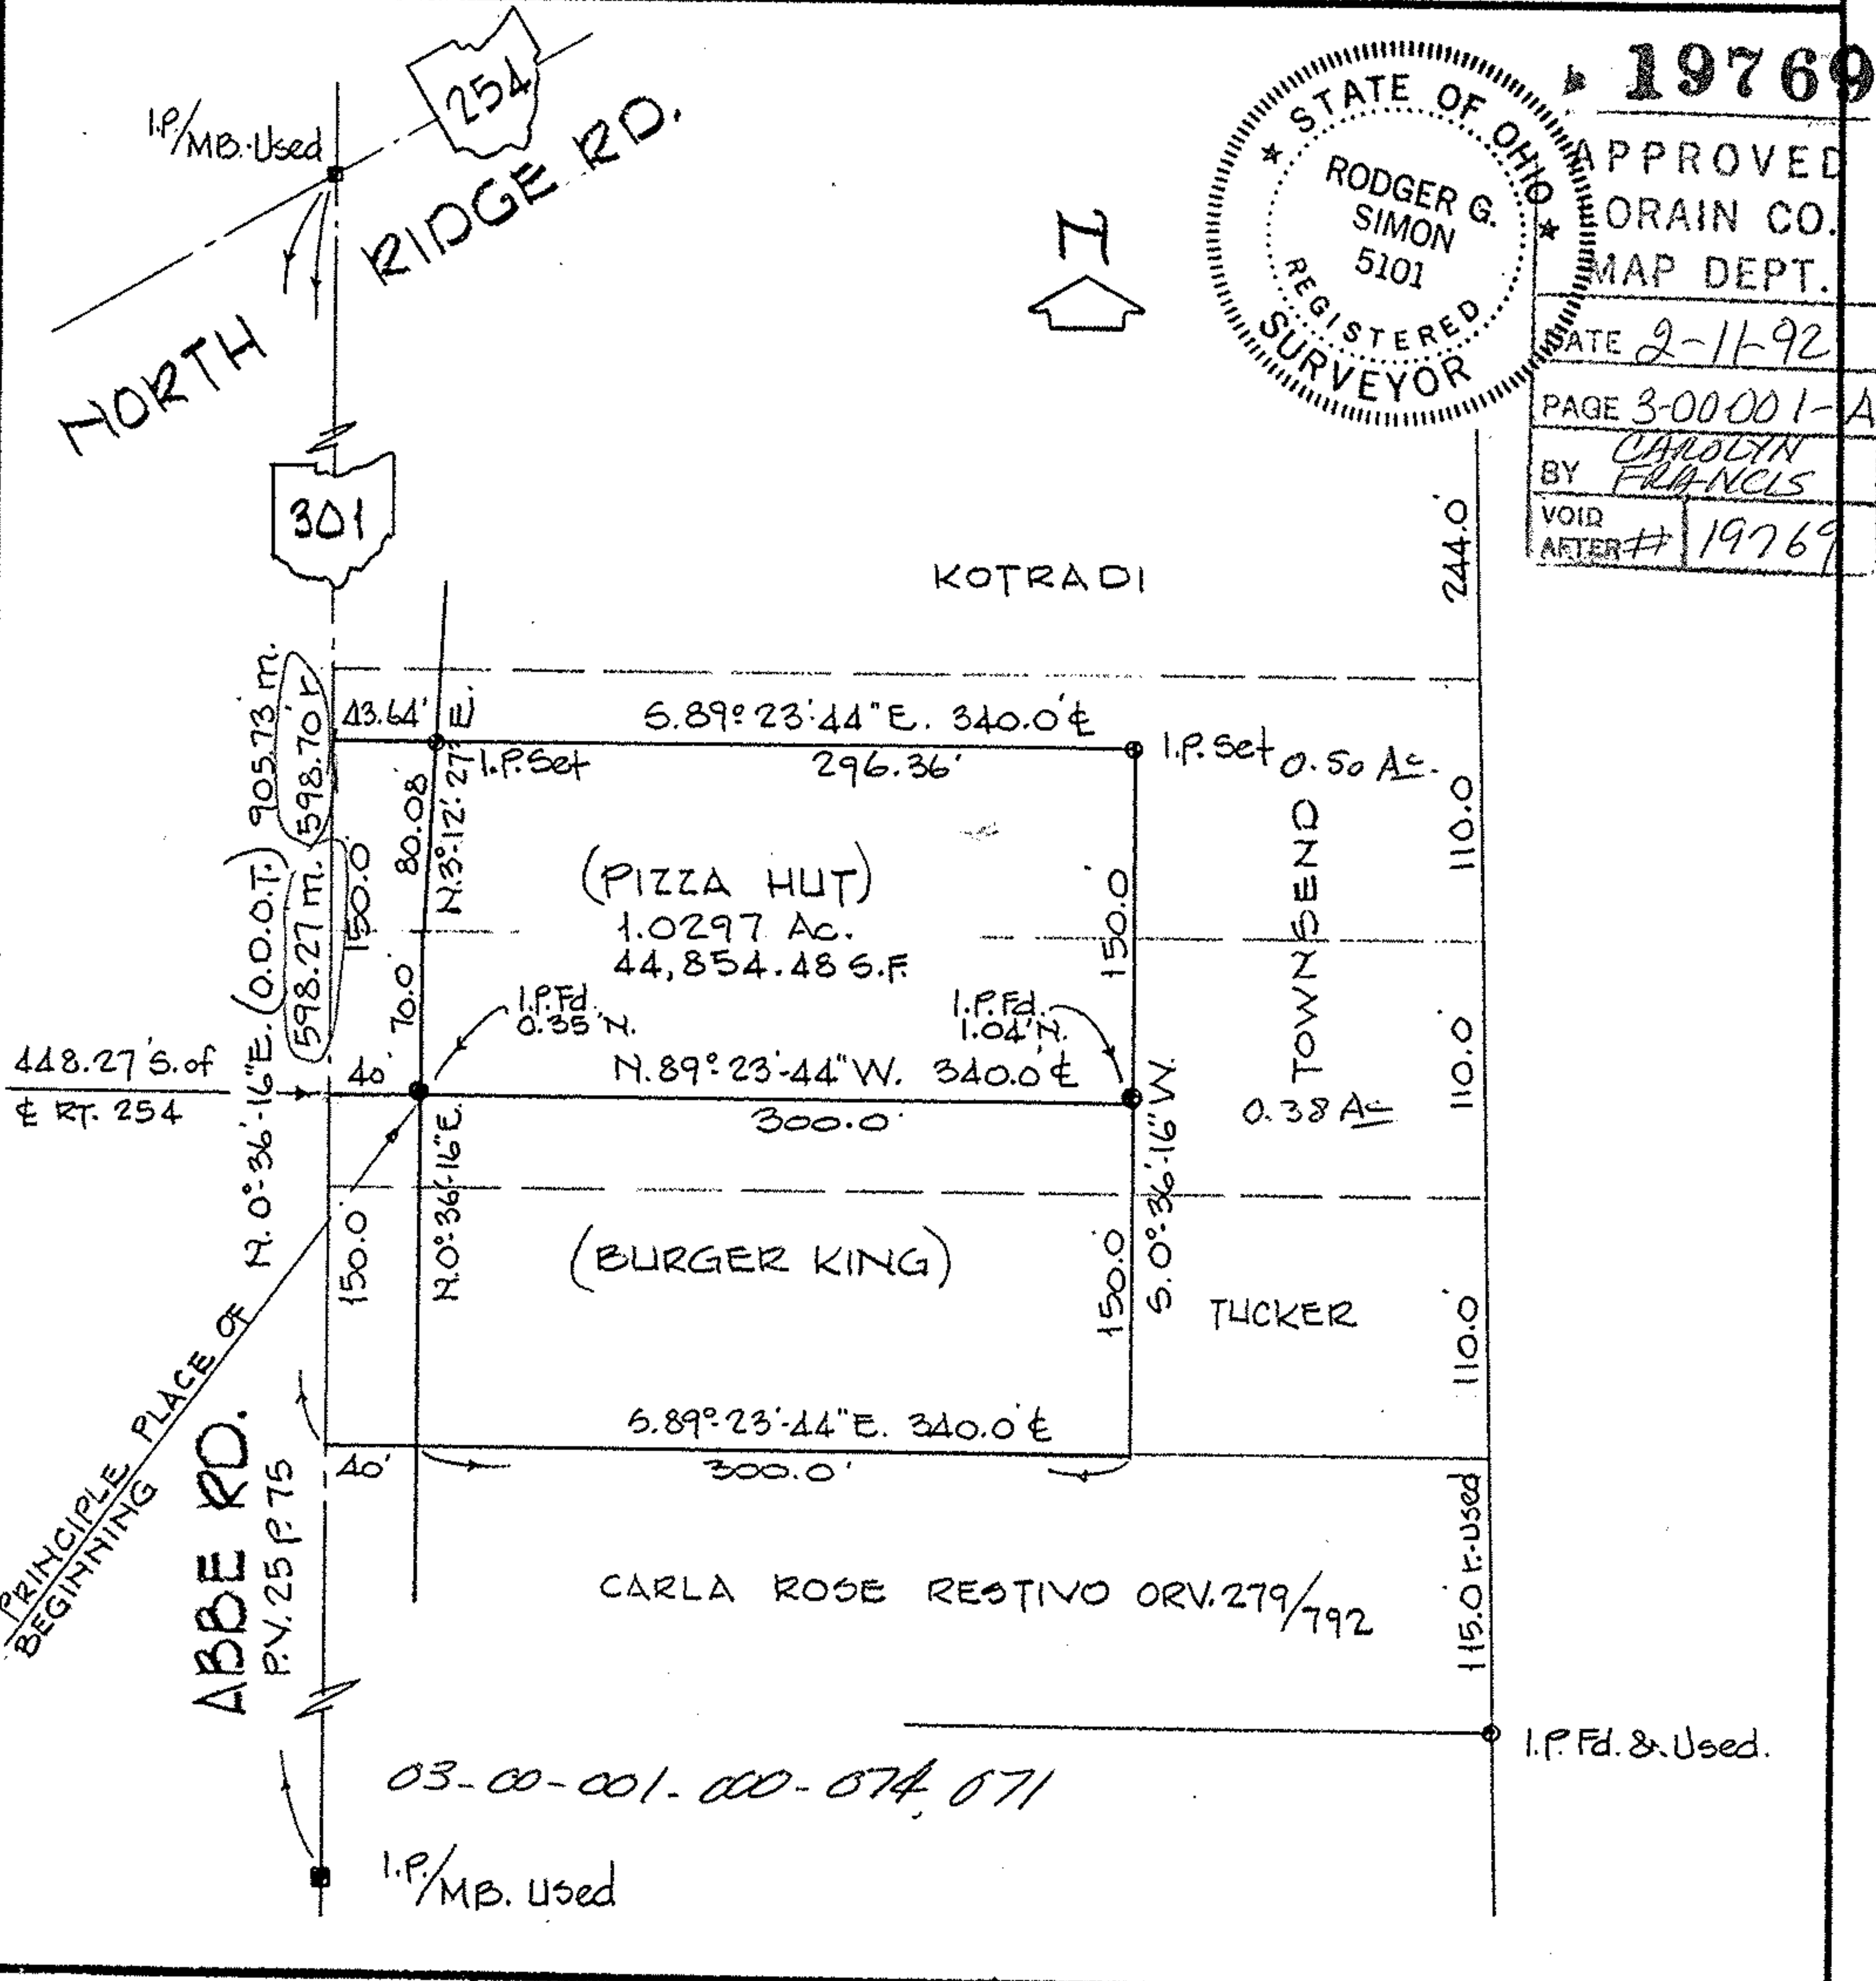

03-00-001-000-074, 071

1. P. / MB. Used

1. P. Fd. & Used.