



PARENT PARCEL: 04-00-003-101-080, 04-00-002-101-002, -012, 03-00-004-000-047
 PARENT PARCEL: 03-00-014-000-037
 CHILD PARCEL: SAME
 STARTING POINT: MULTIPLE

NO. 00858-A

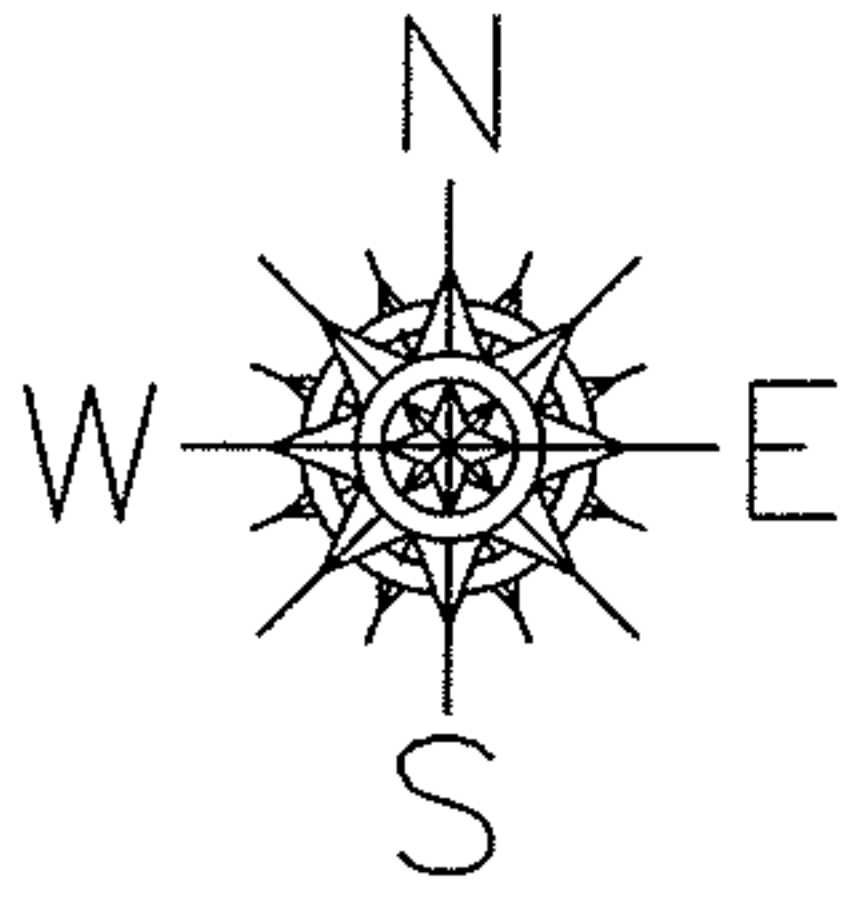

AC. CORRS.
 PER SURVEY
 JAMES A. RESAR

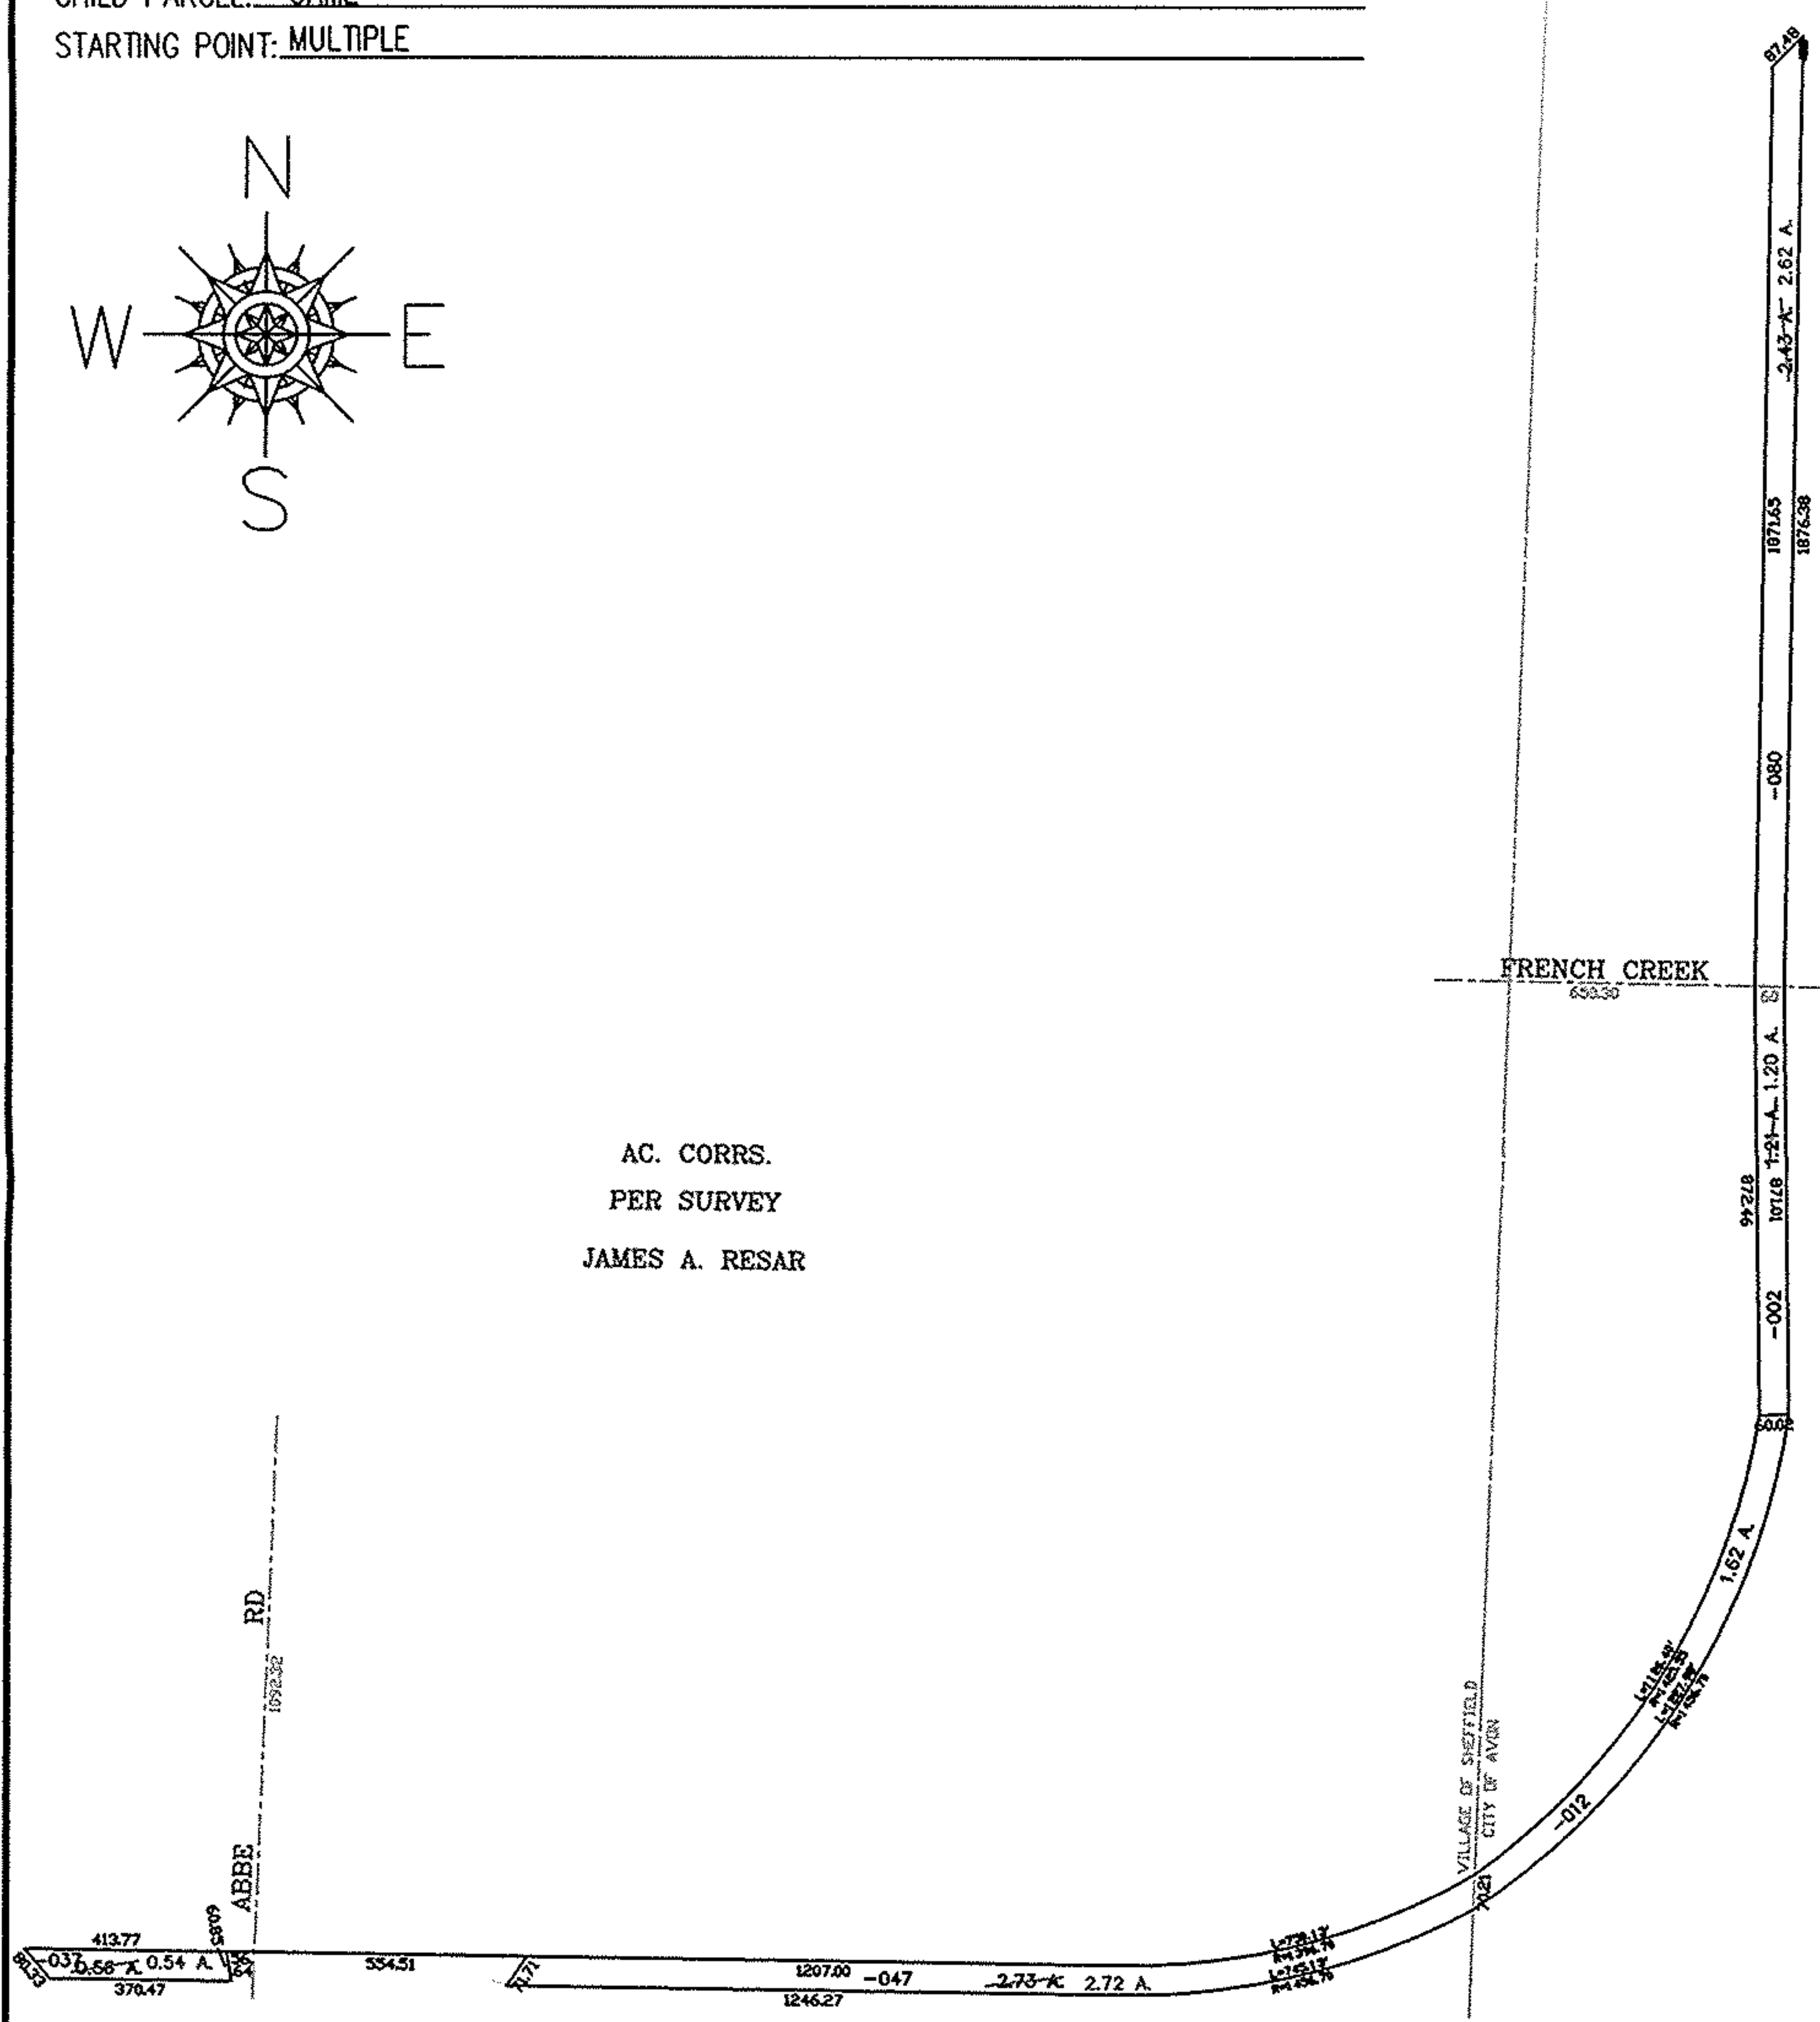

SPLITS/DEEDS PROCESSED

LORAIN COUNTY TAX MAP DEPARTMENT
 226 MIDDLE AVE. ELYRIA, OHIO

SURVEYED BY: JAMES A. RESAR
 CLOSURE: 0:00 MAP PAGE(S): 3-L
 04-00-003-E, -002-A, 03-00-004-A, -014-B
 APPROVED BY: DRH DATE: 5/19/03
 SCALE: 1" = 500 PRIOR INSTRUMENT: