


03-00-113-103-048,049

#22751


APPROVED	
LORAIN CO.	
MAP DEPT.	
DATE 1-29-99	
PAGE 3-00-113-A	
BY T. Silk	
VOID AFTER	22751

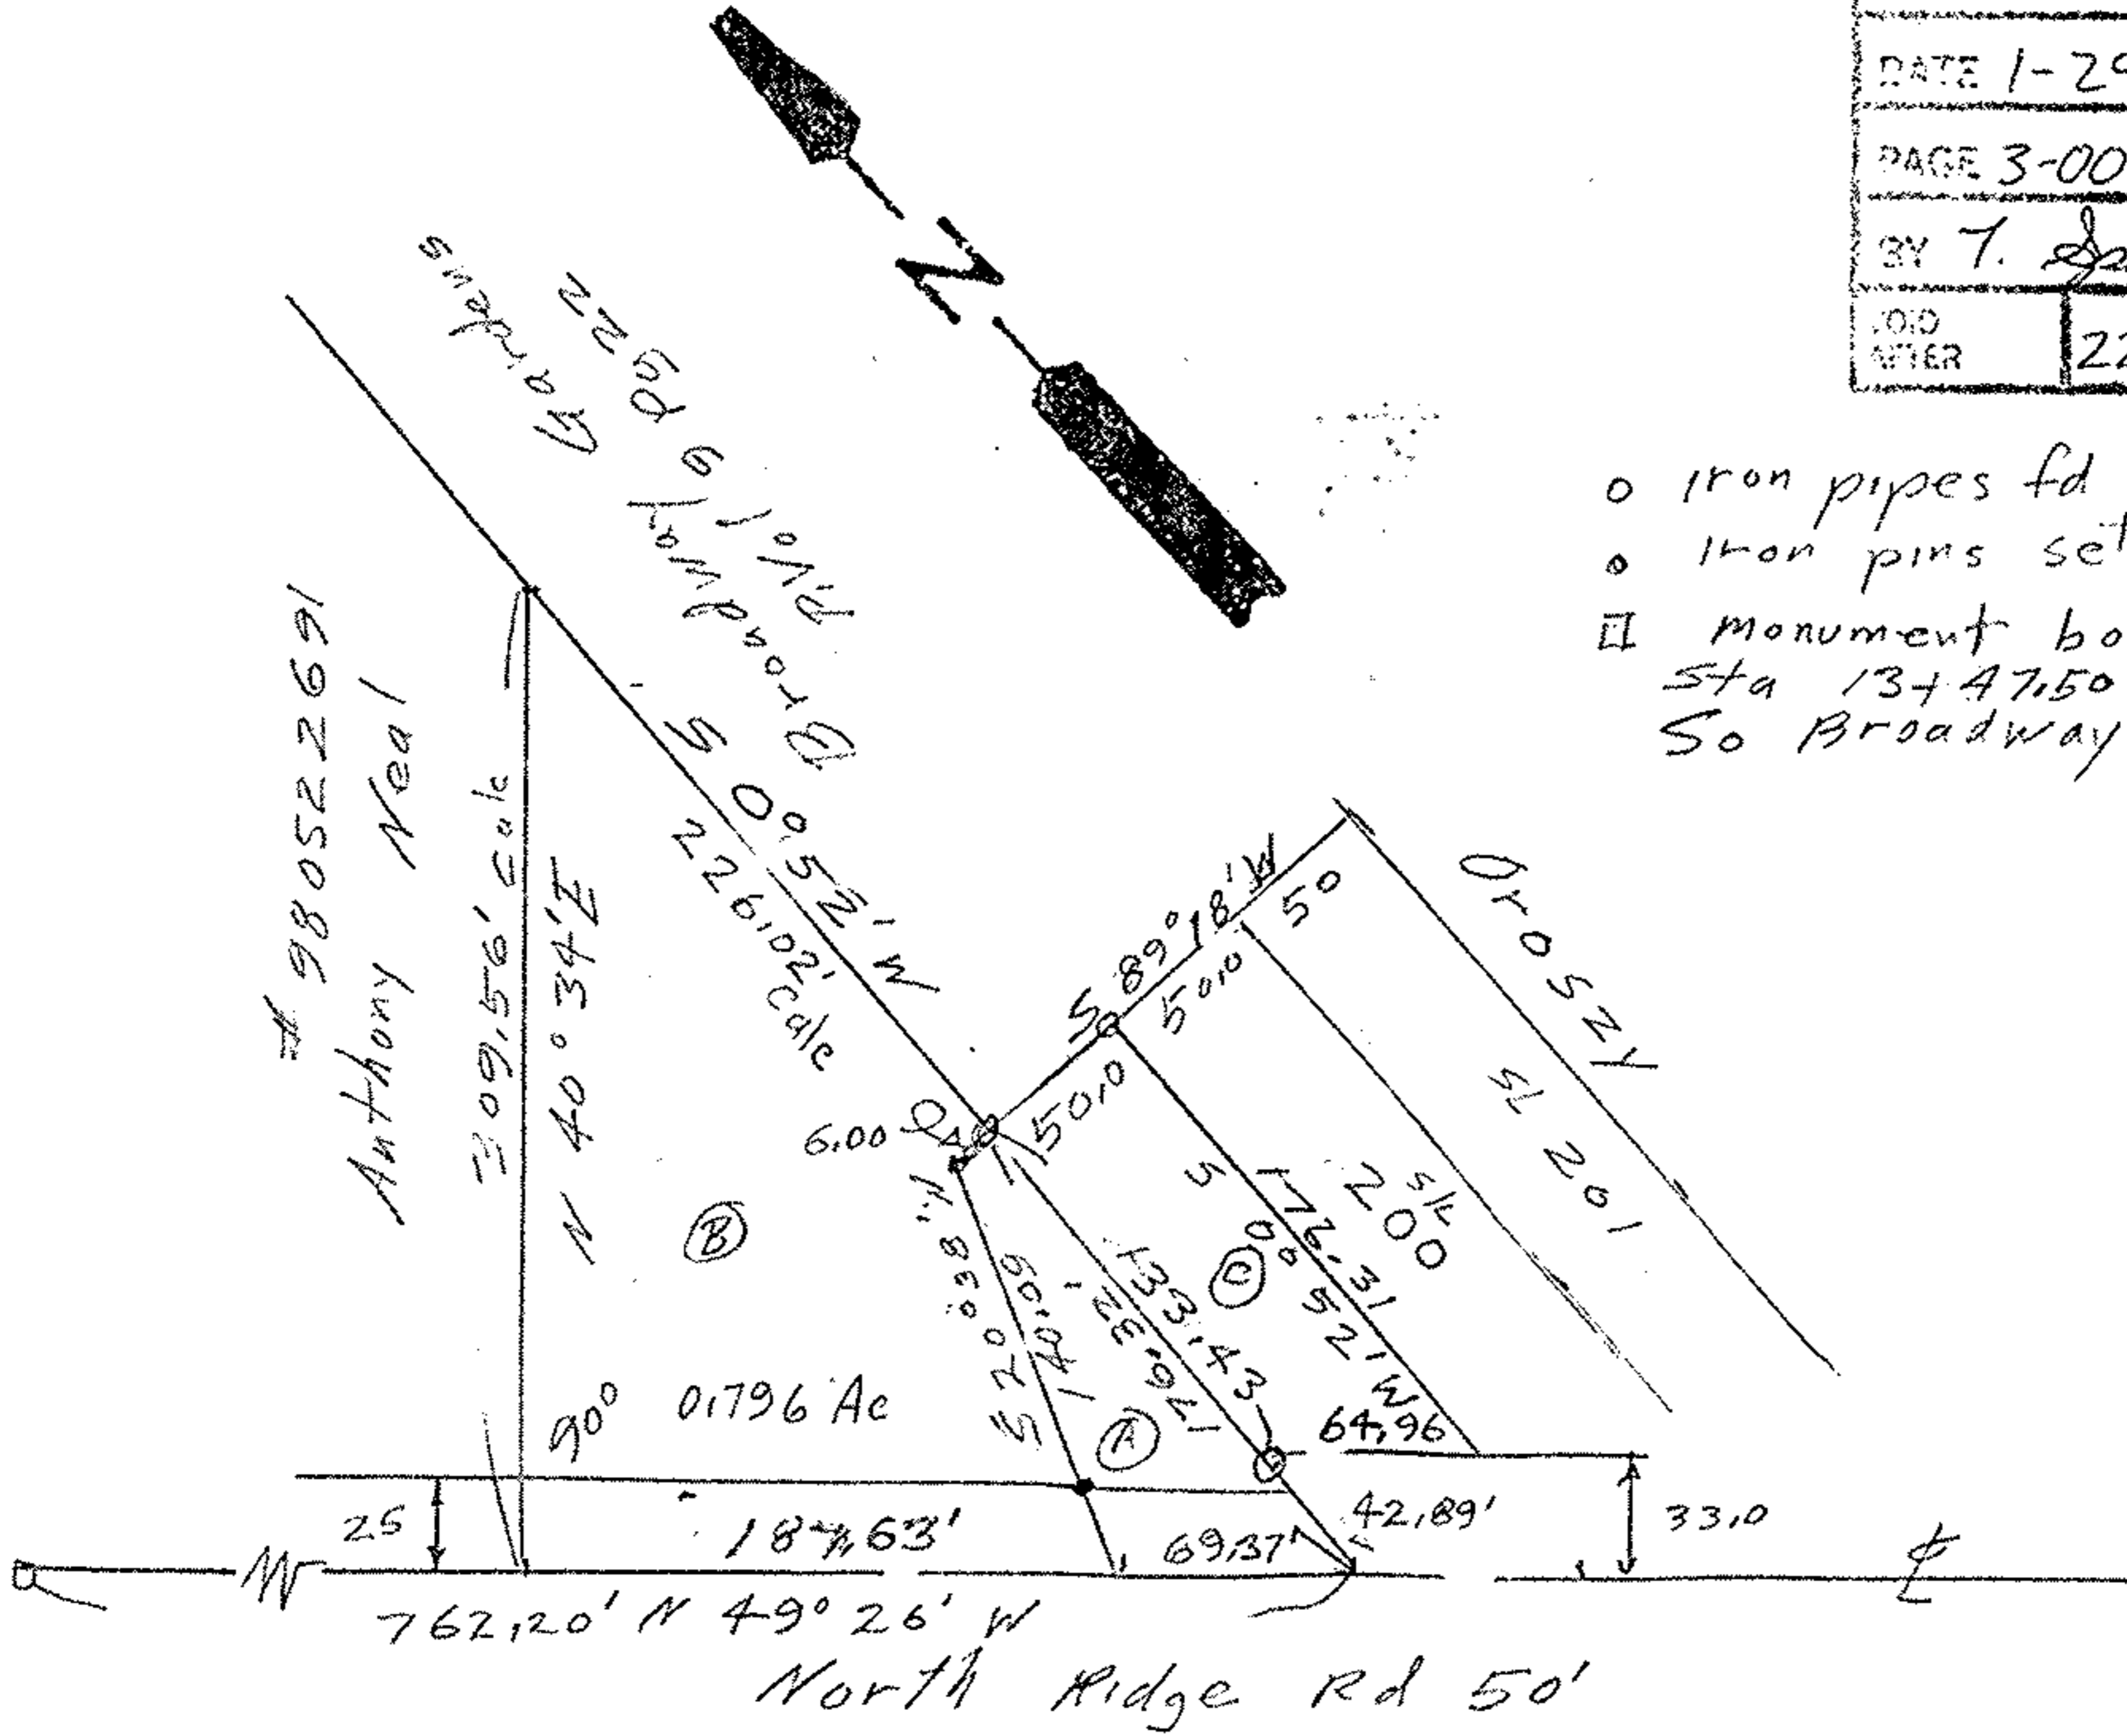

- o iron pipes fd
- o iron pins set
- monument box
Sta 13+47.50
So Broadway R/W
Plans

- (A) 0.117 Acre
- (B) Annette Cline & Edwards
Celestino Br 1260 Pg 709

- (C) Robert E Toothman
1172 Pg 833
199

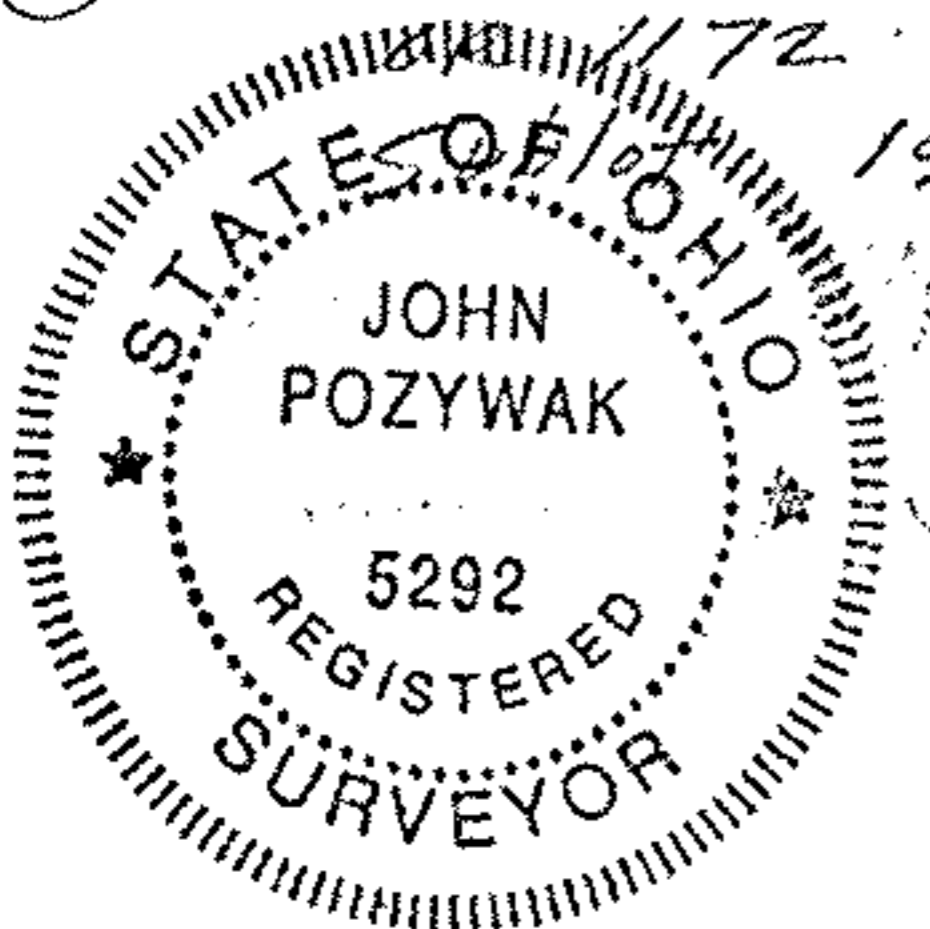

Survey of Parcel Split
Original Lot 113
Sheffield Township
Lorain County Ohio
Scale 1"=100' Oct 1998

John Pozywak

03-00-113-103-048,049

03-00-113