


CERTIFICATE OF CORRECTION

"EXHIBIT A"

No 00698-X
 APPROVED
 LORAIN CO.
 MAP DEPT.
 DATE 5.9.02
 PAGE 1.00-015 A
 BY R. MAINES
 VOID
 AFTER 02-00698-X

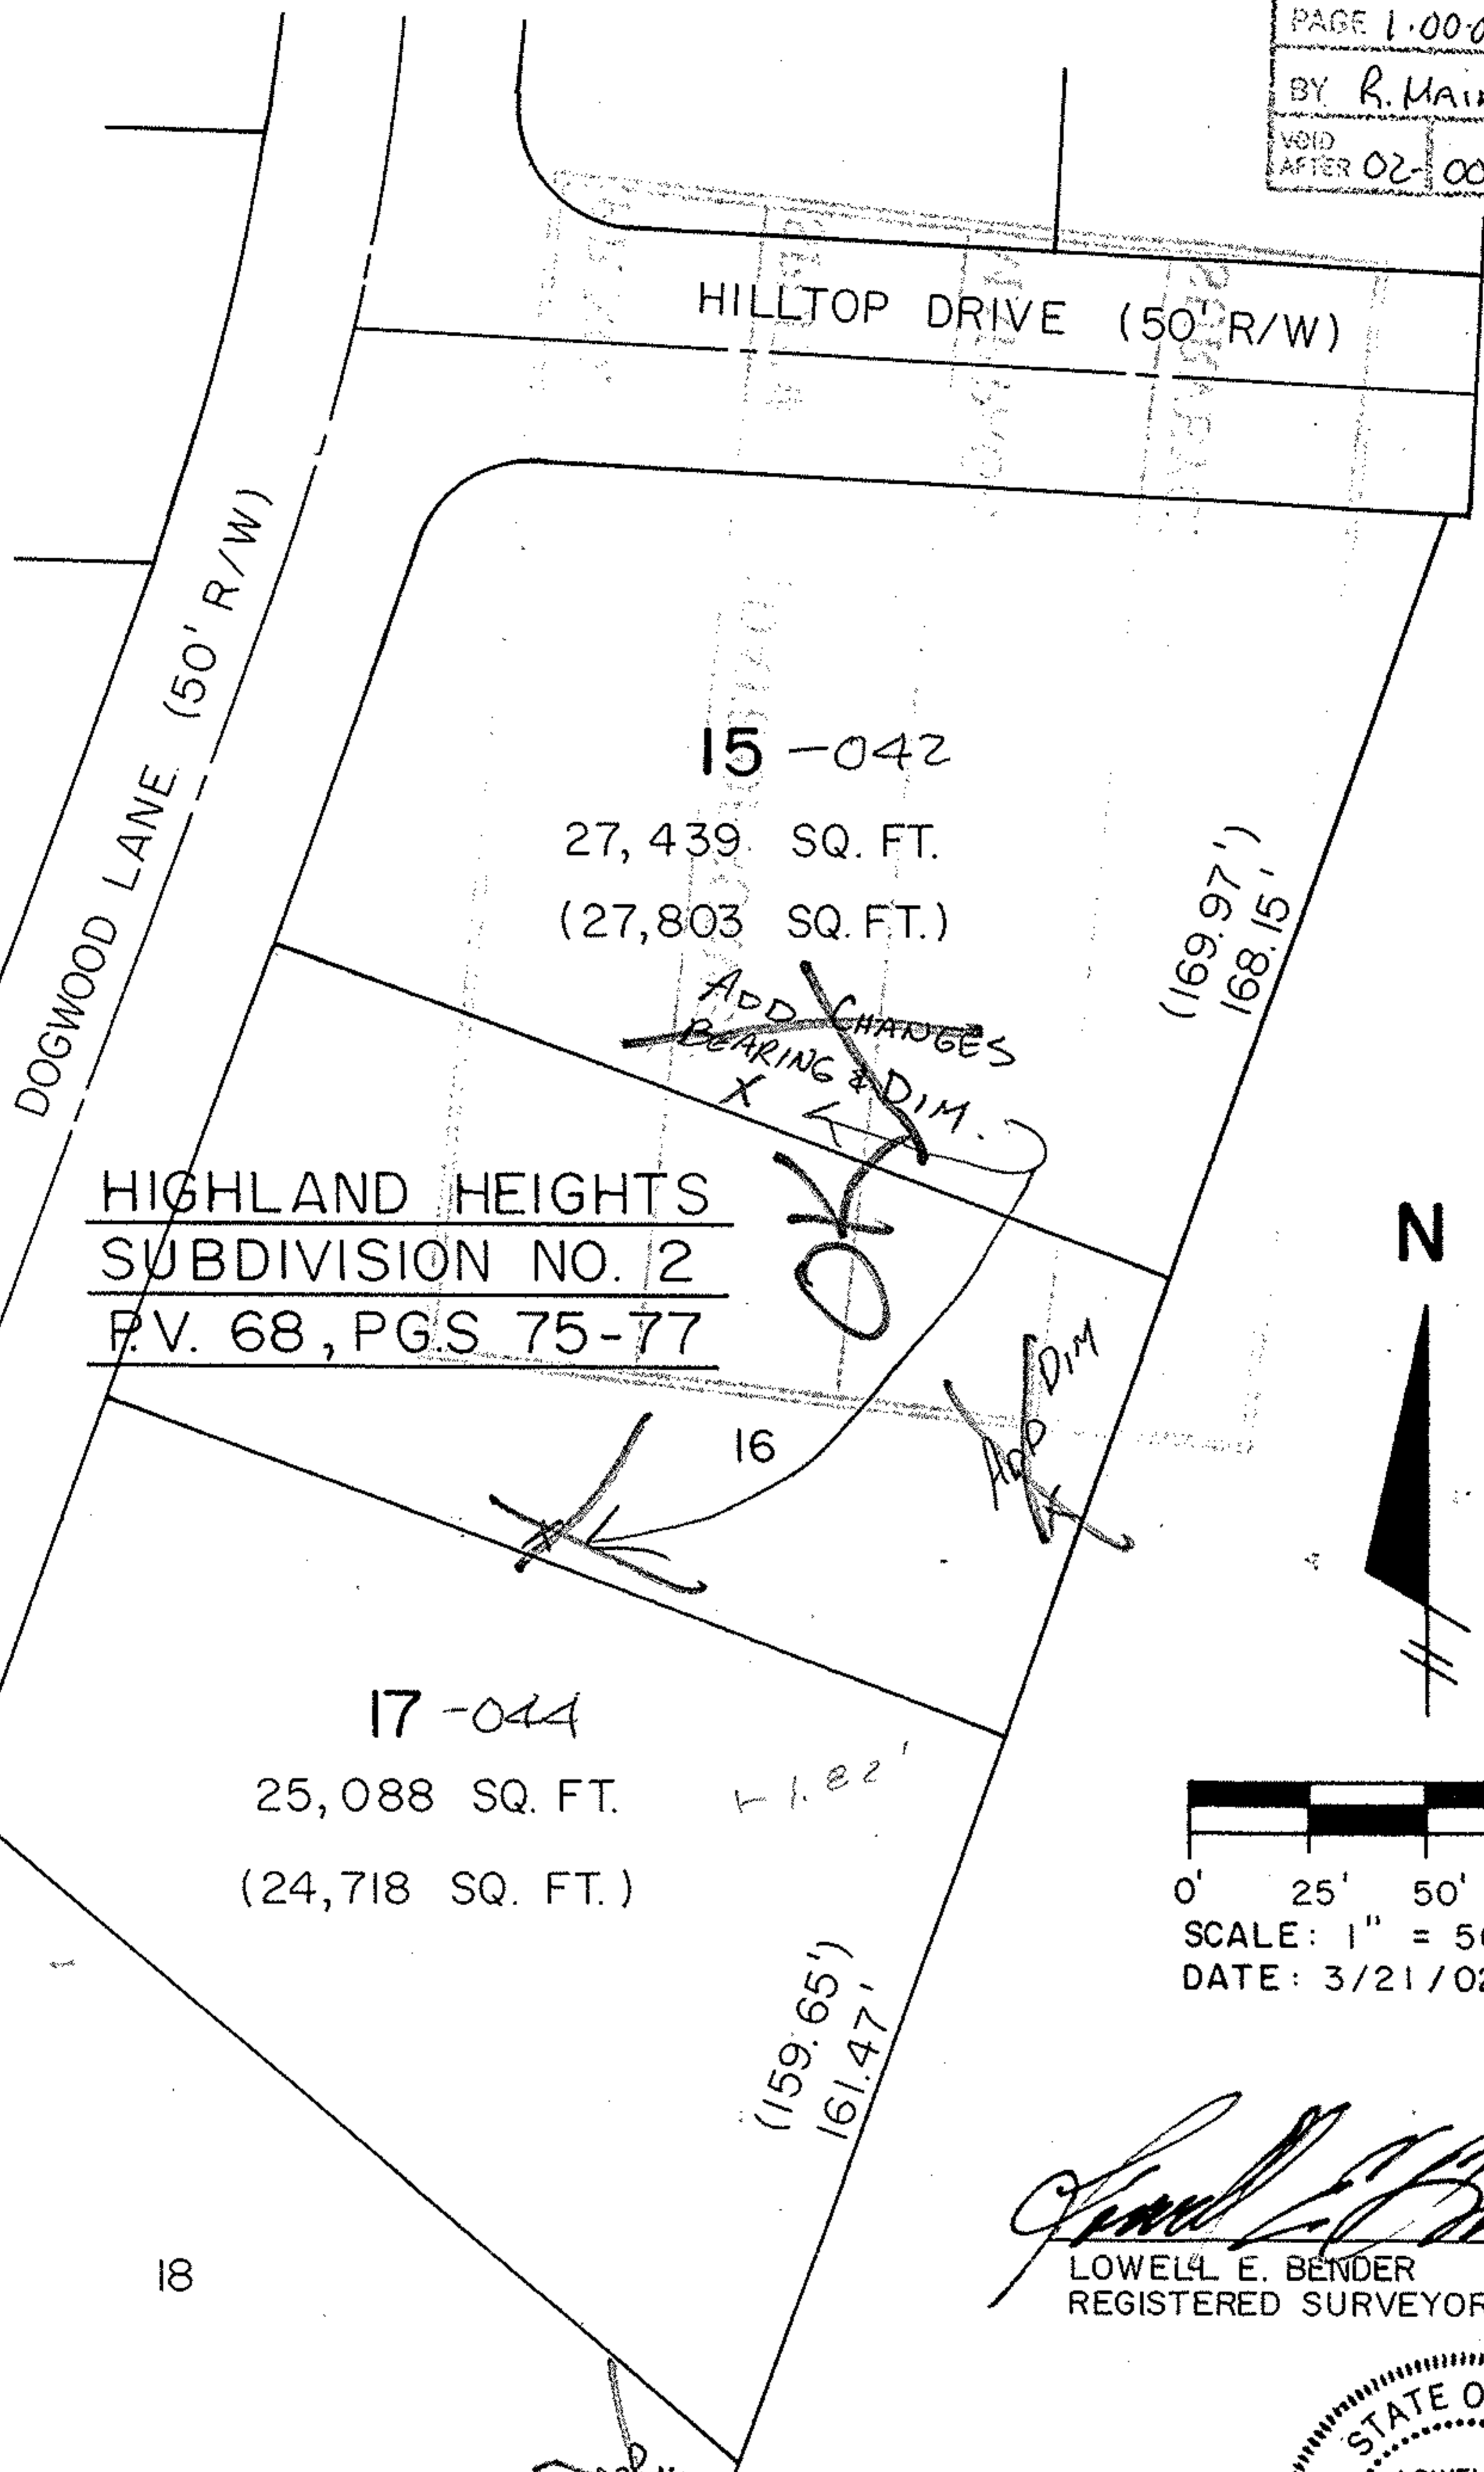

HIGHLAND HEIGHTS
 SUBDIVISION NO. 2
 P.V. 68, PGS 75-77


15 - 042
 27,439 SQ. FT.
 (27,803 SQ. FT.)

17 - 044
 25,088 SQ. FT.
 (24,718 SQ. FT.)


~~ADD CHANGES
 BEARING & DIM.~~

~~ADD DIM~~

~~ADD DIM~~

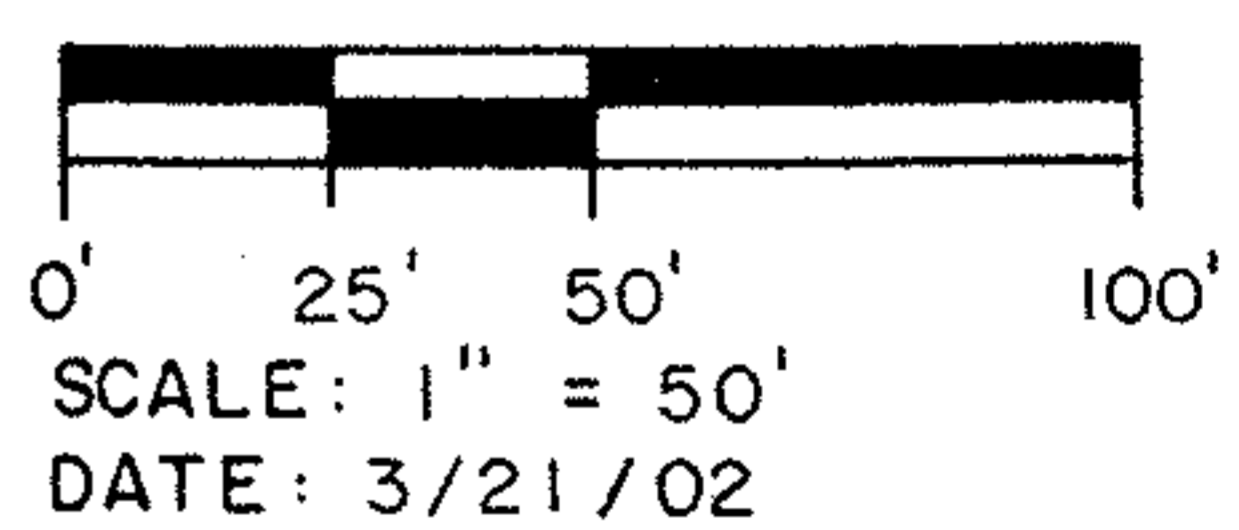

Lowell E. Bender
 LOWELL E. BENDER
 REGISTERED SURVEYOR NO. 4978

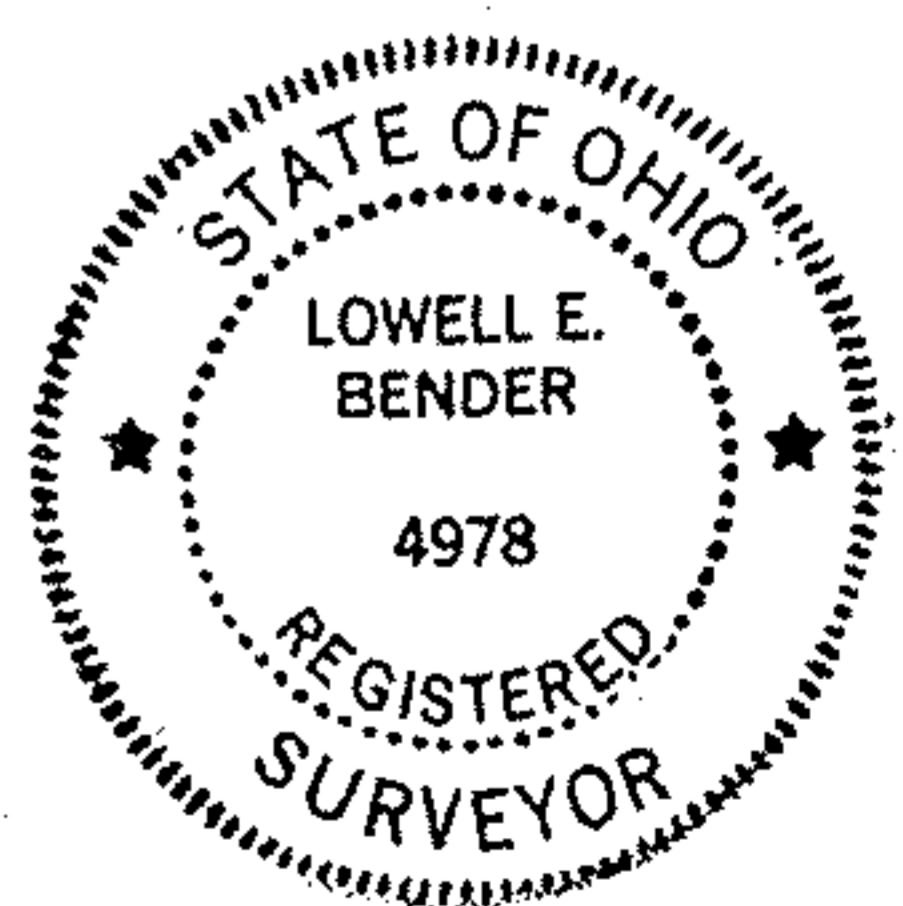

01-00-015-000-042,044

NOTES:

1. BEARINGS AND DISTANCES NOT SHOWN REMAIN THE SAME.
2. DISTANCES AND SQUARE FEET SHOWN () PER RECORDED PLAT AND ARE REVISED AS SHOWN.