

21684

APPROVED  
LORAIN CO.  
MAP DEPT

DATE 2-27-96

PAGE 2-01-003K

BY CAROLYN  
FRANCIS

#21684


38TH STREET GO'  
(FORMERLY ANDERSON AVE.)

LEGEND

- IRON PIN FOUND
- 5/8" CAPPED REBAR SET

NORTH

SCALE: 1"=30'

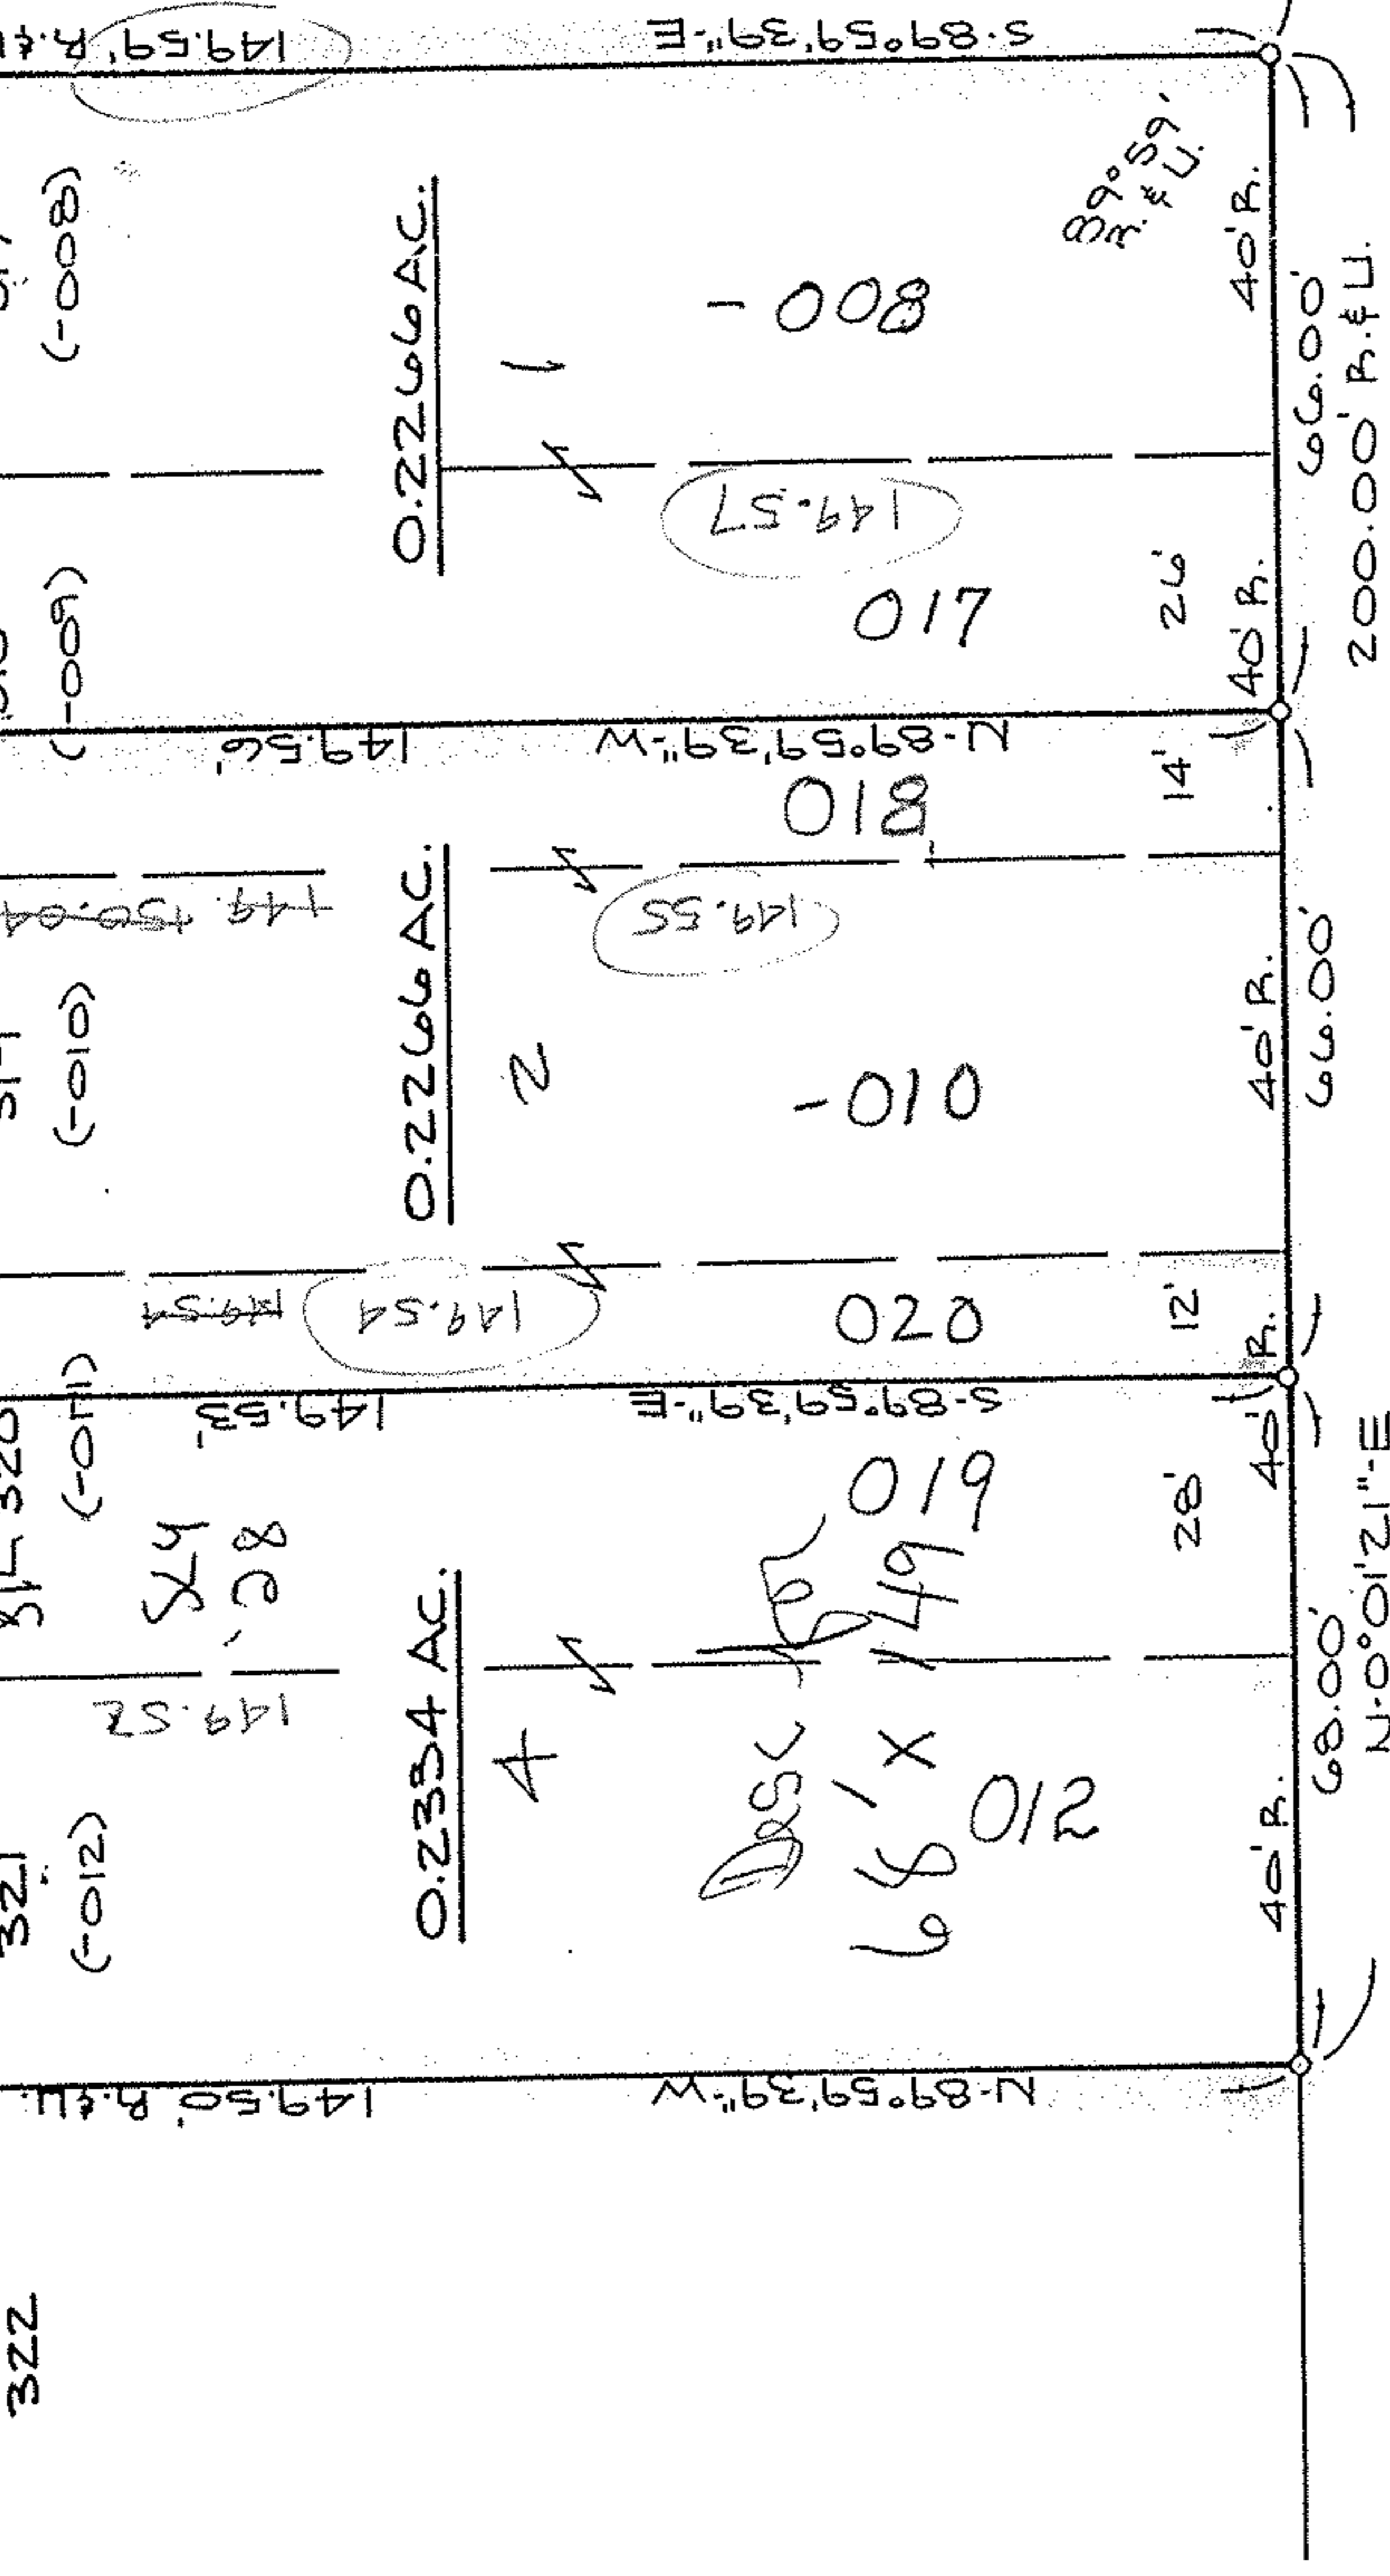

DAYTON AVENUE 60'

(FORMERLY MOORE STREET)

APPROVED

TO DESCRIPTION ONLY

date February 15, 1996

Per Kimberly Hoskins  
City of Lorain  
Engineering Dept.

APPROVED BY THE LORAIN CITY PLANNING

COMMISSION..... NO PLAT REQUIRED

William C. Sobel 2-14-96

SECRETARY LORAIN CITY PLANNING COMMISSION

29.96'

3/4" I.P.F.D.

SURVEY MAP

LORAIN STONE COMPANY'S SECOND


SUBDIVISION

P.V. 6 P. 38

CITY OF LORAIN

STATE OF OHIO

SEPT. 25, 1995

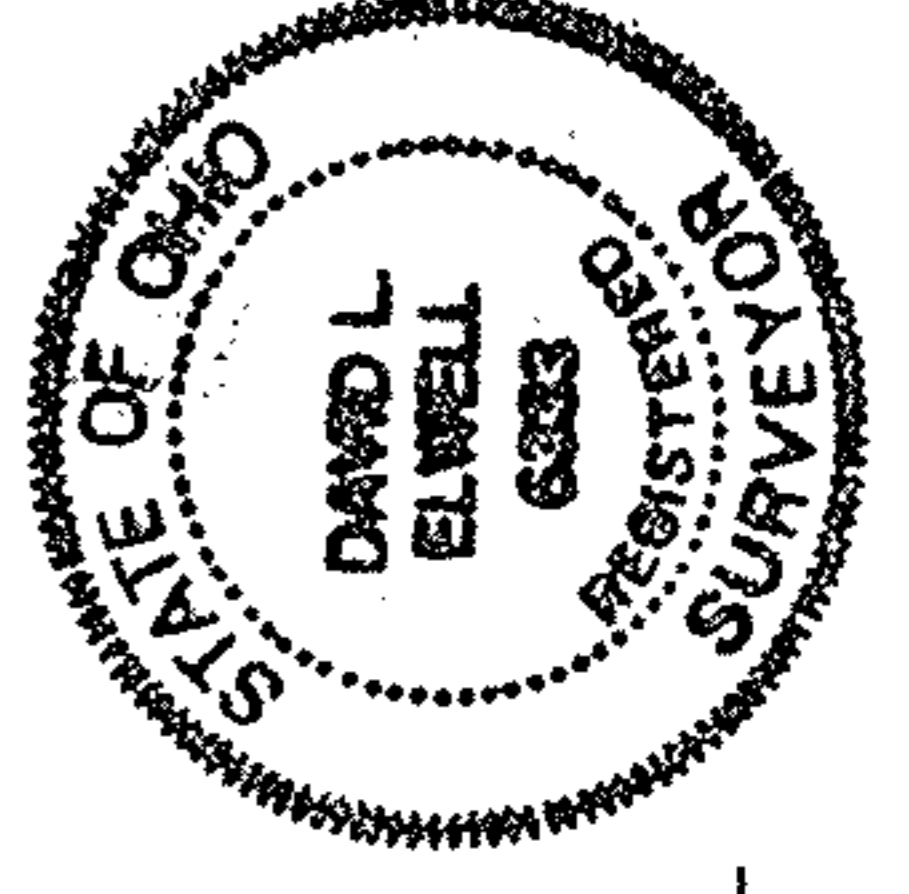

David L. Elwell  
REG. SURVEYOR No. 6333

PREPARED BY: **KS ASSOCIATES INC.**  
ENGINEERS SURVEYORS

95356