


# WEST 21<sup>ST</sup> STREET 66'

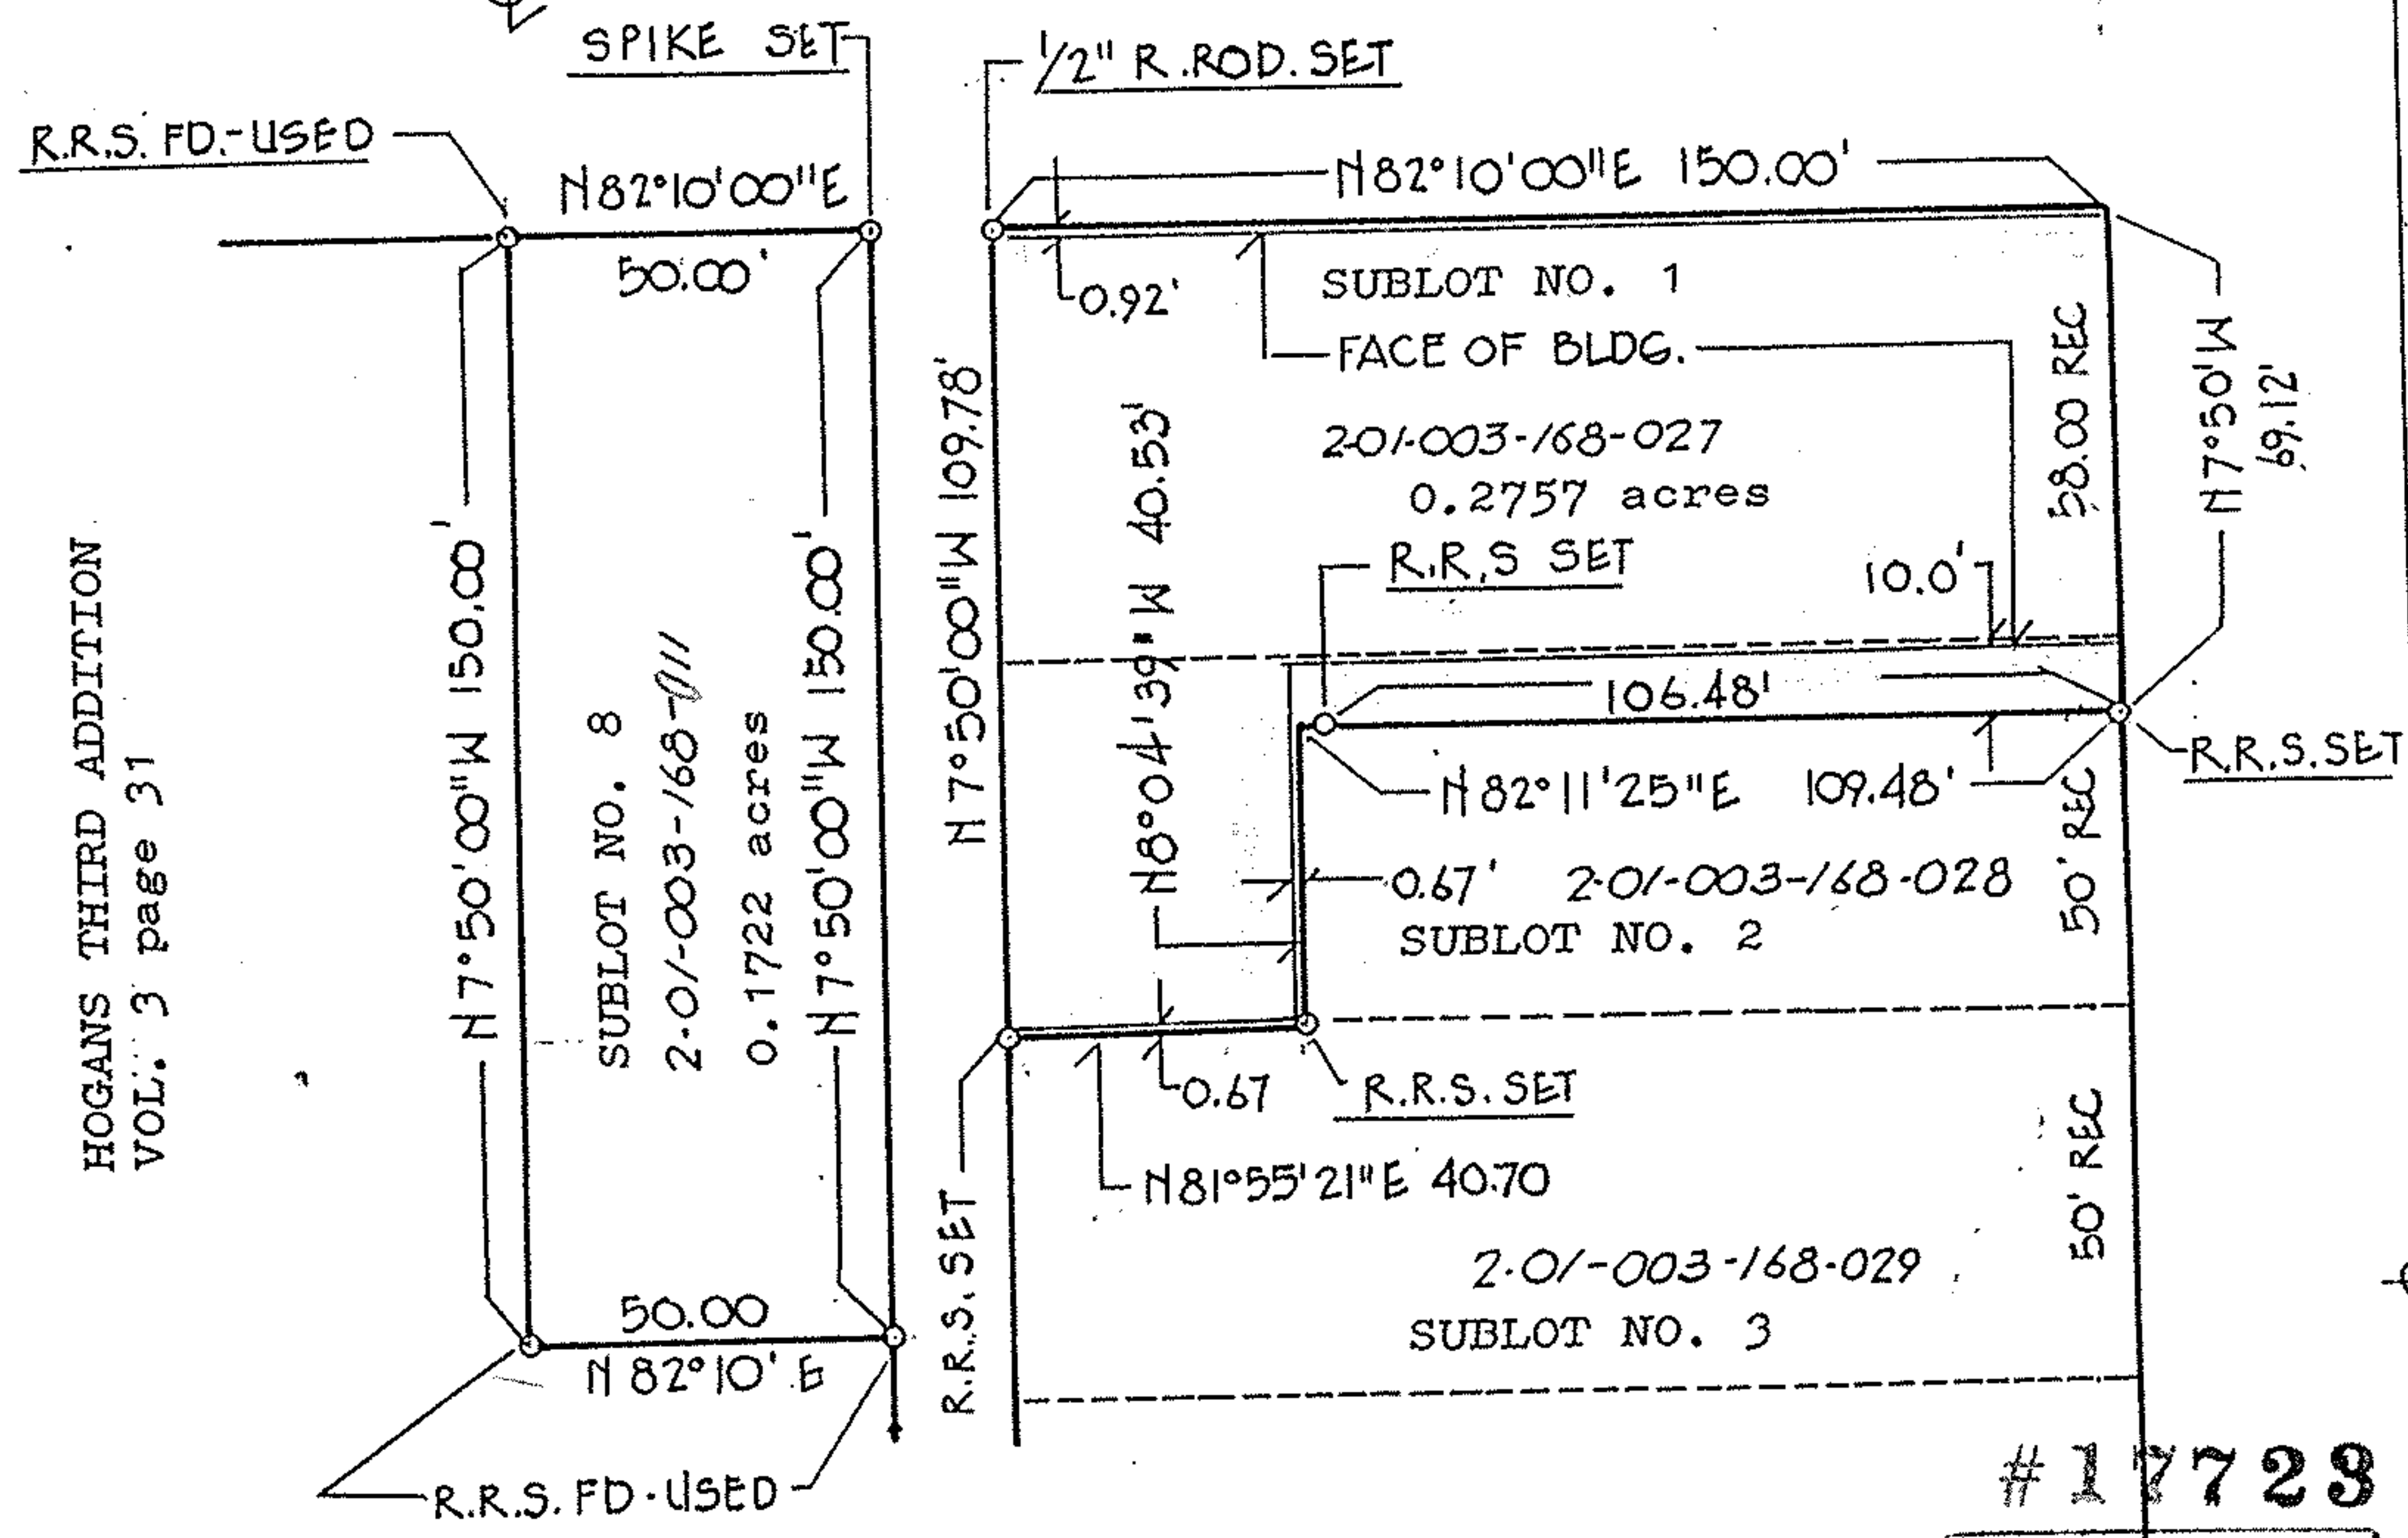

HOGANS THIRD ADDITION  
VOL. 3 page 31

FOR DETAILS OF LOT SPLITS, SEE SHEET 2 OF 2

**APPROVED**  
AS TO DESCRIPTION ONLY  
Date 10-9-87  
City of Lorain  
Per *Lawell G. Kneissel*  
Engineering Dept.

**BROADWAY**  
APPROVED BY THE LORAIN CITY PLANNING COMMISSION  
COMMISSIONERS: *[Signatures]*  
NO PLAN REQUIRED  
SECRETARY LORAIN CITY PLANNING COMMISSION

#17723

APPROVED  
LORAIN CO.  
MAP DEPT.

DATE 10-19-87  
PAGE 2-01-003-H  
BY *Carol Francis*  
VOID AFTER