

2-01-003-4, N-108-A, 113-A \*17507 02-01-003-262-041

AND SURVEY FOR ROBERT VIOROG  
CITY OF LORAIN -  
LORAIN COUNTY -  
OHIO

PART OF ORIGINAL BLACK  
RIVER LOT No.3 TRACT No.1

MONUMENTS WERE FOUND OR  
SET AS SHOWN. DISTANCES ARE  
IN FEET AND DECIMALS. BEARINGS  
ARE FOR ANGLE CALCULATIONS  
ONLY. ALL OF WHICH WE  
CERTIFY TO BE CORRECT.

Vincent C. McDervey


PROFESSIONAL ENGINEER &  
SURVEYOR NO. 4289.

2643 JOSEPH ST.  
AVON, OHIO 44011 937-5353

SCALE: 1" = 50'

MAY 1986

REVISED  
AUGUST 1986  
TO SHOW PARCELS  
A & B

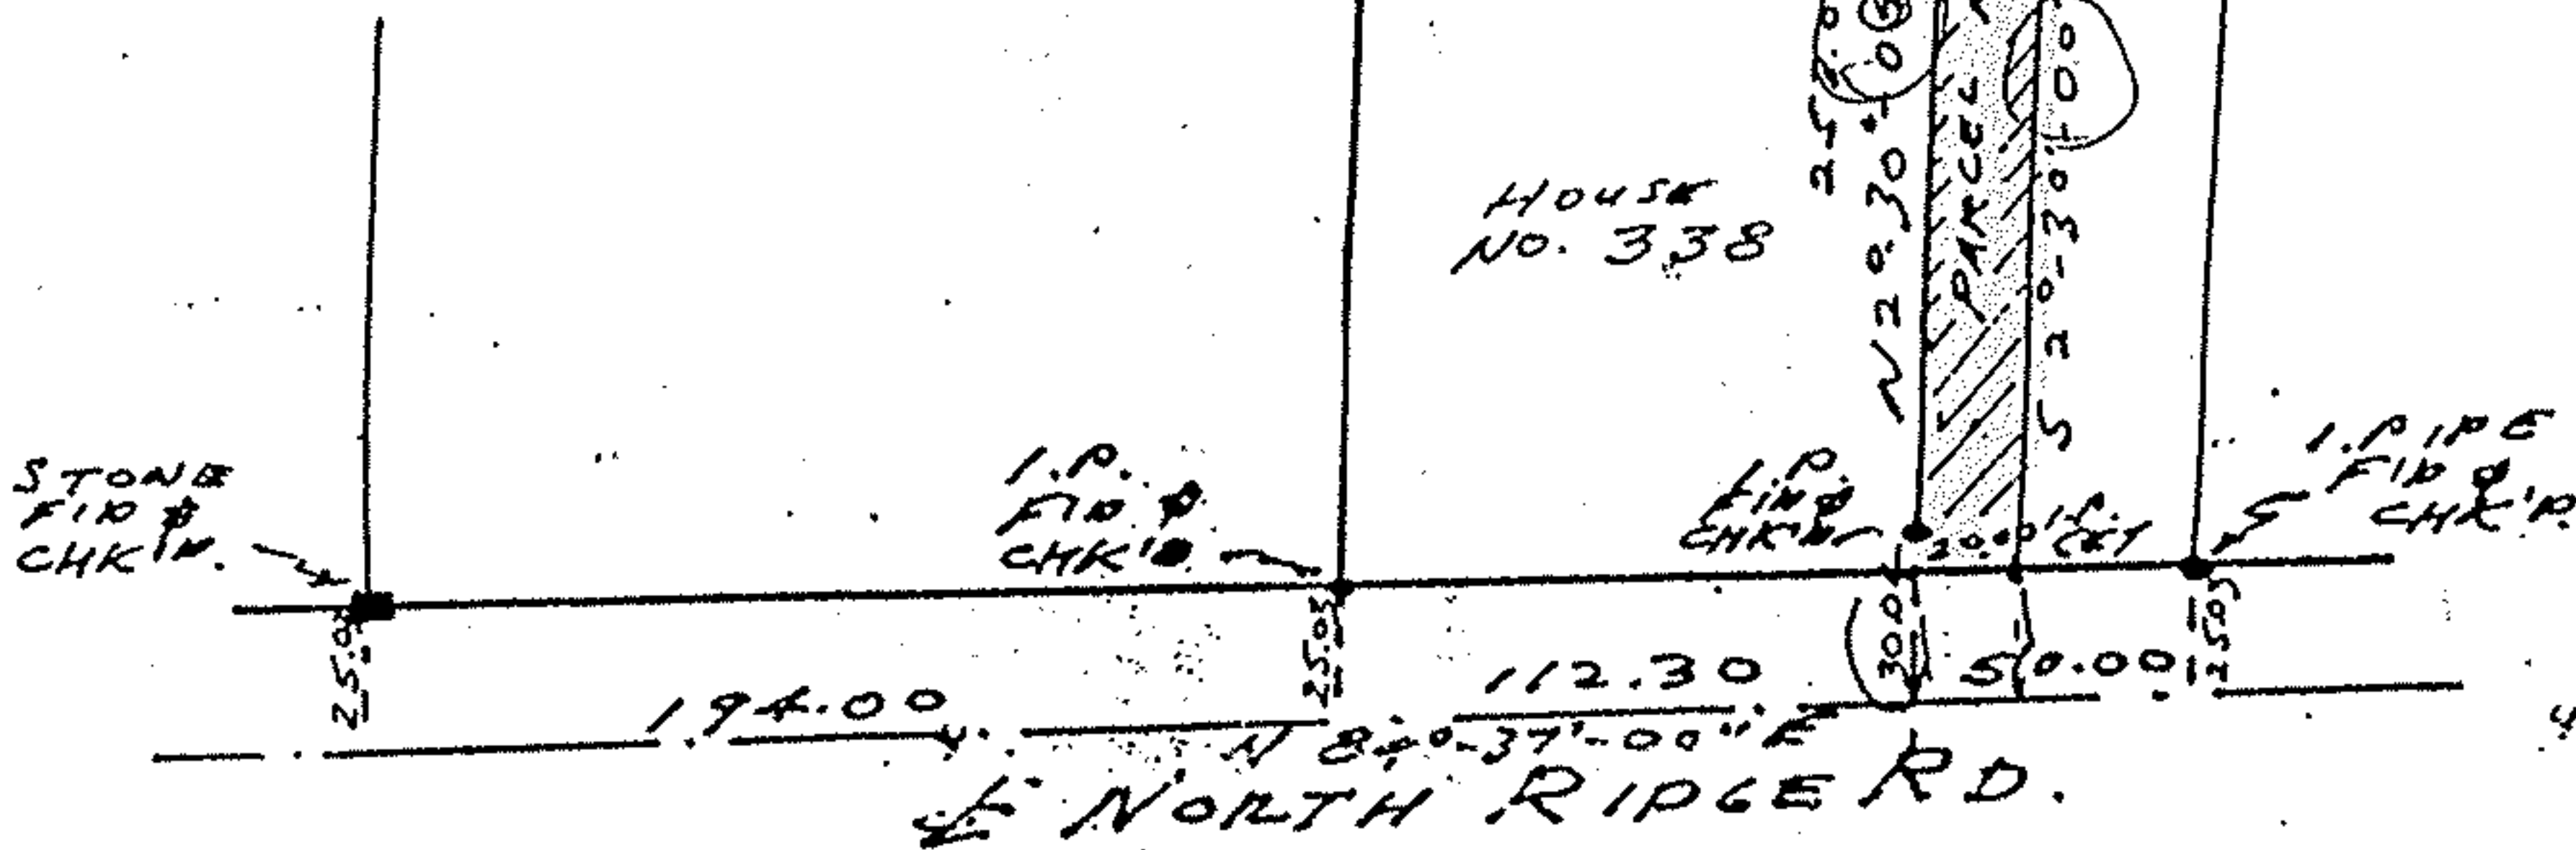

#17507  
APPROVED  
LORAIN CO.  
MAP DEPT.  
DATE 7-1-87  
2-01-003-4, N  
PAGE 3-00-108-A-113-A  
BY C. FRANKS  
VOID AFTER 17507

APPROVED  
AS TO DESCRIPTION ONLY

Date 6-23-87  
City of Lorain  
Per J. Kneisel  
Engineering Dept.

APPROVED BY THE LORAIN CITY PLANNING  
COMMISSION 6-24-87  
NO PLAT REQUIRED

Secretary Lorain City Planning Commission