




LAUNDON • SIMON • CAHL and ASSOC.
ENGINEERS
504 MIDDLE AVE.

SURVEYORS
ELYRIA, OHIO 4035

FOR: ALLAN W. BOROSKI

02-01-006-106-018

TOWNSHIP BLACK RIVER	VILLAGE	DATE FEB. 27, 1980
ORIG. LOT or SEC.	COUNTY LORAIN	SCALE 1"=30'
CITY LORAIN	STATE OHIO	JOB NO. 80950 F.B. NONE

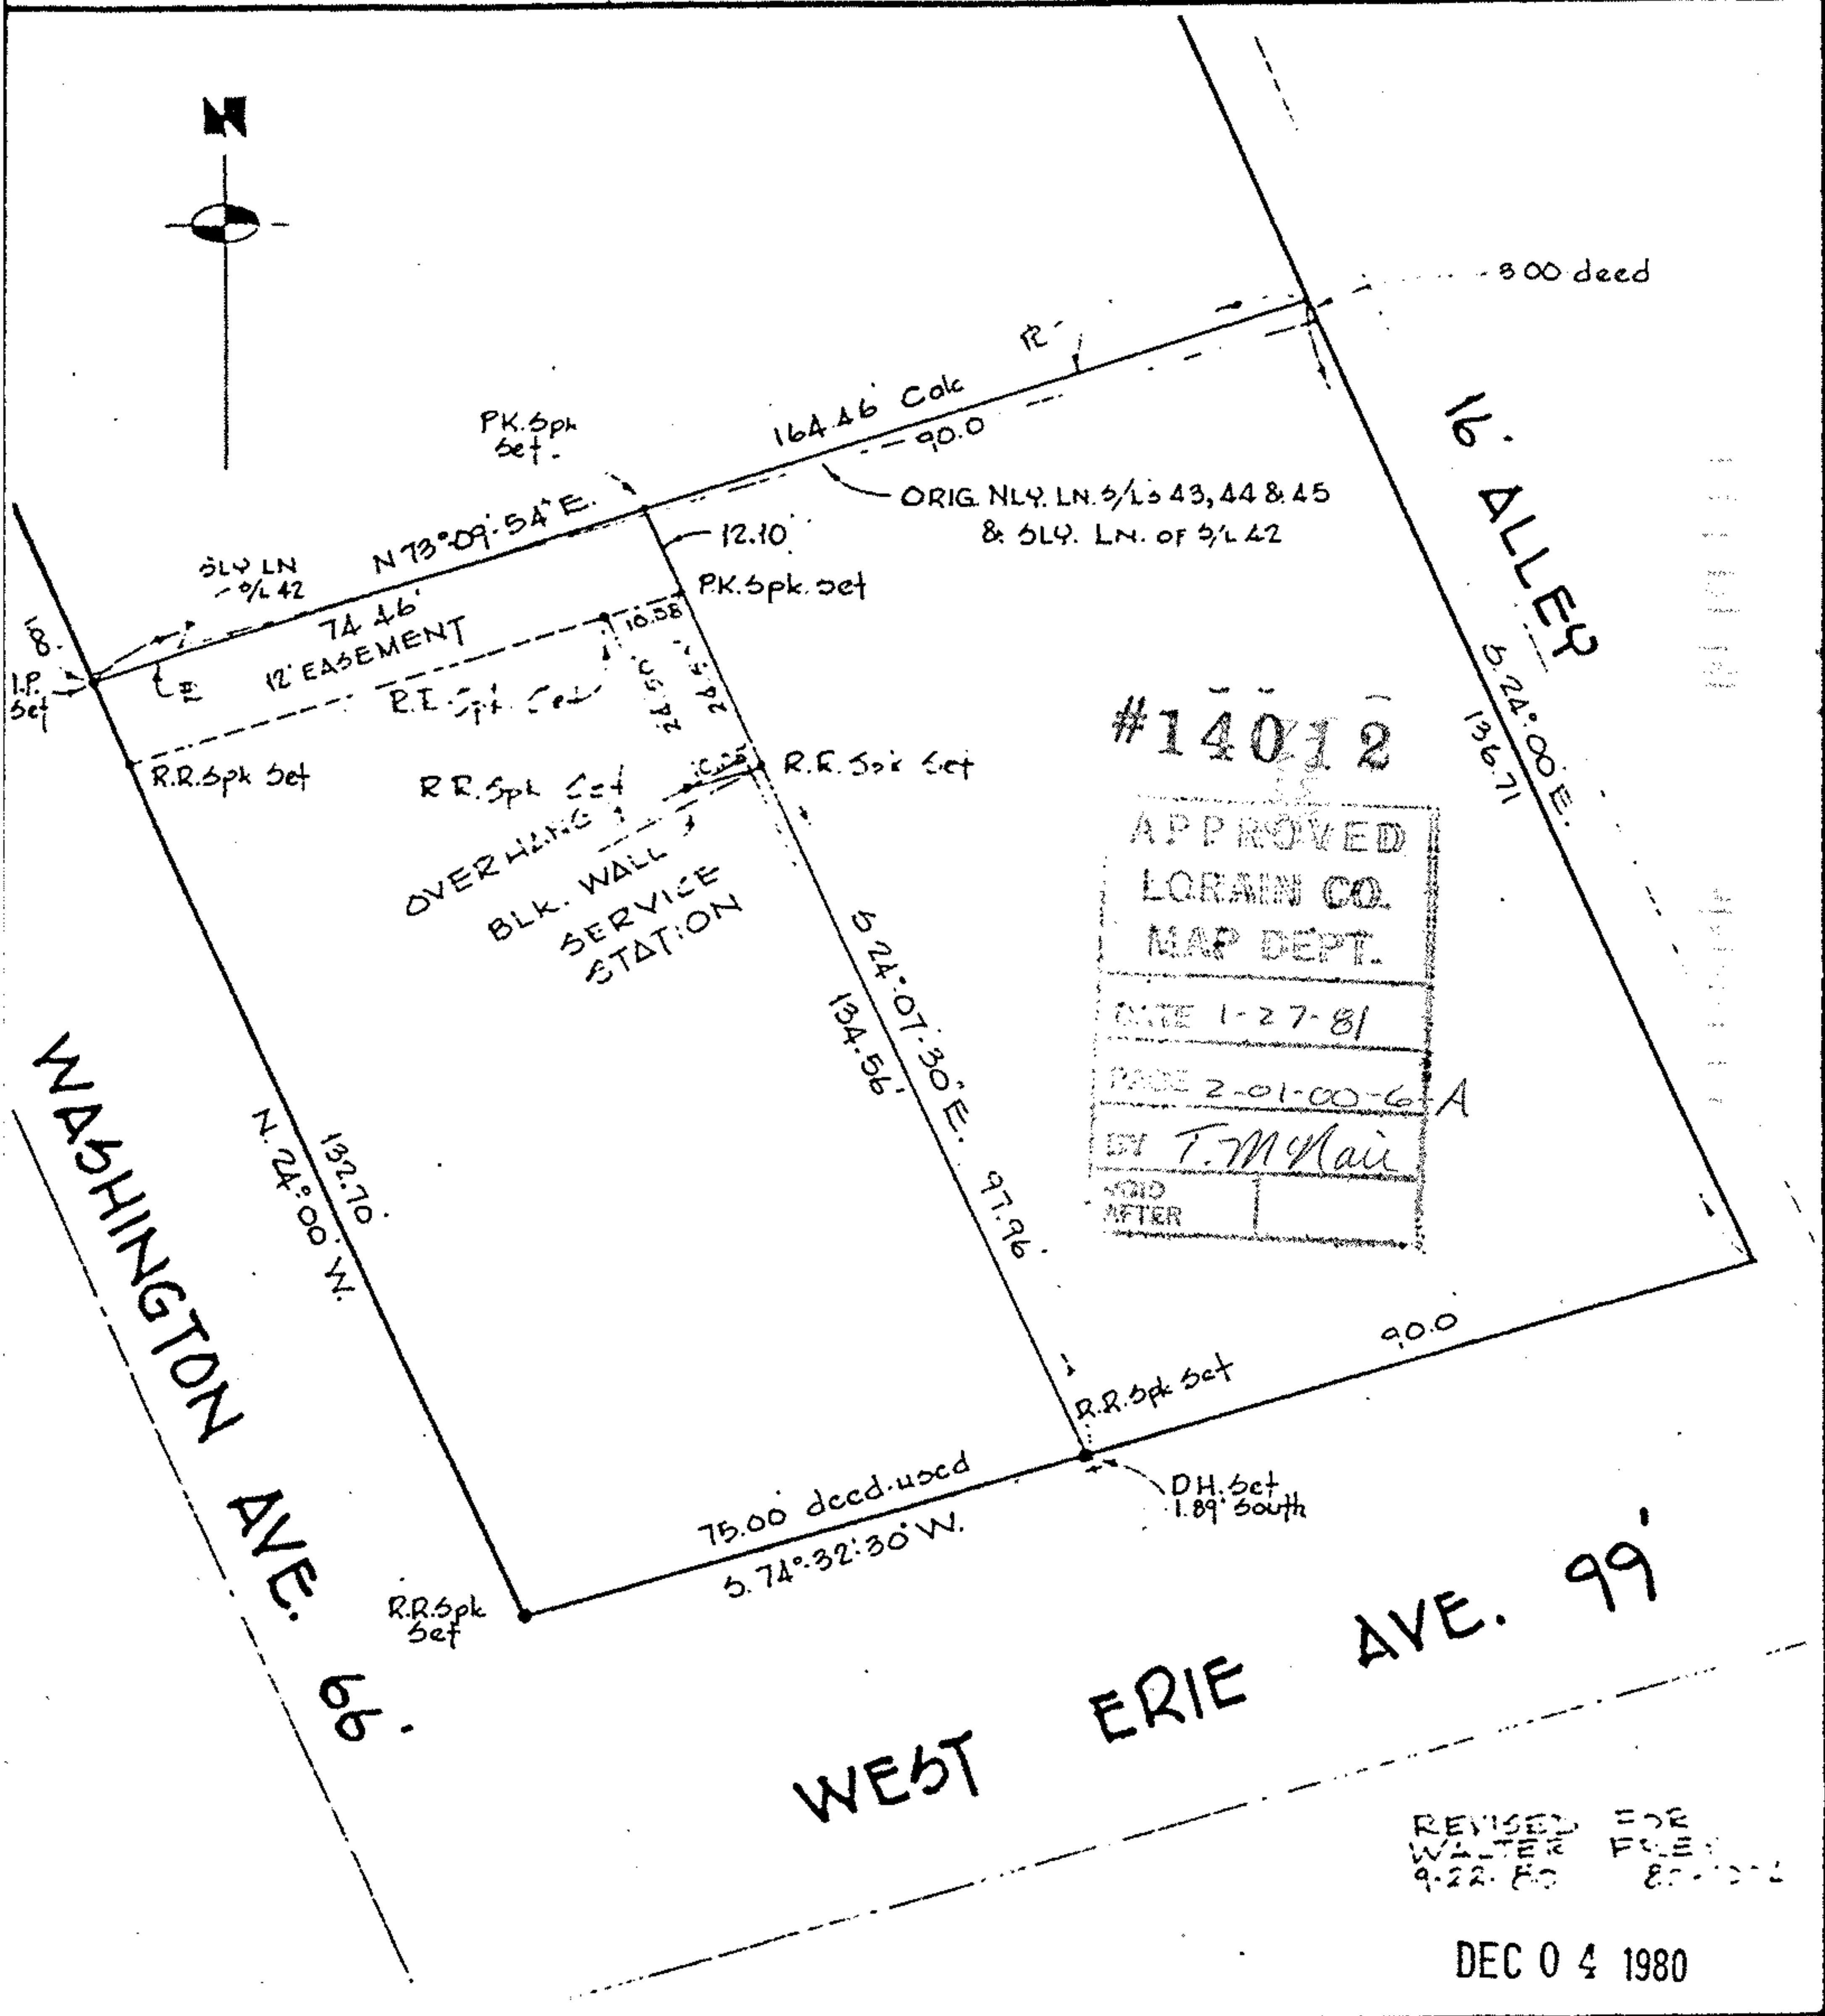

REVISED FOR FILE
WALTER FOLEY
9-22-80 85-10-1

DEC 04 1980