

U.S.A.


MAP

02-01-008-101-364,365,123

MAP OF SURVEY OF LAND
 FOR BUD GARFIELD
 BLACK RIVER TWP. - TRACT 1 S.E. 83
 CITY OF LORAIN
 JOHN R. HAMILTON - REG. SURV. #6861
 MAY 1988 SCALE 1"=100'

NORTH
 SCALE 1"=100'

OBERLIN AVE.

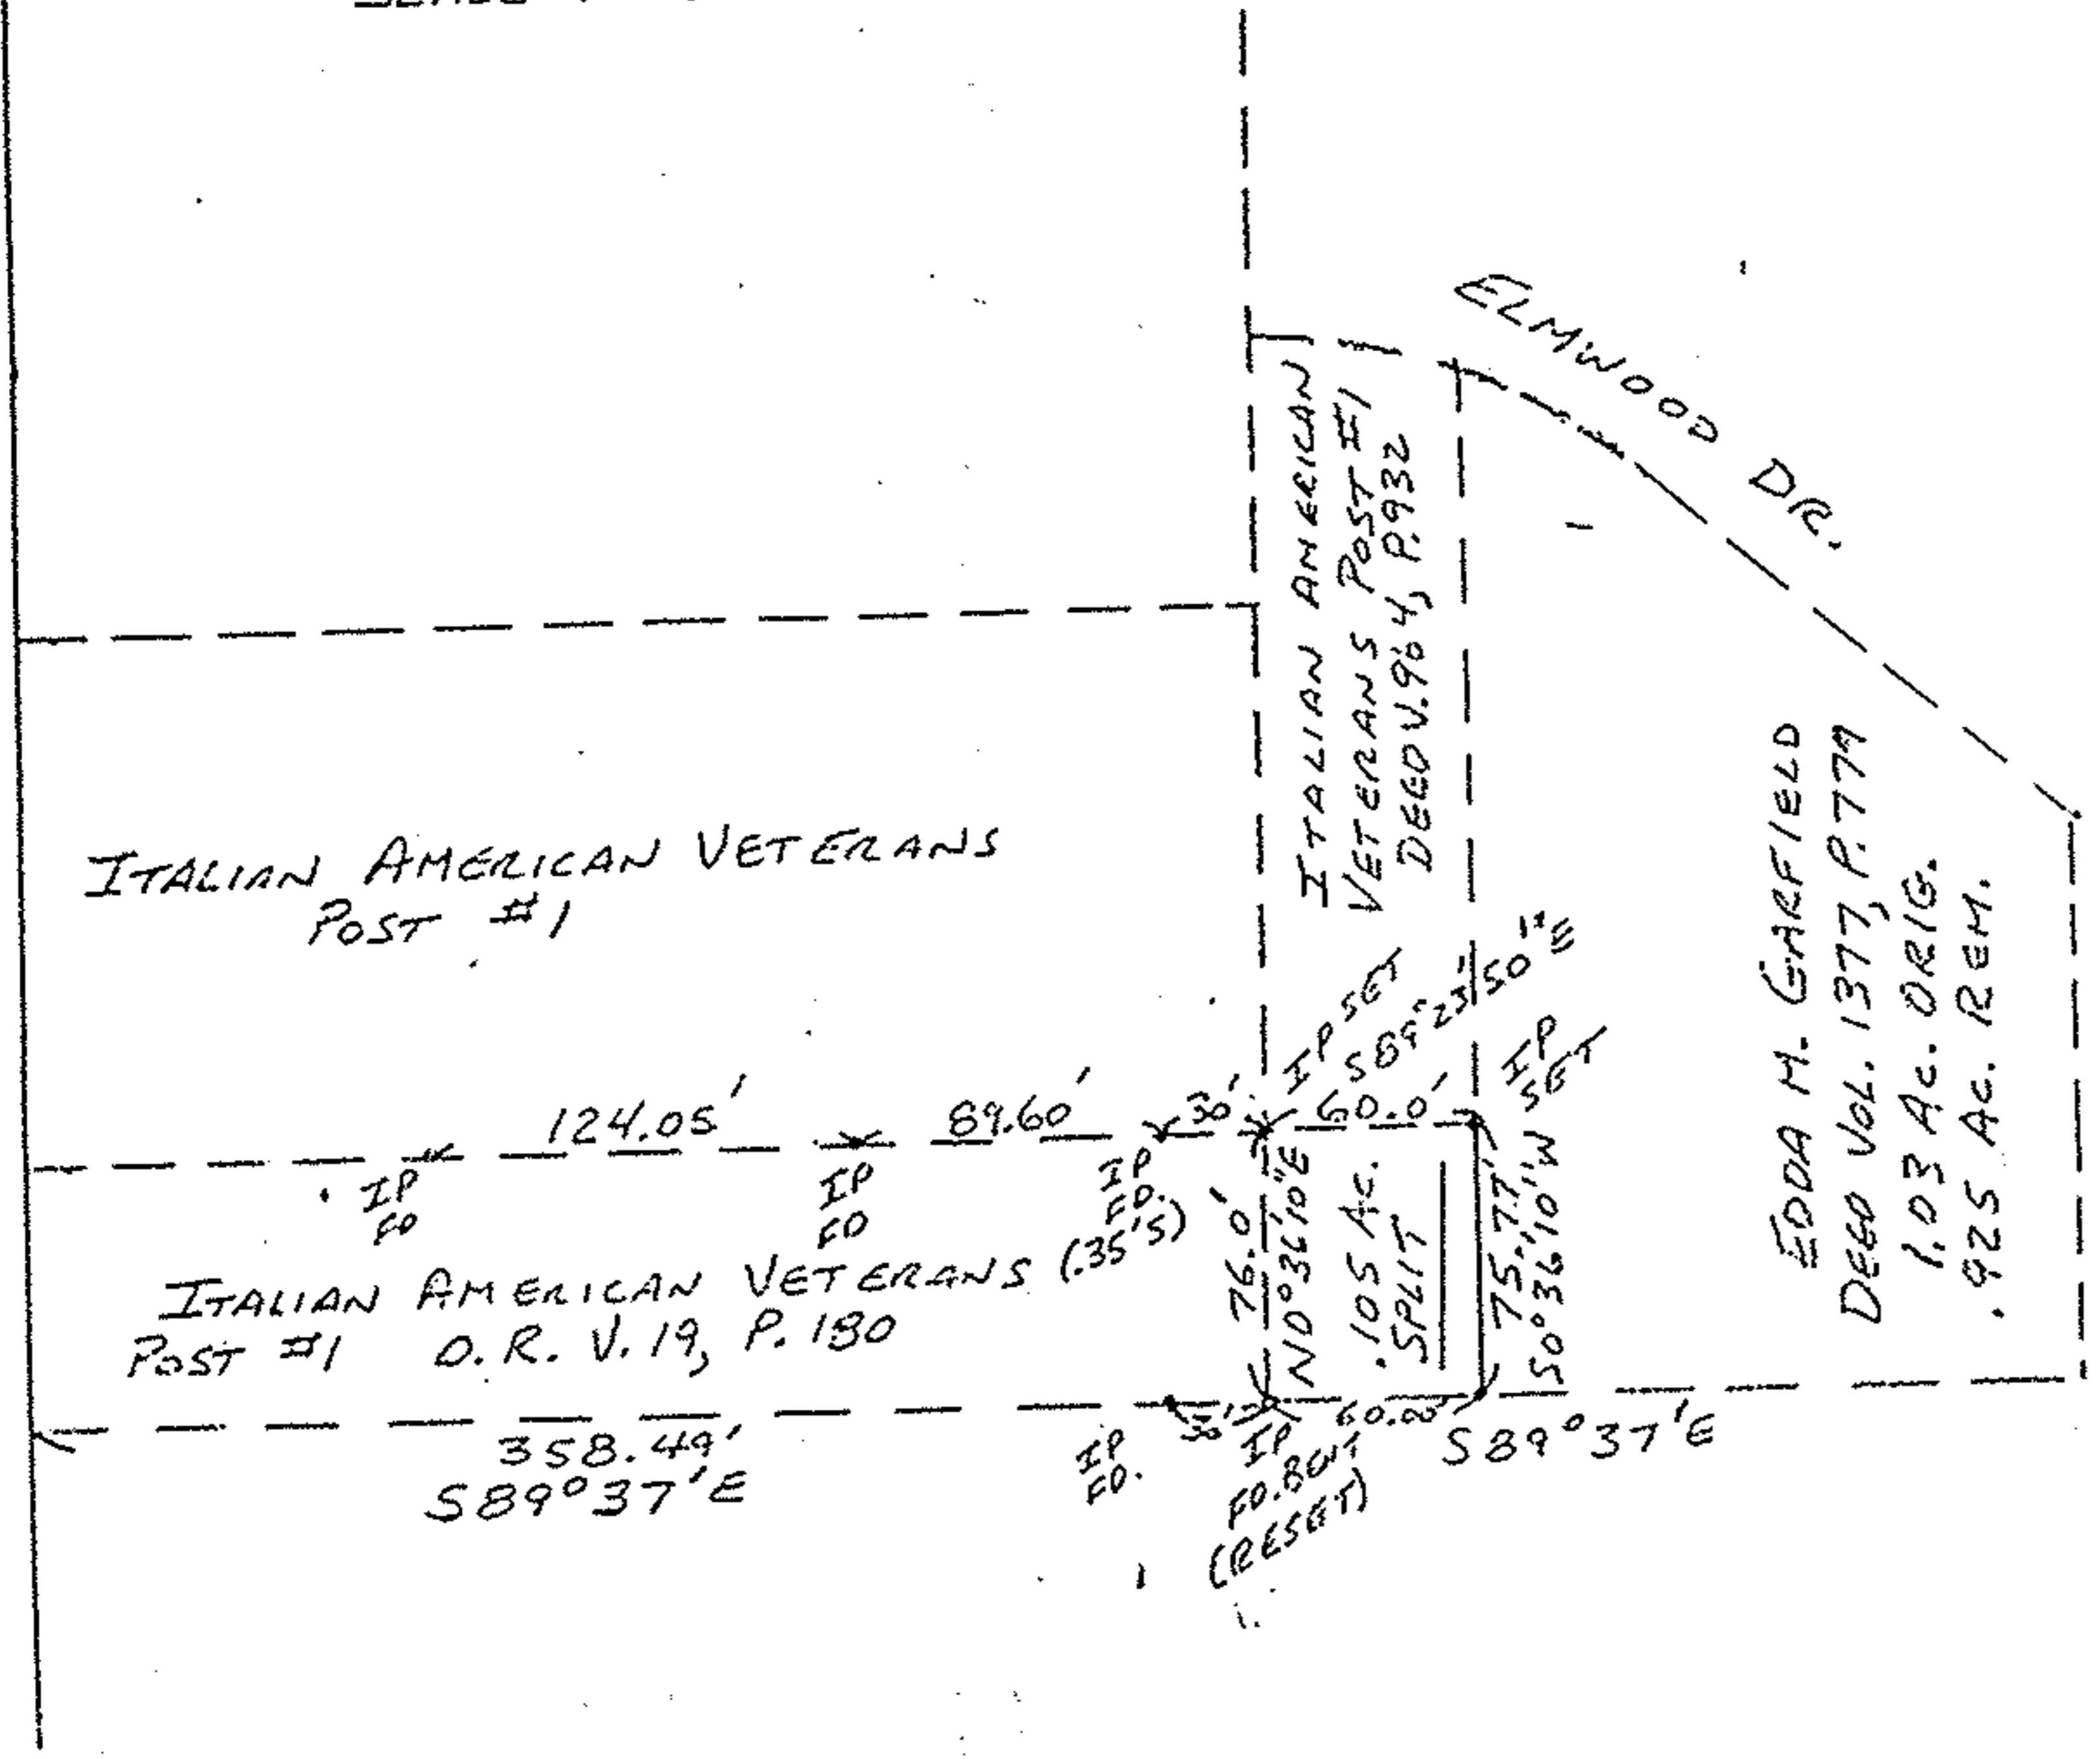

2692

APPROVED

AS TO DESCRIPTION ONLY

Date 16 June - 1988
 City of Lorain
 Per Patrick M. Gannon
 Engineering Dept.

#17994


APPROVED
 LORAIN CO.
 MAP DEPT.

DATE 6-20-88

PAGE 2-01-008-A

BY Carol Harris

VOID AFTER 6/17/99

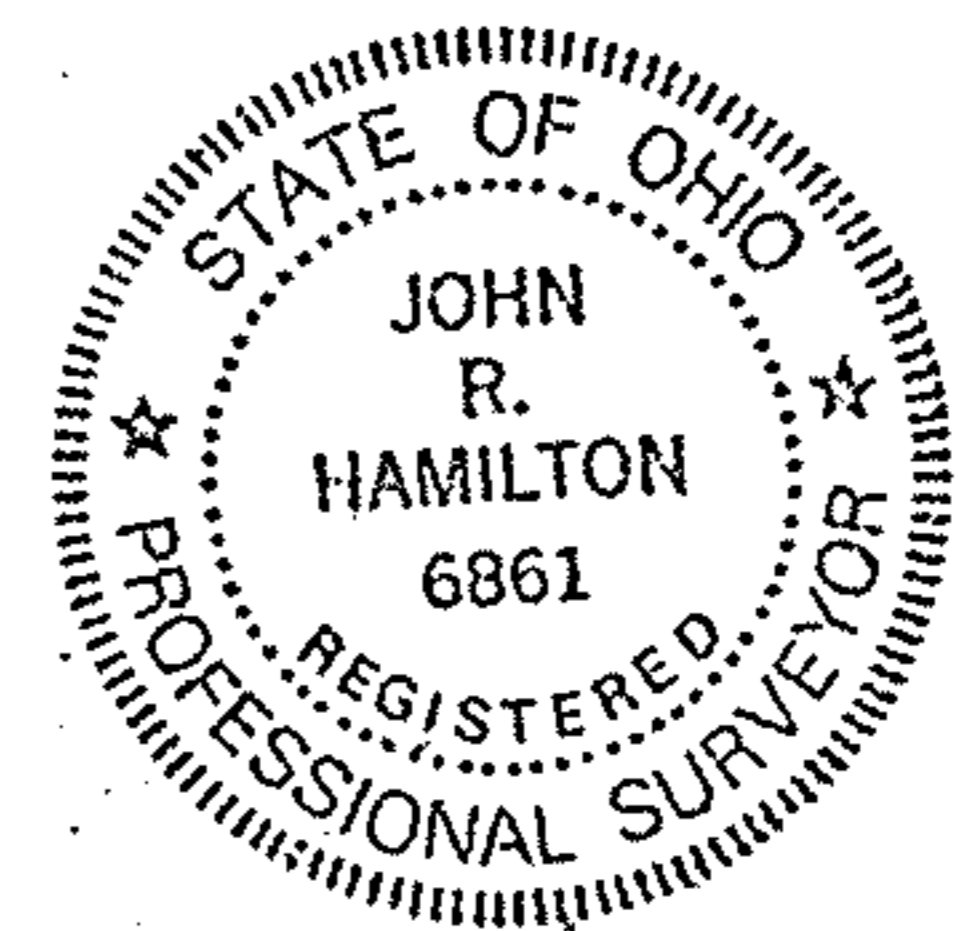

02-01-008-101-