


Map of Part of Lot 8 Tract 1 Black River Twp. Lorain City County of Lorain  
 Scale 1" = 100' July 6, 1979 By Arnold F. Koepp Reg. Surveyor No. 4396  
 revised Aug. 2, 1979

02-01-008-102-023  
 -025  
 -024

#13113  
 #13114

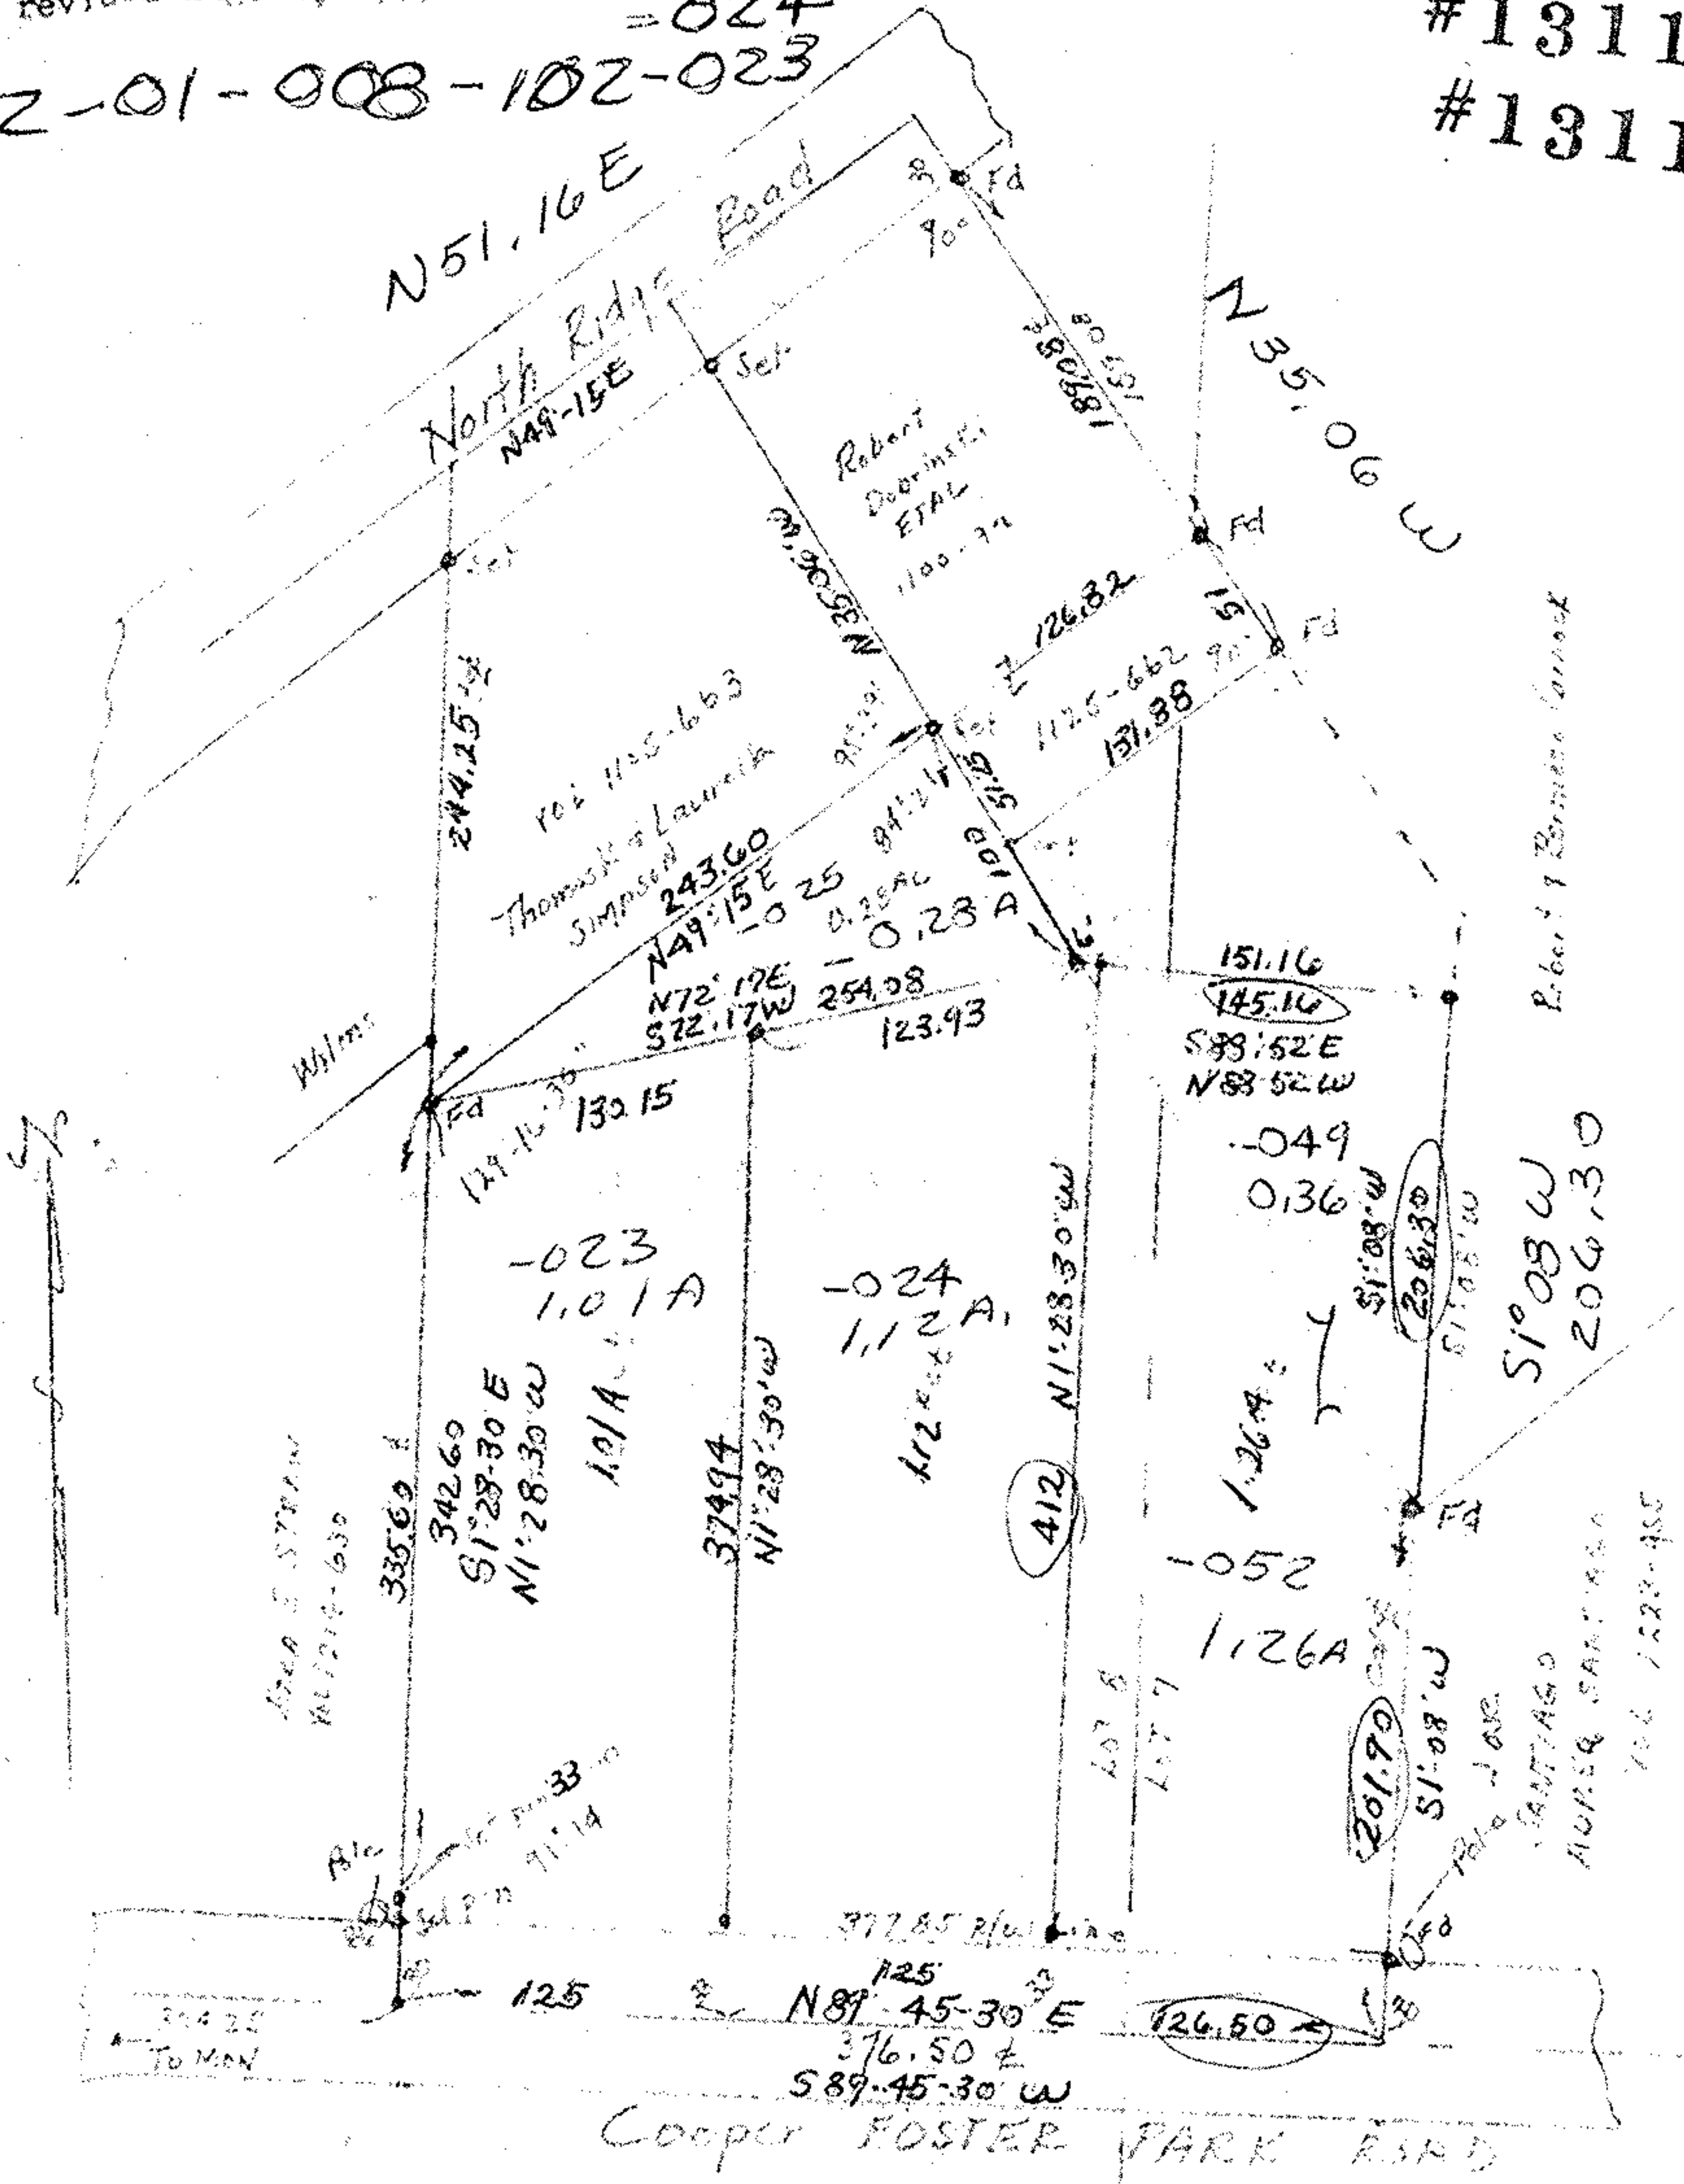

47/8

TO MAN

COOPER FOSTER PARK ROAD

TO MAN