


APPROVED	DATE 12/30/04
LORAIN CO.	PAGE 11-00-093-A
MAP DEPT	BY D. Mosley
	#04-01089-A

Survey Map  
 Eaton Township ~ Lorain County ~ State of Ohio  
 Part of Original Eaton Township Lot 93  
 P.P.N. 11-00-093-102-064  
 Deed Vol. 565 Pg. 427

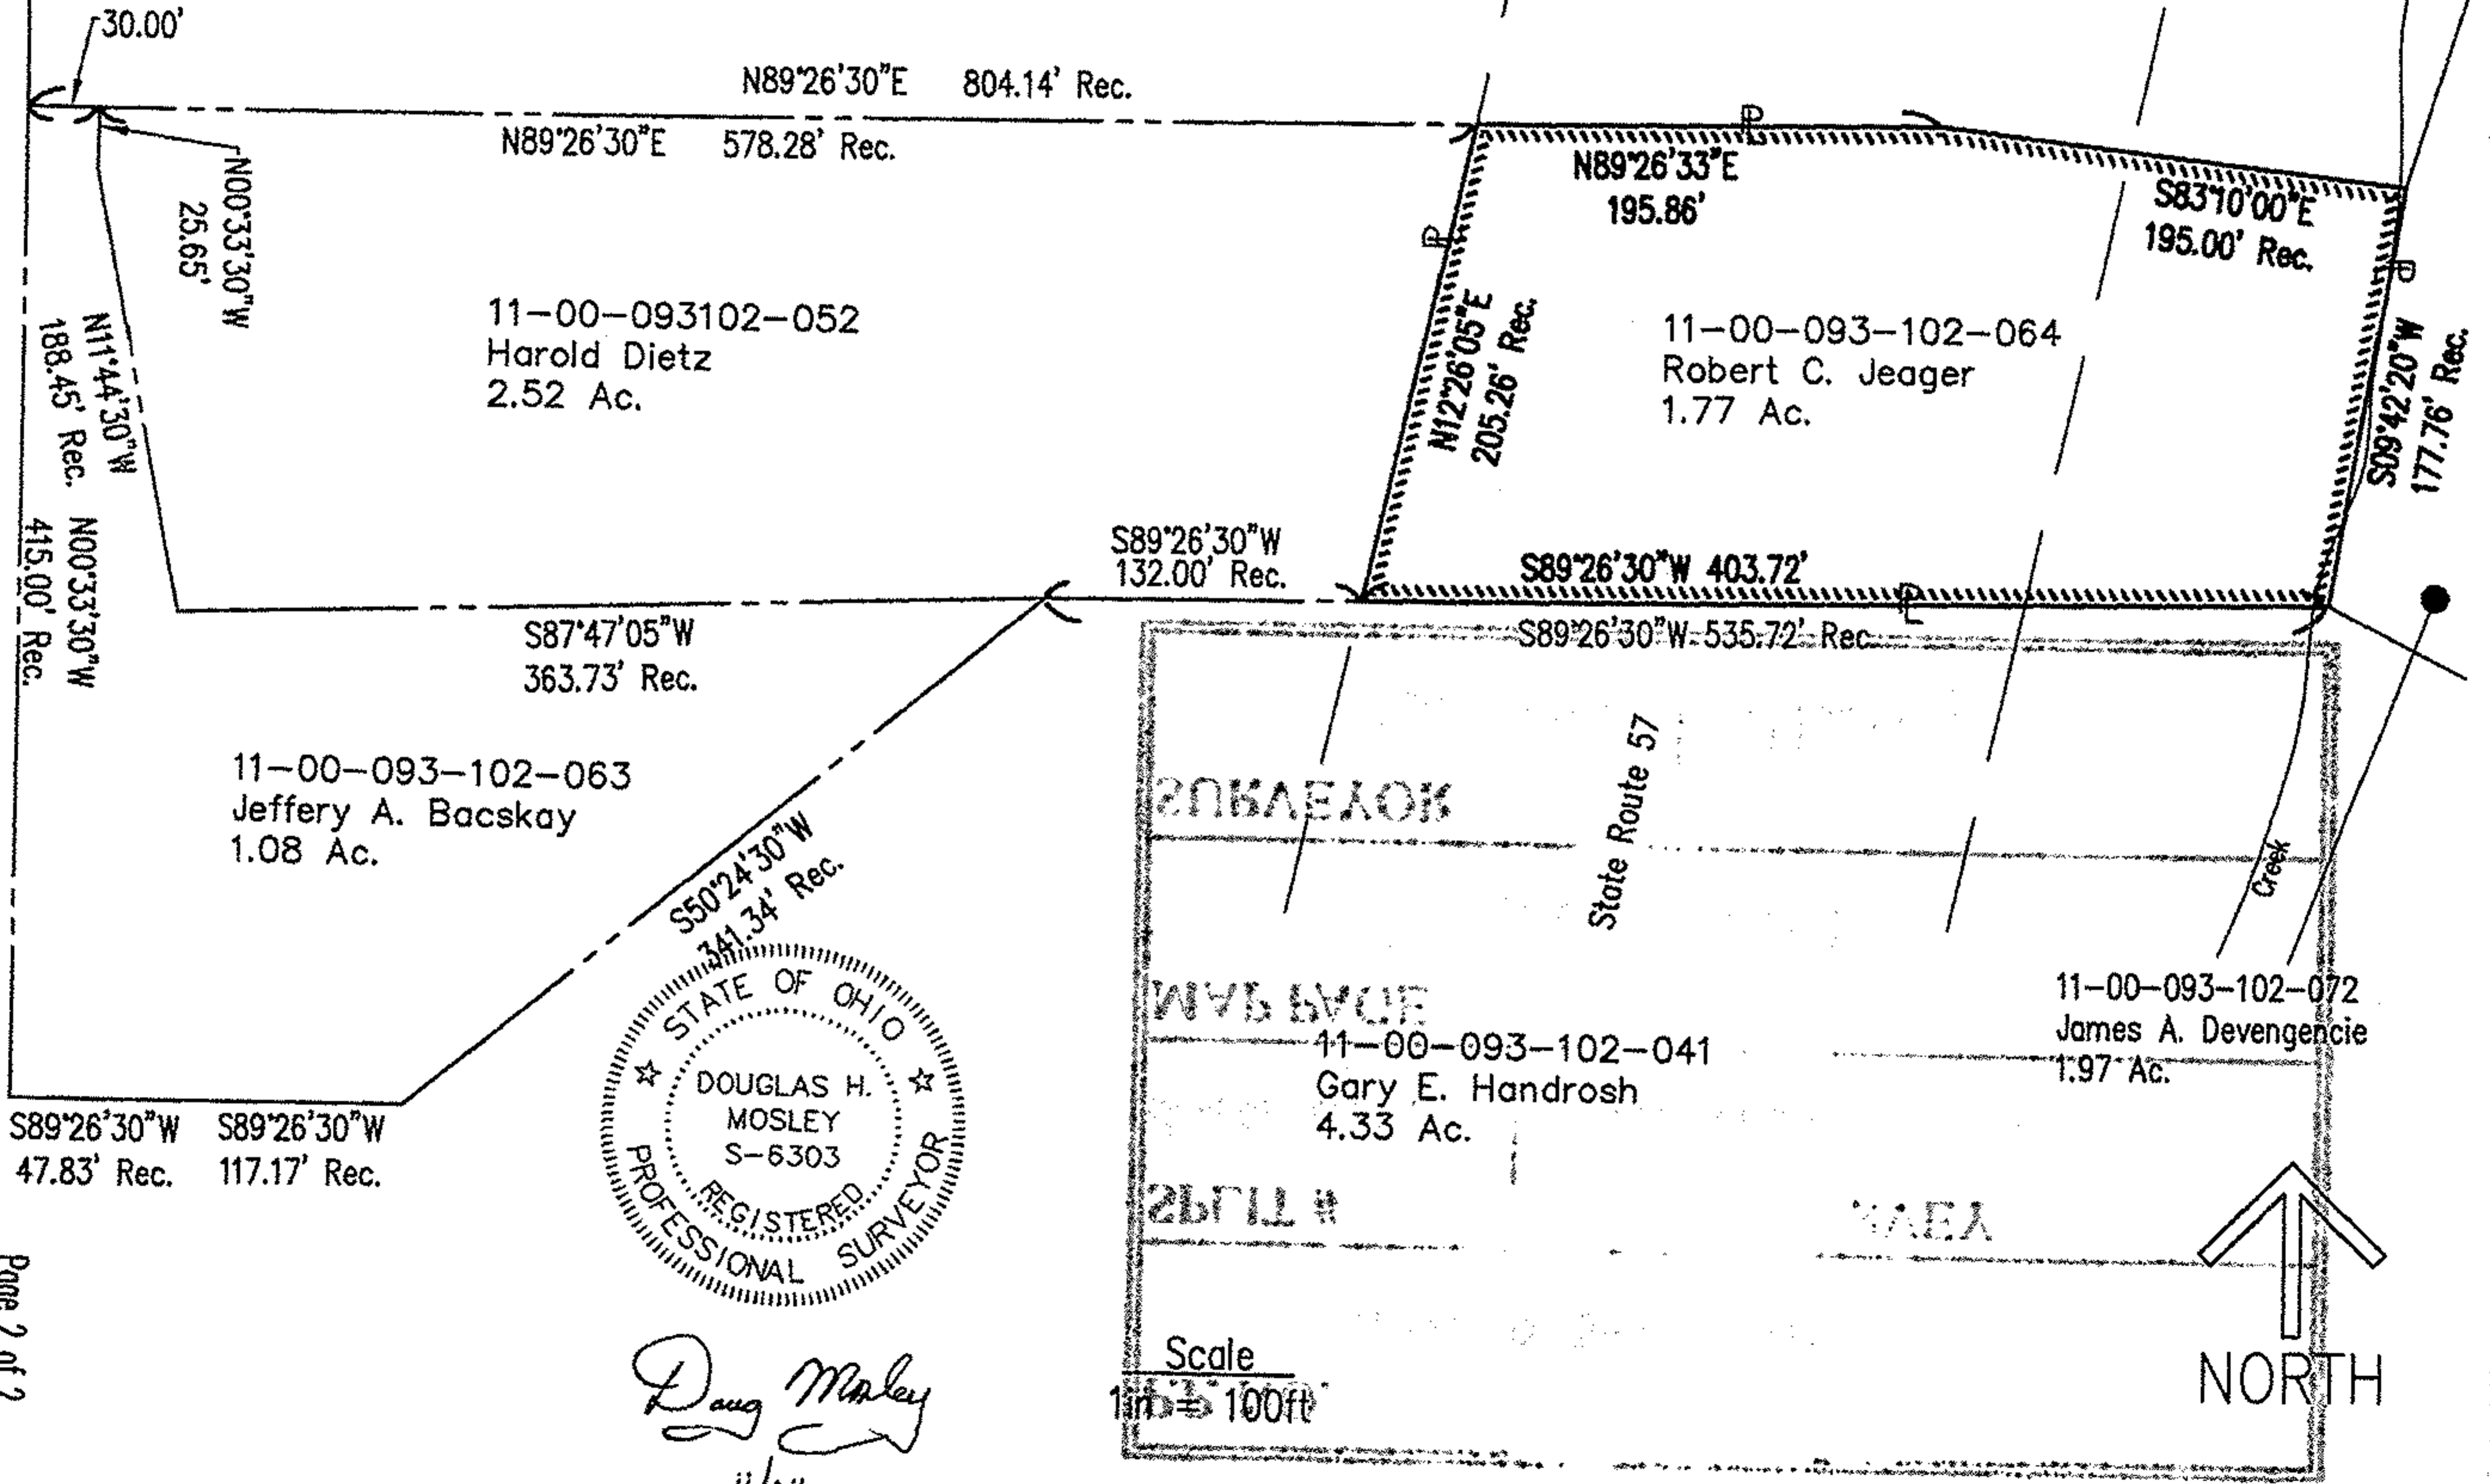

*Doug Mosley*  
 11/04